

SHEET LIST Current Revision Revision Date **Sheet Name** Sheet Number DA-0000 COVER 16.10.25 LOCATION PLAN DA-0010 25.09.25 SITE PLAN - EXISTING DA-0100 25.09.25 DA-0101 SITE ANALYSIS 25.09.25 DA-0201 DEMOLITION PLAN - GROUND FLOOR 16.10.25 DA-0202 **DEMOLITION PLAN - TYPICAL** 25.09.25 DA-0203 **DEMOLITION PLAN - ROOF** 25.09.25 DA-0241 DEMOLITION ELEVATION - NORTH EAST 16.10.25 DA-0242 **DEMOLITION ELEVATION - NORTH WEST** 16.10.25 PROPOSED EXCAVATION DIAGRAM DA-0251 25.09.25 DA-1001 FLOOR PLAN - BASEMENT 02 10.10.25 FLOOR PLAN - BASEMENT 01 DA-1002 10.10.25 FLOOR PLAN - LEVEL 00 DA-1003 16.10.25 DA-1004 FLOOR PLAN - LEVEL 01 25.09.25 DA-1005 FLOOR PLAN - LEVEL 02 25.09.25 DA-1006 FLOOR PLAN - LEVEL 03 10.10.25 DA-1010 FLOOR PLAN - ROOF 25.09.25 DA-1401 **ELEVATIONS - NORTH EAST** 25.09.25 DA-1402 **ELEVATIONS - NORTH WEST** 16.10.25 **ELEVATIONS - SOUTH WEST** DA-1403 16.10.25 **ELEVATIONS - SOUTH EAST** 25.09.25 DA-1415 STREETSCAPE ELEVATIONS 25.09.25 DA-1501 BUILDING SECTION A 13.10.25 **BUILDING SECTION B** DA-1502 13.10.25 DA-1503 BUILDING SECTION C 25.09.25 DA-1504 BUILDING SECTION D 25.09.25 **BUILDING SECTION E** DA-1505 25.09.25 **BUILDING SECTION F** DA-1506 25.09.25 DA-4051 ADAPTABLE APARTMENT PLAN B1.02 25.09.25 DA-4052 ADAPTABLE APARTMENT PLAN B0.02 10.10.25 DA-8101 COMPLIANCE DRAWINGS - SOLAR AND CROSS 25.09.25 **VENTILATION** DA-8301 COMPLIANCE DRAWINGS - SHADOW DIAGRAMS 25.09.25 COMPLIANCE DRAWINGS - SHADOW DIAGRAMS DA-8302 25.09.25 DA-8403 COMPLIANCE DRAWINGS - EYE OF THE SUN -25.09.25 PROPOSED DA-8404 COMPLIANCE DRAWINGS - EYE OF THE SUN -25.09.25 PROPOSED COMPLIANCE DRAWINGS - HEIGHT PLANE -DA-8501 25.09.25 PROPOSED - 17.5m AS-BUILT COMPLIANCE DRAWINGS - DCP + 17.5M COMPLIANT DA-8502 25.09.25 ENVELOPE - PROPOSED STORAGE DIAGRAM 10.10.25 AREA PLANS - GFA DA-8601 10.10.25 DA-8602 AREA PLANS - SITE COVERAGE AND LANDSCAPE 25.09.25 MONTAGE - CARABELLA ST VIEW DA-8701 25.09.25 DA-8703 MONTAGE - PEEL ST VIEW 25.09.25 DA-8705 MATERIAL SCHEDULE 25.09.25 NOTIFICATION SHEET DA-9001 25.09.25 Grand total: 44

Æ BASIX COMMITMENTS **UPDATED IN LINE** WITH REPORT

NATHERS THERMAL COMFORT INCLUSIONS

GLAZING DOORS / WINDOWS	
	U-VALUE: 5.40 (EQUAL TO OR LOWER THAN) SHGC: 0.58 (±5%)
	<u>UPGRADE APPLIED AS PER THERMAL COMFORT UPGRADES TABLE:</u>
	GLAZING UPGRADE 1
	GROUP B – FIXED WINDOWS + SLIDING DOORS/WINDOWS + LOUVRED
	WINDOWS + DOUBLE HUNG
	U-VALUE: 4.80 (EQUAL TO OR LOWER THAN) SHGC: 0.59 (±5%)
	GLAZING UPGRADE 2
	GROUP B – FIXED WINDOWS + SLIDING DOORS/WINDOWS + DOUBLE HUNG
	U-VALUE: 3.4 (EQUAL TO OR LOWER THAN) SHGC: 0.53 (±5%)
	GLAZING UPGRADE 3
	GROUP B – FIXED WINDOWS + SLIDING DOORS/WINDOWS + DOUBLE HUNG

U-VALUE: 3.4 (EQUAL TO OR LOWER THAN) SHGC: 0.40 (±5%) GIVEN VALUES ARE AFRC TOTAL WINDOW SYSTEM VALUES (GLASS AND

WINDOW RESTRICTORS ARE MODELLED IN BEDROOMS TO ALL WINDOWS

WITH A SILL HEIGHT UNDER 1.7M AND A FALL HEIGHT OVER 2M FROM THE

NOTE: BASIX THERMAL COMFORT PROTOCOL TABLE 1 SHGC VALUE OF THE UNIT SHOULD BE WITHIN THE RANGE SPECIFIED ON THE ASSESSOR CERTIFICATE.

FLOOR LEVEL OF THE ROOM.

ROOF & CEILING TERRACOTTA TILED ROOF CONCRETE ROOF, NO INSULATION ABOVE

THERMAL BREAK APPLIED AS PER NCC 2022 REQUIREMENTS.

WINDOW FRAME COLOUR

WINDOW RESTRICTORS

PLASTERBOARD CEILING WITH R1.5 INSULATION (INSULATION ONLY VALUE) WHERE BALCONIES ARE ABOVE PLASTERBOARD CEILING WITH R4.0 INSULATION (INSULATION ONLY VALUE) TO SOFFIT OF CONCRETE WHERE ROOF IS OVER PLASTERBOARD CEILING WITH R5.0 INSULATION (INSULATION ONLY VALUE) TO SOFFIT OF CONCRETE WHERE ROOF IS OVER (BUILDING A, UNIT 302). PLASTERBOARD CEILING, NO INSULATION WHERE NEIGHBOURING UNITS

EXTERNAL COLOUR

CONCRETE (SA 0.62) TERRACOTA (SA 0.61)

DEFAULT COLOUR MODELLED

CEILING PENETRATIONS SEALED LED DOWNLIGHTS AT A MAXIMUM OF ONE EVERY 5M. ONCE LIGHTING PLAN HAS BEEN DEVELOPED NATHERS CERTIFICATE CAN BE UPDATED TO IMPROVE SPECIFICATION.

BRICK VENEER (METAL) STUD WALL WITH R2.5 INSULATION (INSULATION ONLY VALUE) LIGHTWEIGHT (FC OR METAL) CLADDING (METAL) STUD WALL WITH R2.5

INSULATION (INSULATION ONLY VALUE) ANY CONCRÈTE COLUMNS WITHIN THE EXTERNAL WALL ENVELOPE ARE ASSUMED TO HAVE THE SAME R2.5 INSULATION DOUBLE BRICK WALL (EXISTING TO BE RETAINED), NO INSULATION

THERMAL BREAK APPLIED AS PER NCC 2022 REQUIREMENTS.

EXTERNAL COLOUR BRICK SA 0.65

DEFAULT COLOUR FOR CLADDINGS

INTER-TENANCY WALLS

DOUBLE STUD WALLS ADJACENT TO NEIGHBOURS. NO INSULATION DOUBLE STUD WALLS ADJACENT TO HALLWAYS WITH A MINIMUM R1.0

INSULATION (INSULATION ONLY VALUE) MINIMUM 150MM CONCRETE WITH FURRING CHANNEL AND PLASTERBOARD LINING TO ALL WALLS ADJACENT TO LIFT SHAFTS AND FIRE STAIRS. NO INSULATION REQUIRED

WALLS WITHIN DWELLINGS PLASTERBOARD ON STUDS - NO INSULATION

CONCRETE WITH A MINIMUM R1.5 SUBFLOOR INSULATION (INSULATION ONLY VALUE) REQUIRED TO UNITS WITH GARAGE BELOW CONCRETE WITH A MINIMUM R0.9 SUBFLOOR INSULATION (INSULATION ONLY VALUE) REQUIRED WHERE PART OPEN SUBFLOOR IS BELOW CONCRETE BETWEEN LEVELS, NO INSULATION REQUIRED

FLOOR INSULATION UPGRADE

CONCRETE WITH A MINIMUM R2.00 SUBFLOOR INSULATION (INSULATION ONLY VALUE) REQUIRED TO UNITS A0.02, AND A0.03 WITH GARAGE BELOW.

FLOOR COVERINGS

16.10.25 BASIX & STORMWATER UPDATE

EXTERNAL SHADING

SHADING AS PER STAMPED DOCUMENTATION

CARPET TO BEDROOMS AND TILES ELSEWHERE



PURPOSES AFTER THE GRANT OF DEVELOPMENT CONSENT

SENSORS

CARABELLA 22-24 Carabella St, Kirribilli NSW 2061 CAMMERAYGAL PEOPLE **Drawing Name**

BASIX WATER INCLUSIONS Score 44/40	
FIXTURES WITHIN UNITS	SHOWERHEADS: 4 STAR MID FLOW (>6L BUT≤7.5L/MIN) TOILETS: 4.0 STAR KITCHEN TAPS: 6.0 STAR BATHROOM VANITY TAPS: 6.0 STAR
APPLIANCES WITHIN UNITS	DISHWASHERS: 6.0 STARS CLOTHES WASHERS: 4.5 STARS
FIRE SPRINKLER TEST WATER	THREE SPRINKLER SYSTEMS NOMINATED IN BASIX: ONE FOR BASEMENT LEVELS, ONE FOR APARTMENT LEVELS BUILDING A AND ONE FOR APARTMENT LEVELS BUILDING B.
CENTRAL RAINWATER STORAGE	TANK SIZE: 10,000L COLLECTING FROM 400M ROOF AREA (BUILDING B) CONNECTED TO OUTDOOR TAP FOR IRRIGATION OF COMMON

AREA LANDSCAPING

manne manne

NOT FOR CONSTRUCTION


Date	Scale	Sheet Size
16.10.25	1:1	A1
Drawn	Chk.	Job No.
AL	WG	7058
Drawing No.		Revision
DA-0000		/ E

SJB Architects Level 2, 490 Crown Street Surry Hills NSW 2010 T 61 2 9380 9911



In accepting and utilising this document the recipient agrees that SJB Architecture (NSW) Pty. Ltd. ACN 081 094 724 T/A SJB Architects, retain all common law, statutory law and other rights including copyright and intellectual property rights. The recipient agrees not to use this document for any purpose other than its intended use; to waive all claims against SJB Architects resulting from unauthorised changes; or to reuse the document on other projects without prior written consent from SJB Architects. Under no circumstances shall transfer of this document be deemed a sale. S.IB Architects makes no warranties of fitness for any purpose. The Builder/Contractor shall verify job dimensions prior

to any work commencing. Use figured dimensions only. Do not scale drawings **PRELIMINARY**

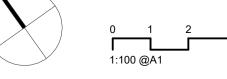

Nominated Architects: Adam Haddow-7188 | John Pradel-700-

Rev Date Revision 10.03.25 FOR INFORMATION 09.04.25 DA 3 02.09.25 DA RFI 09.09.25 DA RFI 20.09.25 DA RFI DRAF 22.09.25 BASEMENT UPDATE DRAFT 25.09.25 DA RFI TO NSC 13.10.25 RFI SECTION

NOTE: MINOR CHANGES TO FORM AND CONFIGURATION MAY BE REQUIRED WHEN DRAWINGS ARE SUBSEQUENTLY PREPARED FOR CONSTRUCTION

 $^{+}$

Score 65/62

BASIX ENERGY INCLUSIONS

CENTRAL ELECTRIC HEAT PUMP – GAS BOOSTED WITH R0.6 (~25MM)

ALL LIFTS TO HAVE GEARLESS TRACTION WITH VVVF MOTOR WITH LIFT LOAD

A MINIMUM EFFICIENCY OF EER 3.0 – 3.5 IS REQUIRED FOR COOLING; AND

MINIMUM OF 80% OF ALL LIGHT FITTINGS WITHIN EACH ROOM ARE TO HAVE

A MINIMUM EFFICIENCY OF EER 3.0 – 3.5 IS REQUIRED FOR HEATING

GARBAGE ROOMS - EXHAUST AIR ONLY, RUNNING CONTINUOUSLY

STORAGE – SUPPLY AIR ONLY, TIME CLOCK OR BMS

NO BASIX REQUIREMENT FOR ALTERNATIVE ENERGY

ALL UNITS HAVE INDIVIDUAL, SINGLE PHASE, REVERSE CYCLE AIR CONDITIONING TO

BATHROOM: INDIVIDUAL FAN, DUCTED TO ROOF OR FAÇADE- CONNECTED TO LIGHT, TIMER

KITCHEN RANGE HOOD: INDIVIDUAL FAN, DUCTED TO ROOF OR FAÇADE- MANUAL ON / OFF

CAR PARK AREA – SUPPLY AND EXHAUST AIR WITH A CARBON MONOXIDE MONITOR & VSD FAN

PLANT / SERVICE ROOMS – SUPPLY AND EXHAUST AIR, THERMOSTATICALLY CONTROLLED

GROUND FLOOR LOBBIES AND HALLWAYS - SUPPLY AIR, TIME CLOCK OR BMS CONTROLLED

CAR PARK AREA - LIGHT EMITTING DIODES (LEDS) WITH ZONED SWITCHING AND MOTION

PLANT / SERVICE ROOMS - LIGHT EMITTING DIODES (LEDS) WITH MANUAL ON / MANUAL OFF

GROUND FLOOR LOBBIES - LIGHT EMITTING DIODES (LEDS) WITH ZONED SWITCHING AND

HALLWAYS – LIGHT EMITTING DIODES (LEDS) WITH ZONED SWITCHING AND MOTION SENSORS

COVER

GROUND FLOOR LOBBIES AND HALLWAYS- NATURALLY VENTILATED (BUILDING B)

LIFTS - LIGHT EMITTING DIODES (LEDS) CONNECTED TO LIFT CALL BUTTON GARBAGE ROOMS - LIGHT EMITTING DIODES (LEDS) WITH MOTION SENSOR

LAUNDRY: INDIVIDUAL FAN, DUCTED TO ROOF OR FAÇADE- MANUAL ON / OFF SWITCH

INSULATION TO RING MAIN AND SUPPLY RISERS

CAPACITY OF ≥1,001KG TO ≤1,500KG

LIVING AREAS, AND AT LEAST 1 BEDROOM

DEDICATED LED FIXTURES INSTALLED

GAS COOKTOP & ELECTRIC OVEN

DISHWASHERS: 4 STAR

CLOTHES DRYERS: 7 STAR

HOT WATER SYSTEM

APPLIANCES AND OTHER

EFFICIENCY MEASURES

HEATING AND COOLING

VENTILATION WITHIN

ARTIFICIAL LIGHTING TO

ALTERNATIVE ENERGY

COMMON AREAS

UNITS


WITHIN UNITS


WITHIN UNITS



In accepting and utilising this document the recipient agrees that SJB Architecture (NSW) Pty. Ltd. ACN 081 094 724 T/A SJB Architects, retain all common law, statutory law and other rights including copyright and intellectual property rights. The recipient agrees not to use this document for any purpose other than its intended use; to waive all claims against SJB Architects resulting from unauthorised changes; or to reuse the document on other projects without prior written consent from SJB Architects. Under no circumstances shall transfer of this document be deemed a sale. SJB Architects makes no warranties of fitness for any purpose. The Builder/Contractor shall verify job dimensions prior to any work commencing. Use figured dimensions only. Do not scale drawings.

PRELIMINARY

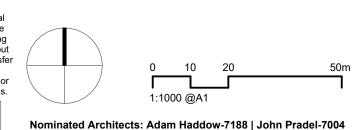

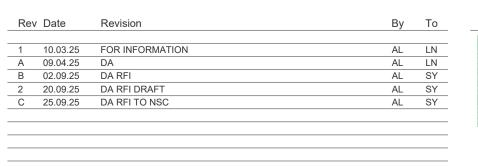





Project
CARABELLA
22-24 Carabella St, Kirribilli NSW 2061
CAMMERAYGAL PEOPLE / EORA NATION
Drawing Name
LOCATION PLAN


Date	Scale	Sheet Size
25.09.25	1 : 1000	A1
Drawn	Chk.	Job No.
AL	WG	7058
Drawing No.		Revision
DA-00	10	/ C






In accepting and utilising this document the recipient agrees that SJB Architecture (NSW) Pty. Ltd. ACN 081 094 724 T/A SJB Architects, retain all common law, statutory law and other rights including copyright and intellectual property rights. The recipient agrees not to use this document for any purpose other than its intended use; to waive all claims against SJB Architects resulting from unauthorised changes; or to reuse the document on other projects without prior written consent from SJB Architects. Under no circumstances shall transfer of this document be deemed a sale. SJB Architects makes no warranties of fitness for any purpose. The Builder/Contractor shall verify job dimensions prior to any work commencing. Use figured dimensions only. Do not scale drawings.

PRELIMINARY

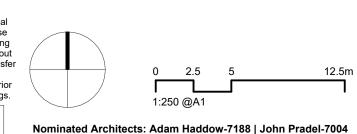

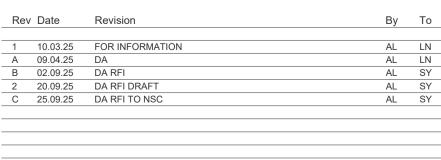






CARABELLA
22-24 Carabella St, Kirribilli NSW 2061
CAMMERAYGAL PEOPLE / EORA NATION
Drawing Name
SITE PLAN - EXISTING


Date	Scale	Sheet Size
25.09.25	1 : 250	A1
Drawn	Chk.	Job No.
AL	WG	7058
Drawing No.		Revision
DA-0100		/ C





In accepting and utilising this document the recipient agrees that SJB Architecture (NSW) Pty. Ltd. ACN 081 094 724 T/A SJB Architects, retain all common law, statutory law and other rights including copyright and intellectual property rights. The recipient agrees not to use this document for any purpose other than its intended use; to waive all claims against SJB Architects resulting from unauthorised changes; or to reuse the document on other projects without prior written consent from SJB Architects. Under no circumstances shall transfer of this document be deemed a sale. SJB Architects makes no warranties of fitness for any purpose. The Builder/Contractor shall verify job dimensions prior to any work commencing. Use figured dimensions only. Do not scale drawings.

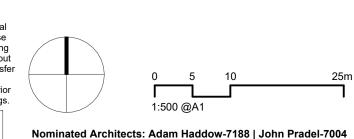

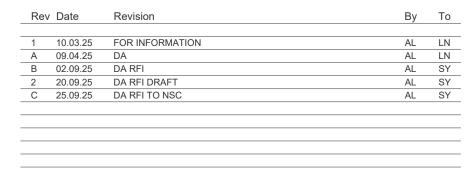








Project
CARABELLA
22-24 Carabella St, Kirribilli NSW 2061
CAMMERAYGAL PEOPLE / EORA NATION
Drawing Name
SITE ANALYSIS


Date	Scale	Sheet Size
25.09.25	As indicated	A1
Drawn	Chk.	Job No
AL	WG	7058
Drawing No.		Revision
DA-01	01	/ C



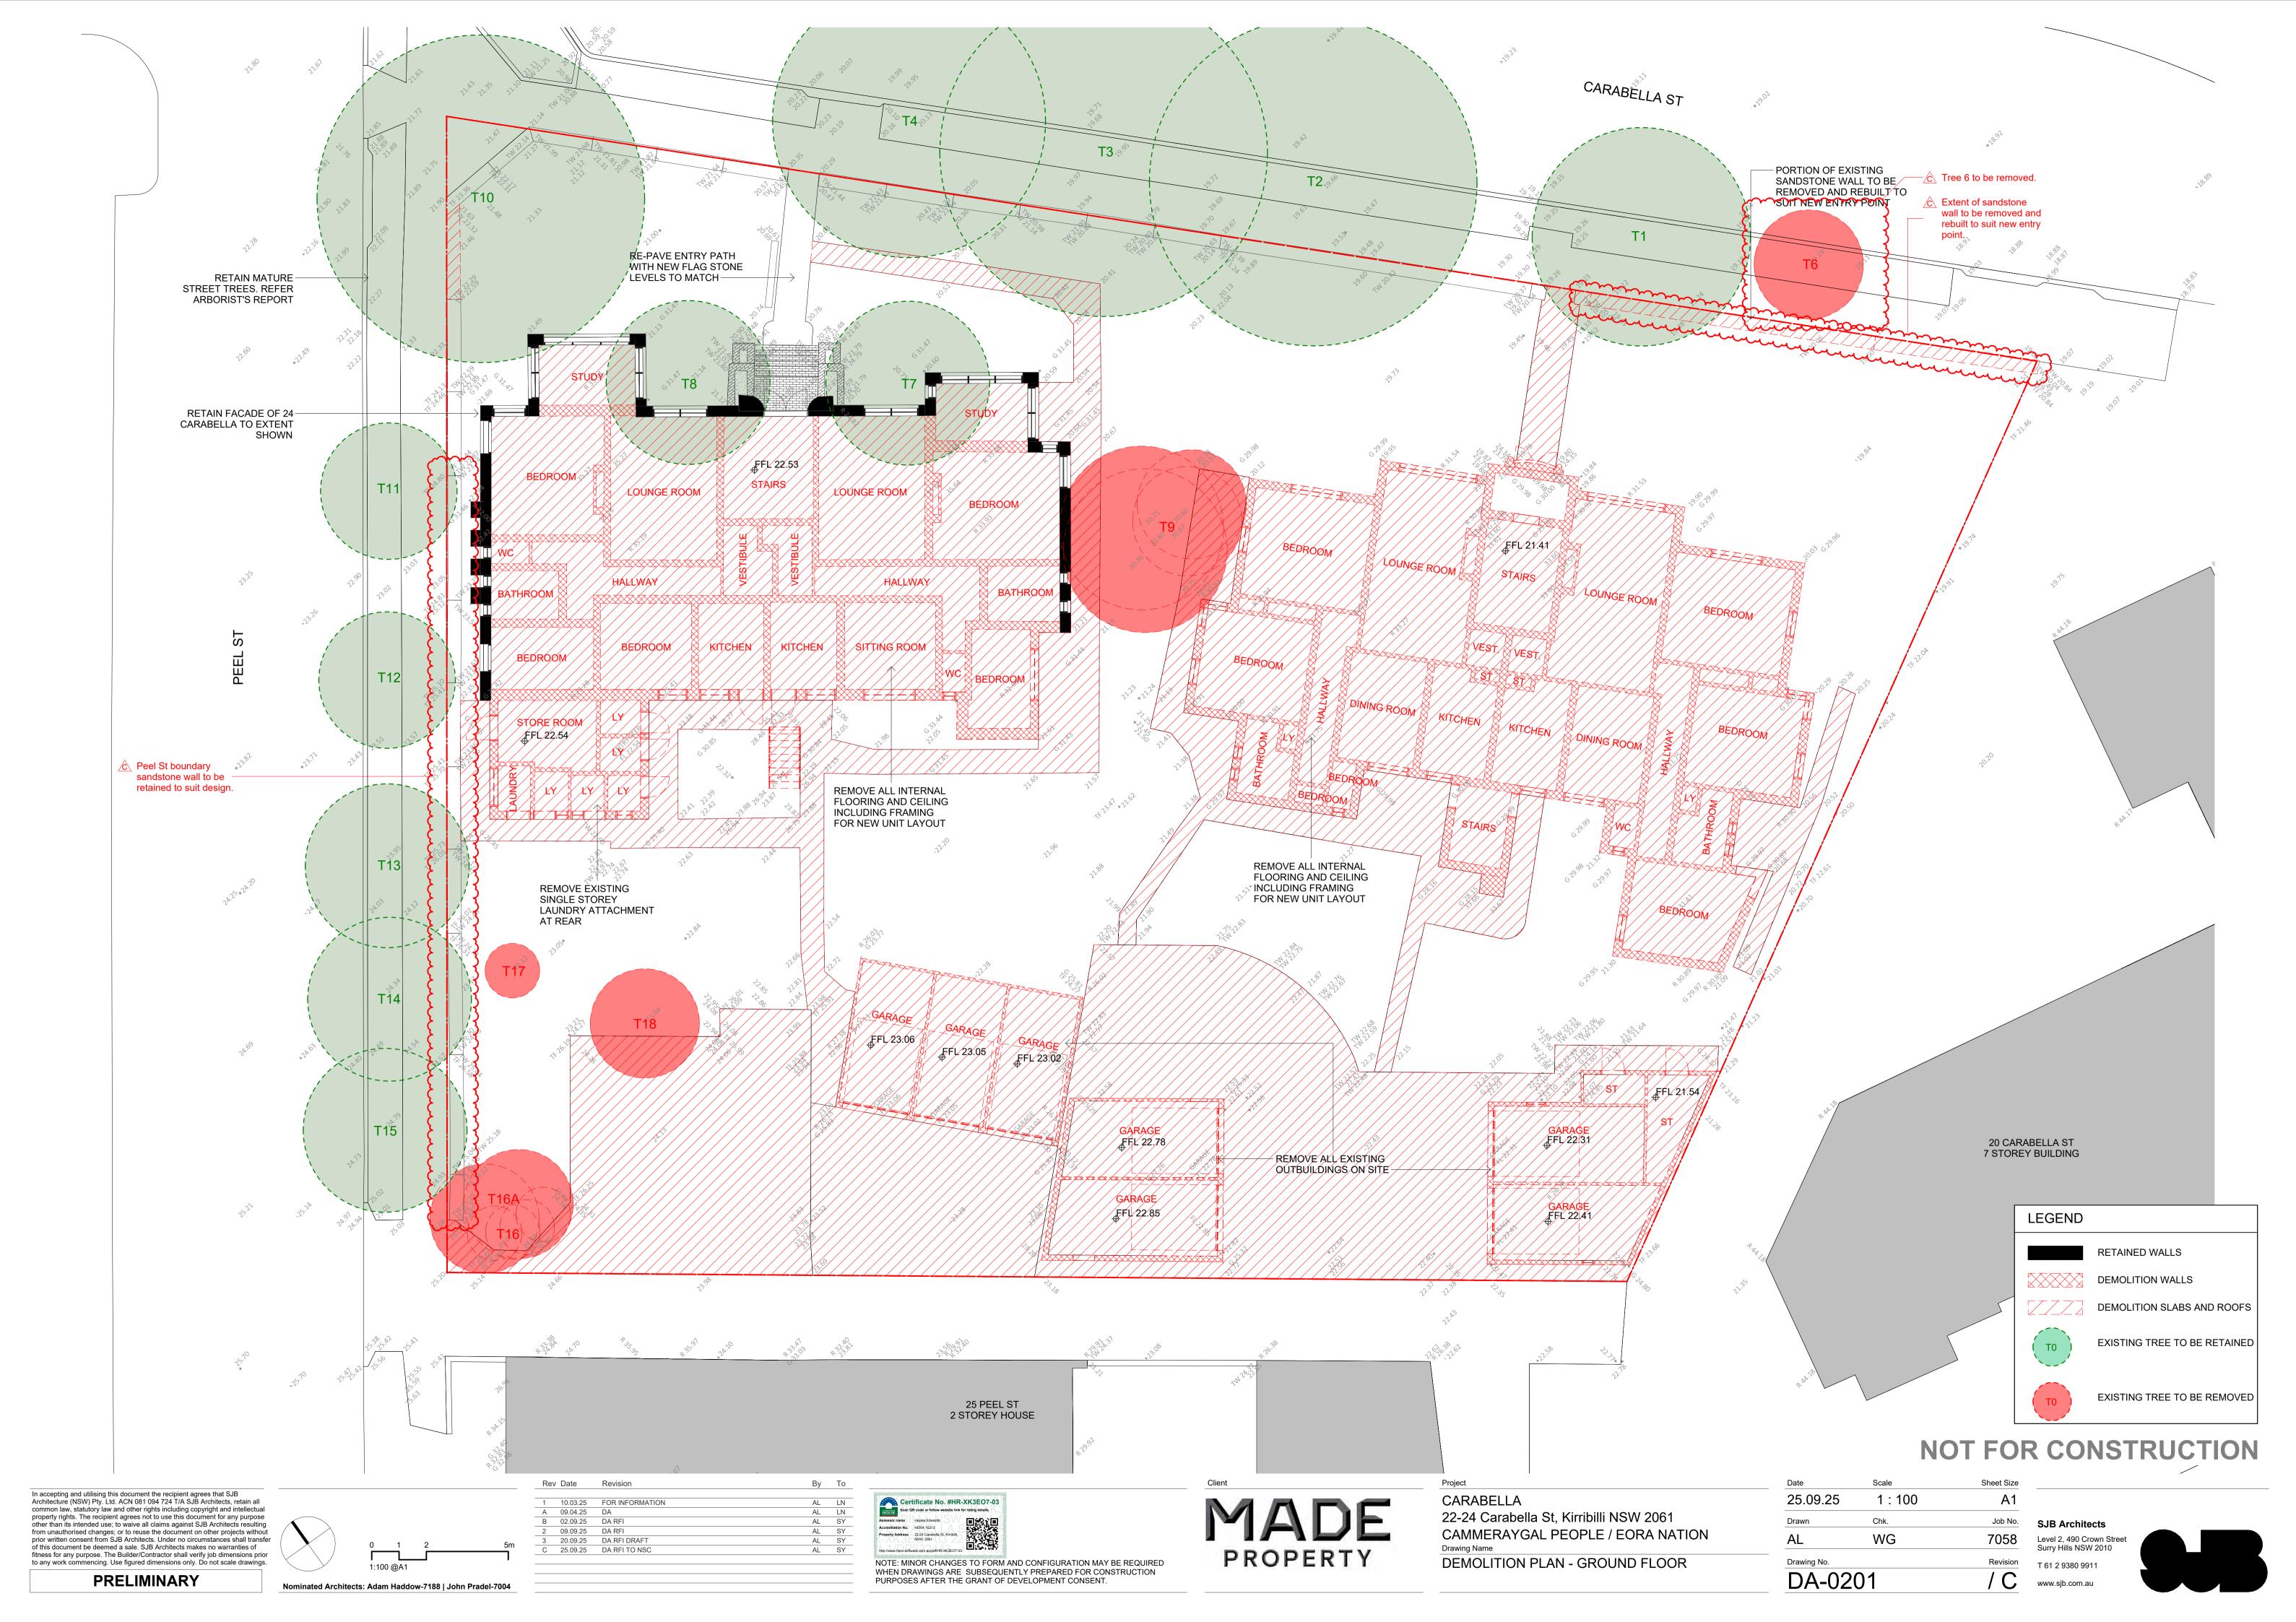


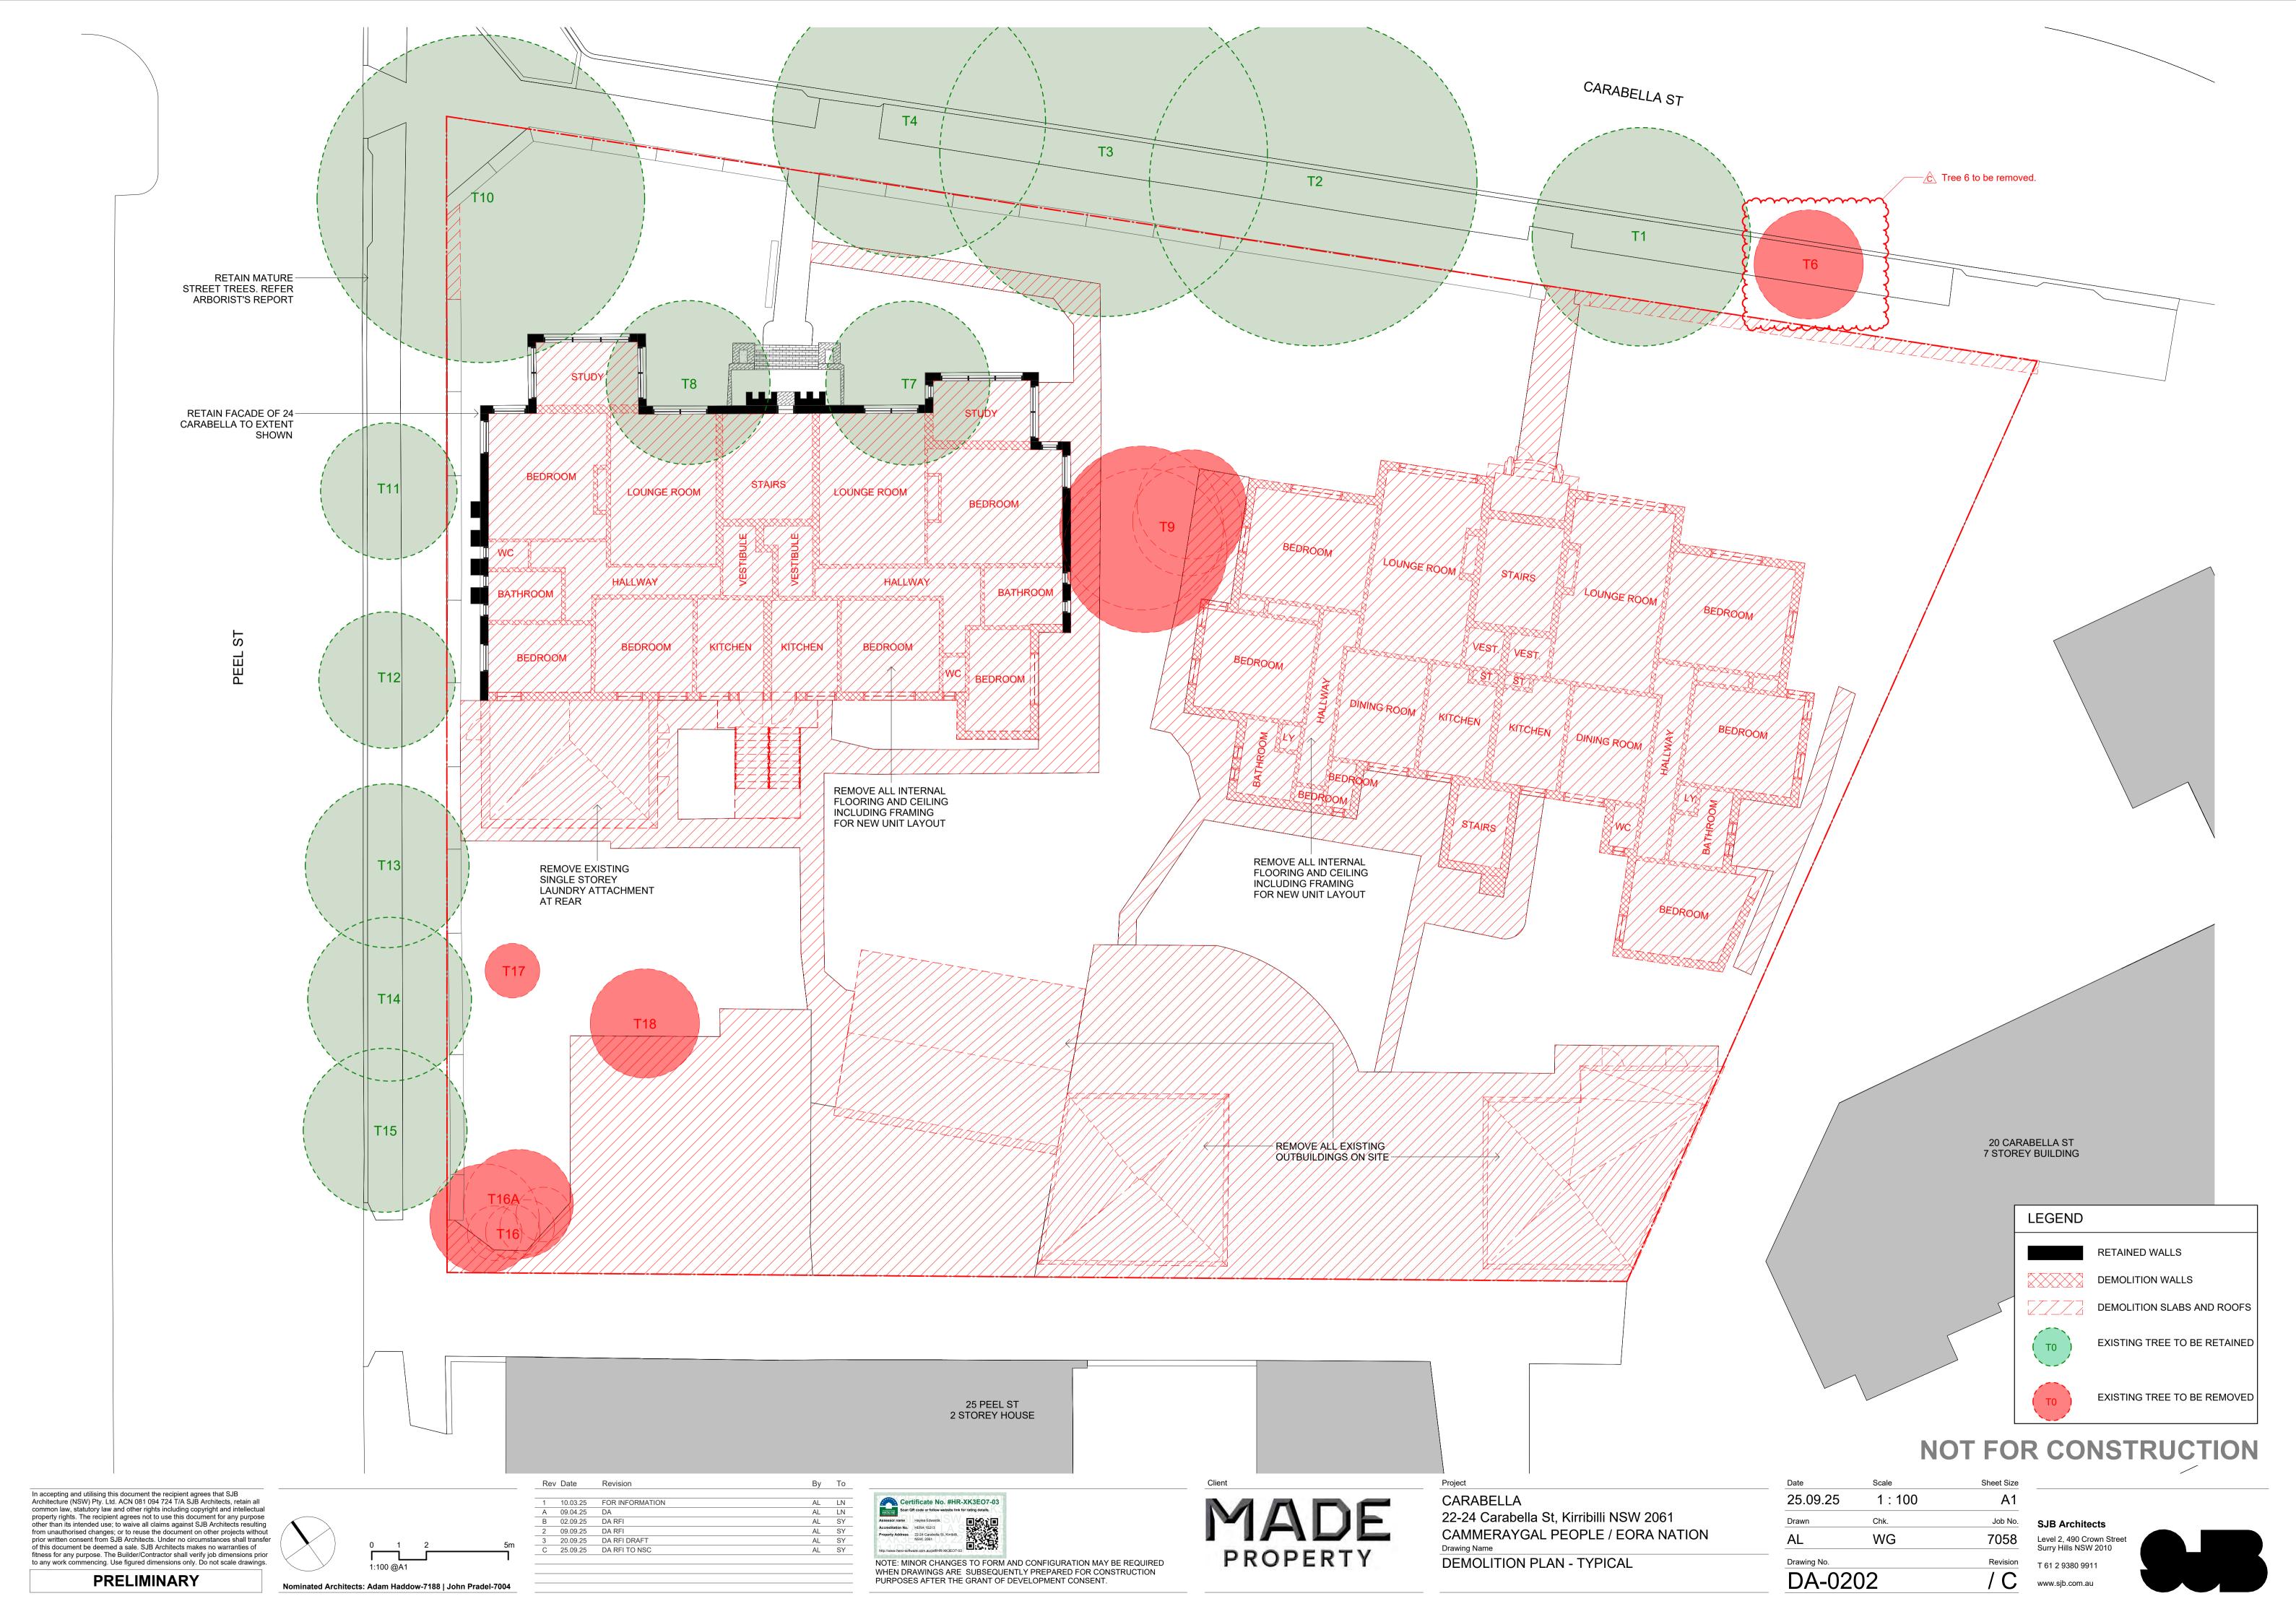


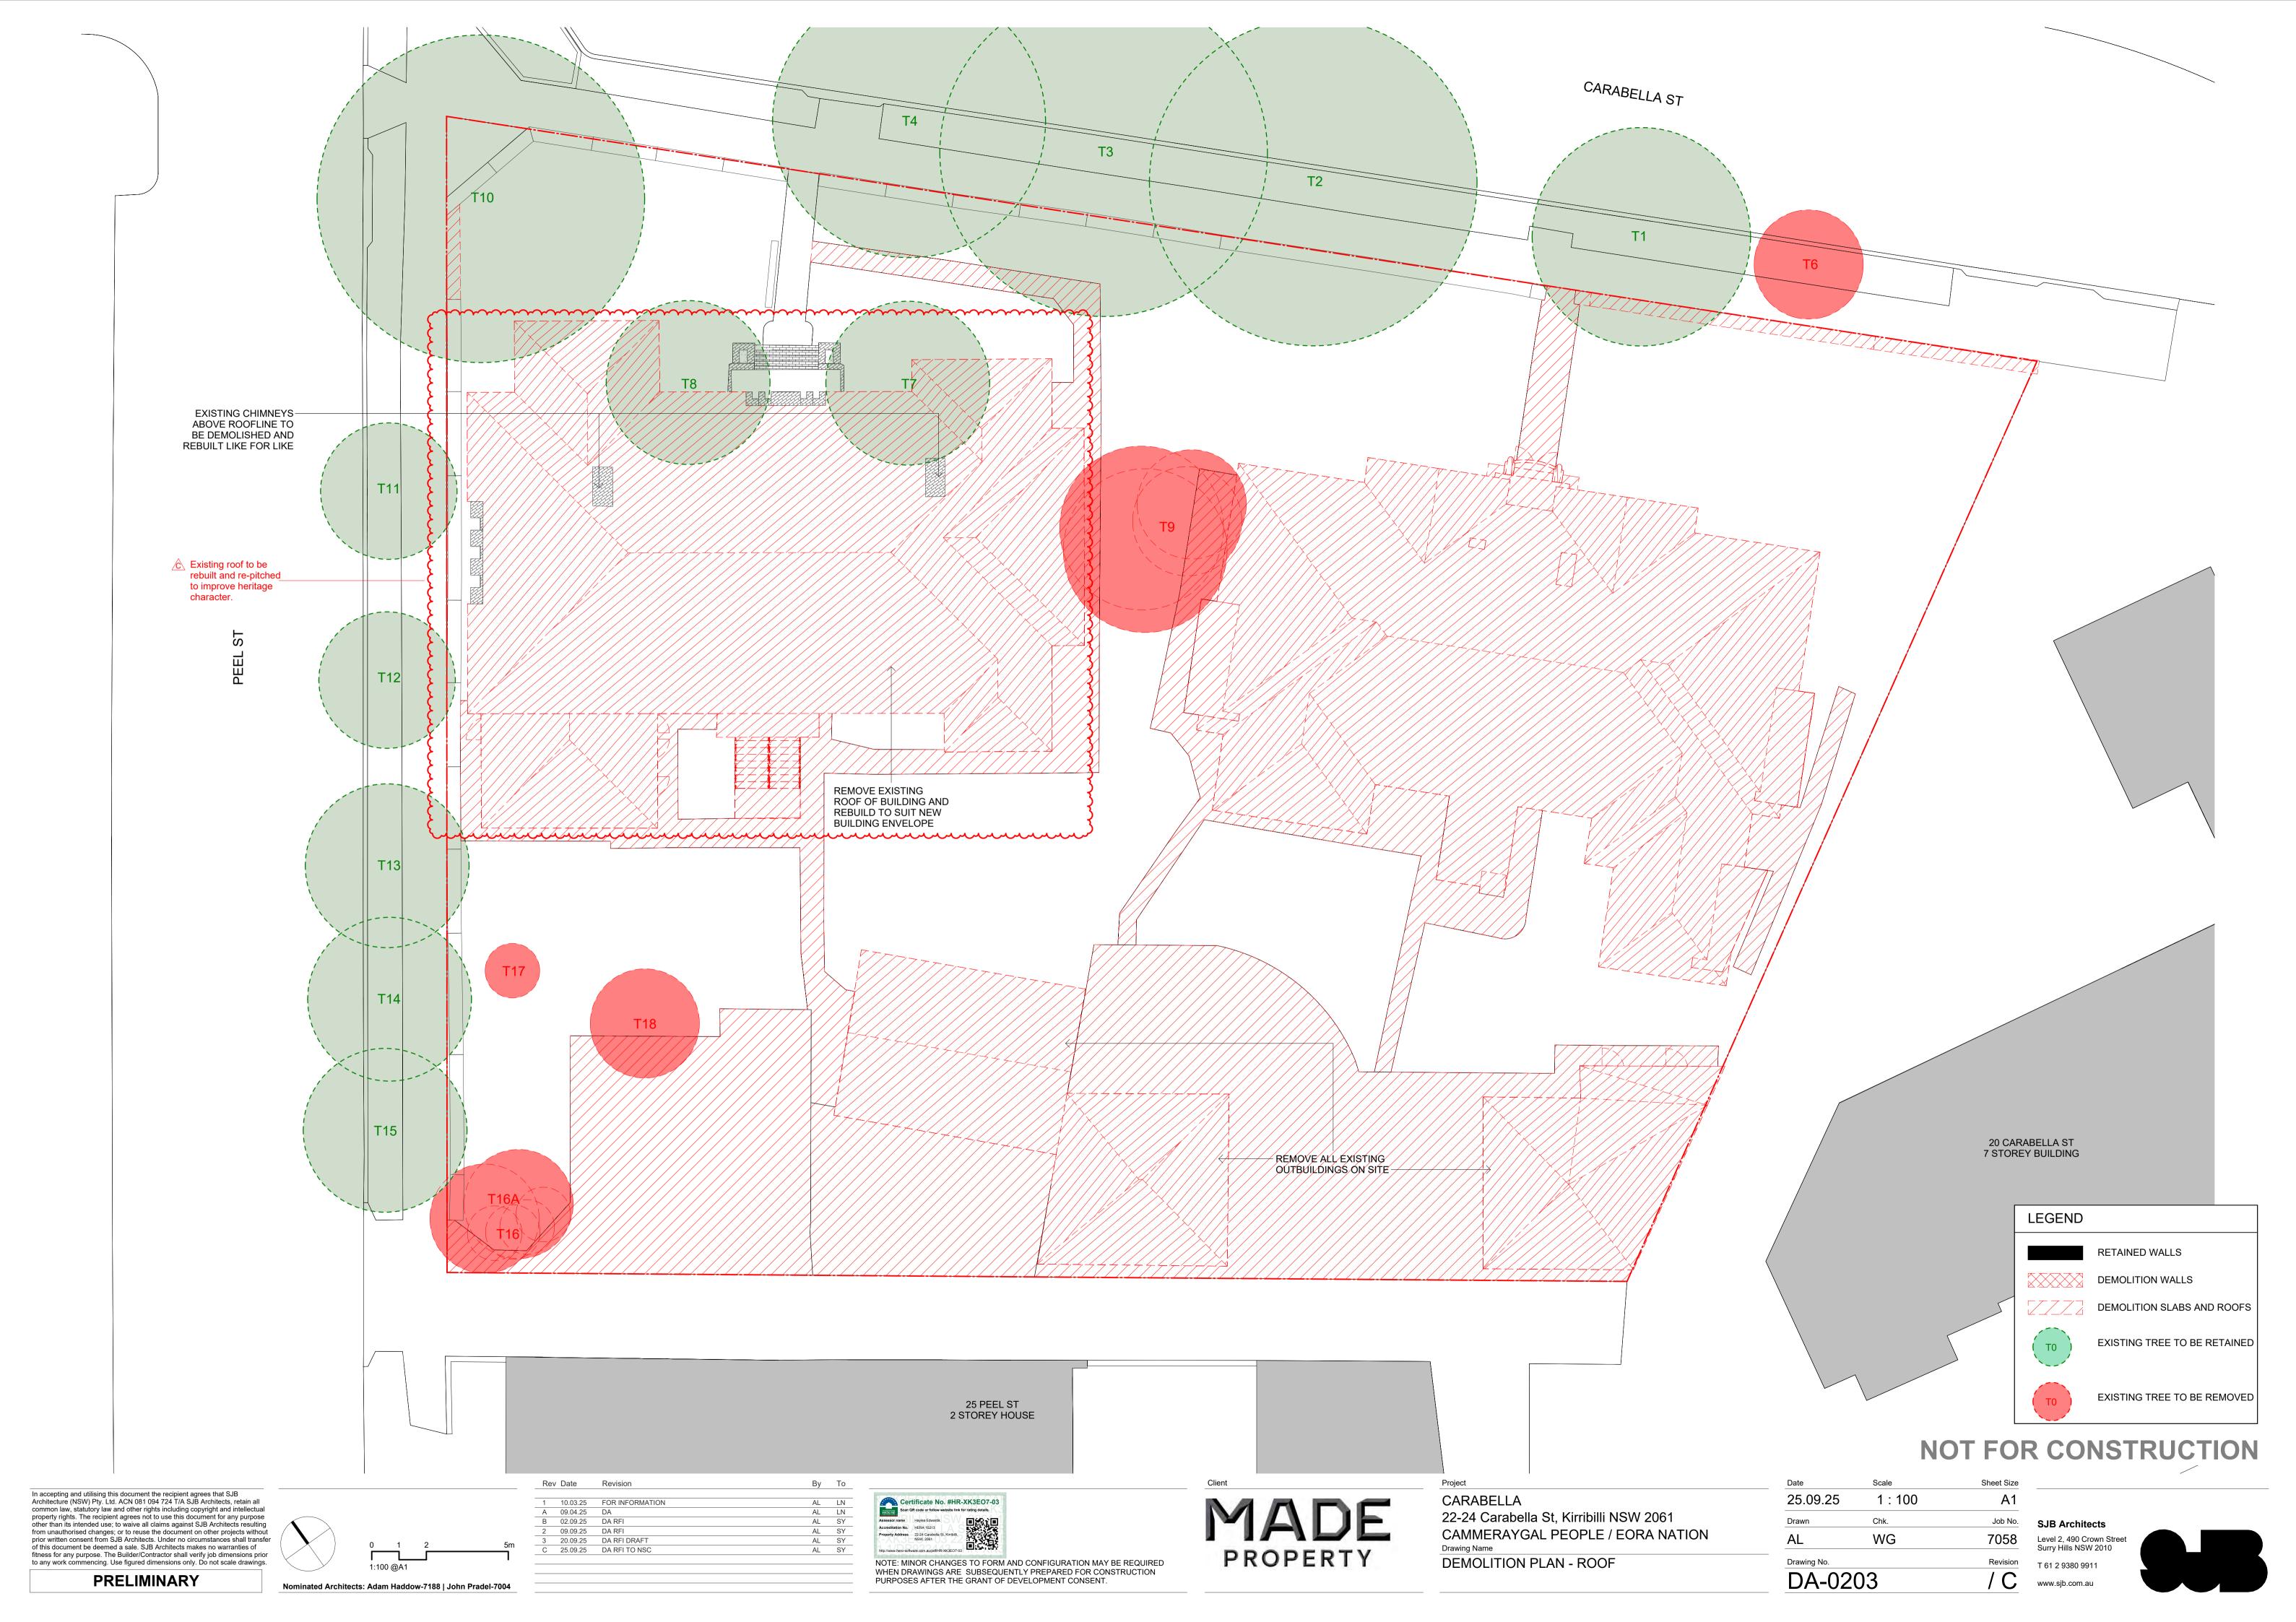

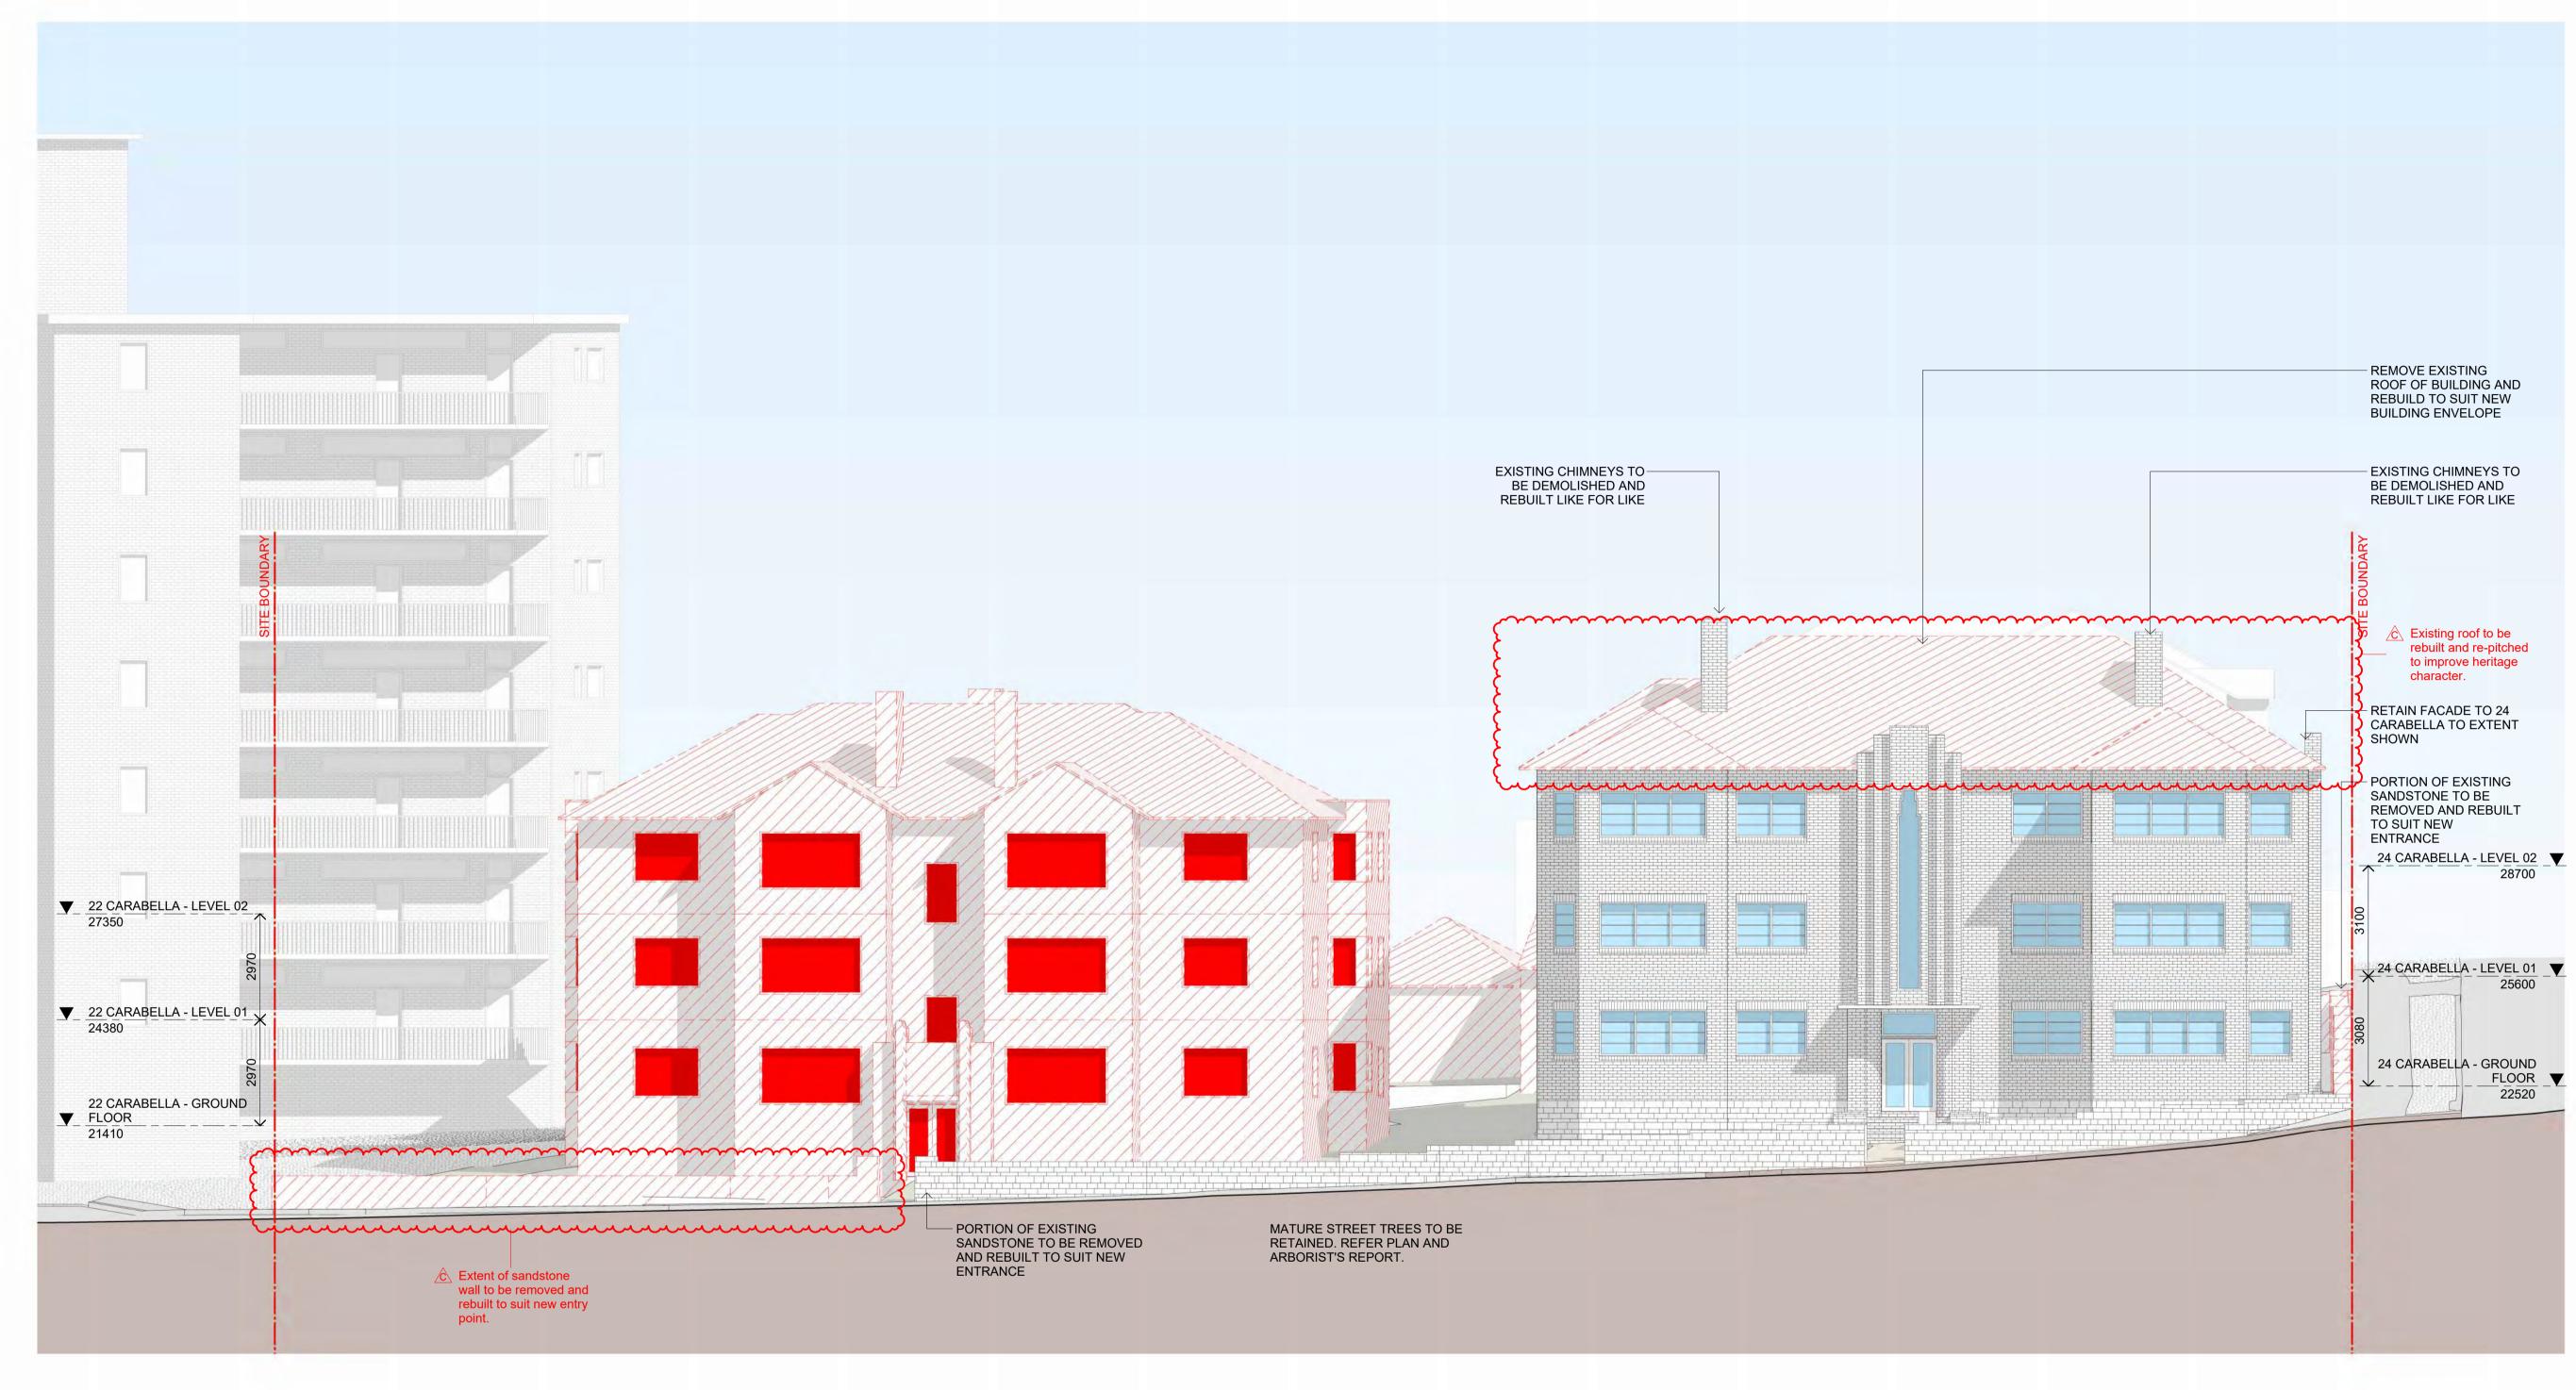



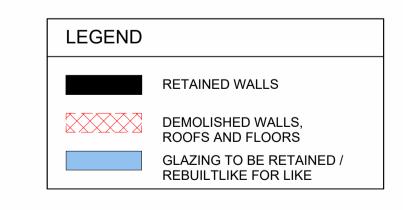


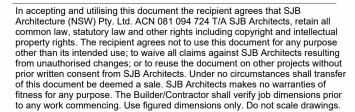

changes; or to reuse the document on other projects without that from SJB Architects. Under no circumstances shall transfer be deemed a sale. SJB Architects makes no warranties of pose. The Builder/Contractor shall verify job dimensions prior lencing. Use figured dimensions only. Do not scale drawings.

PRELIMINARY

Nominated Architects: Adam Haddow-7188 | John Pradel-7004

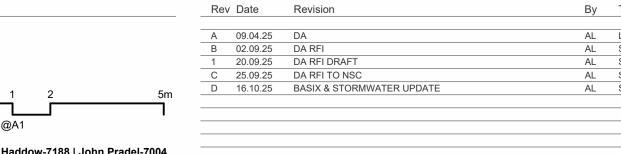







Project
CARABELLA
22-24 Carabella St, Kirribilli NSW 2061
CAMMERAYGAL PEOPLE
Drawing Name
DEMOLITION ELEVATION - NORTH EAST

DA-02	41	/ D
Drawing No.		Revision
AL	WG	7058
Drawn	Chk.	Job No
16.10.25	1 : 100	A1
Date	Scale	Sheet Size




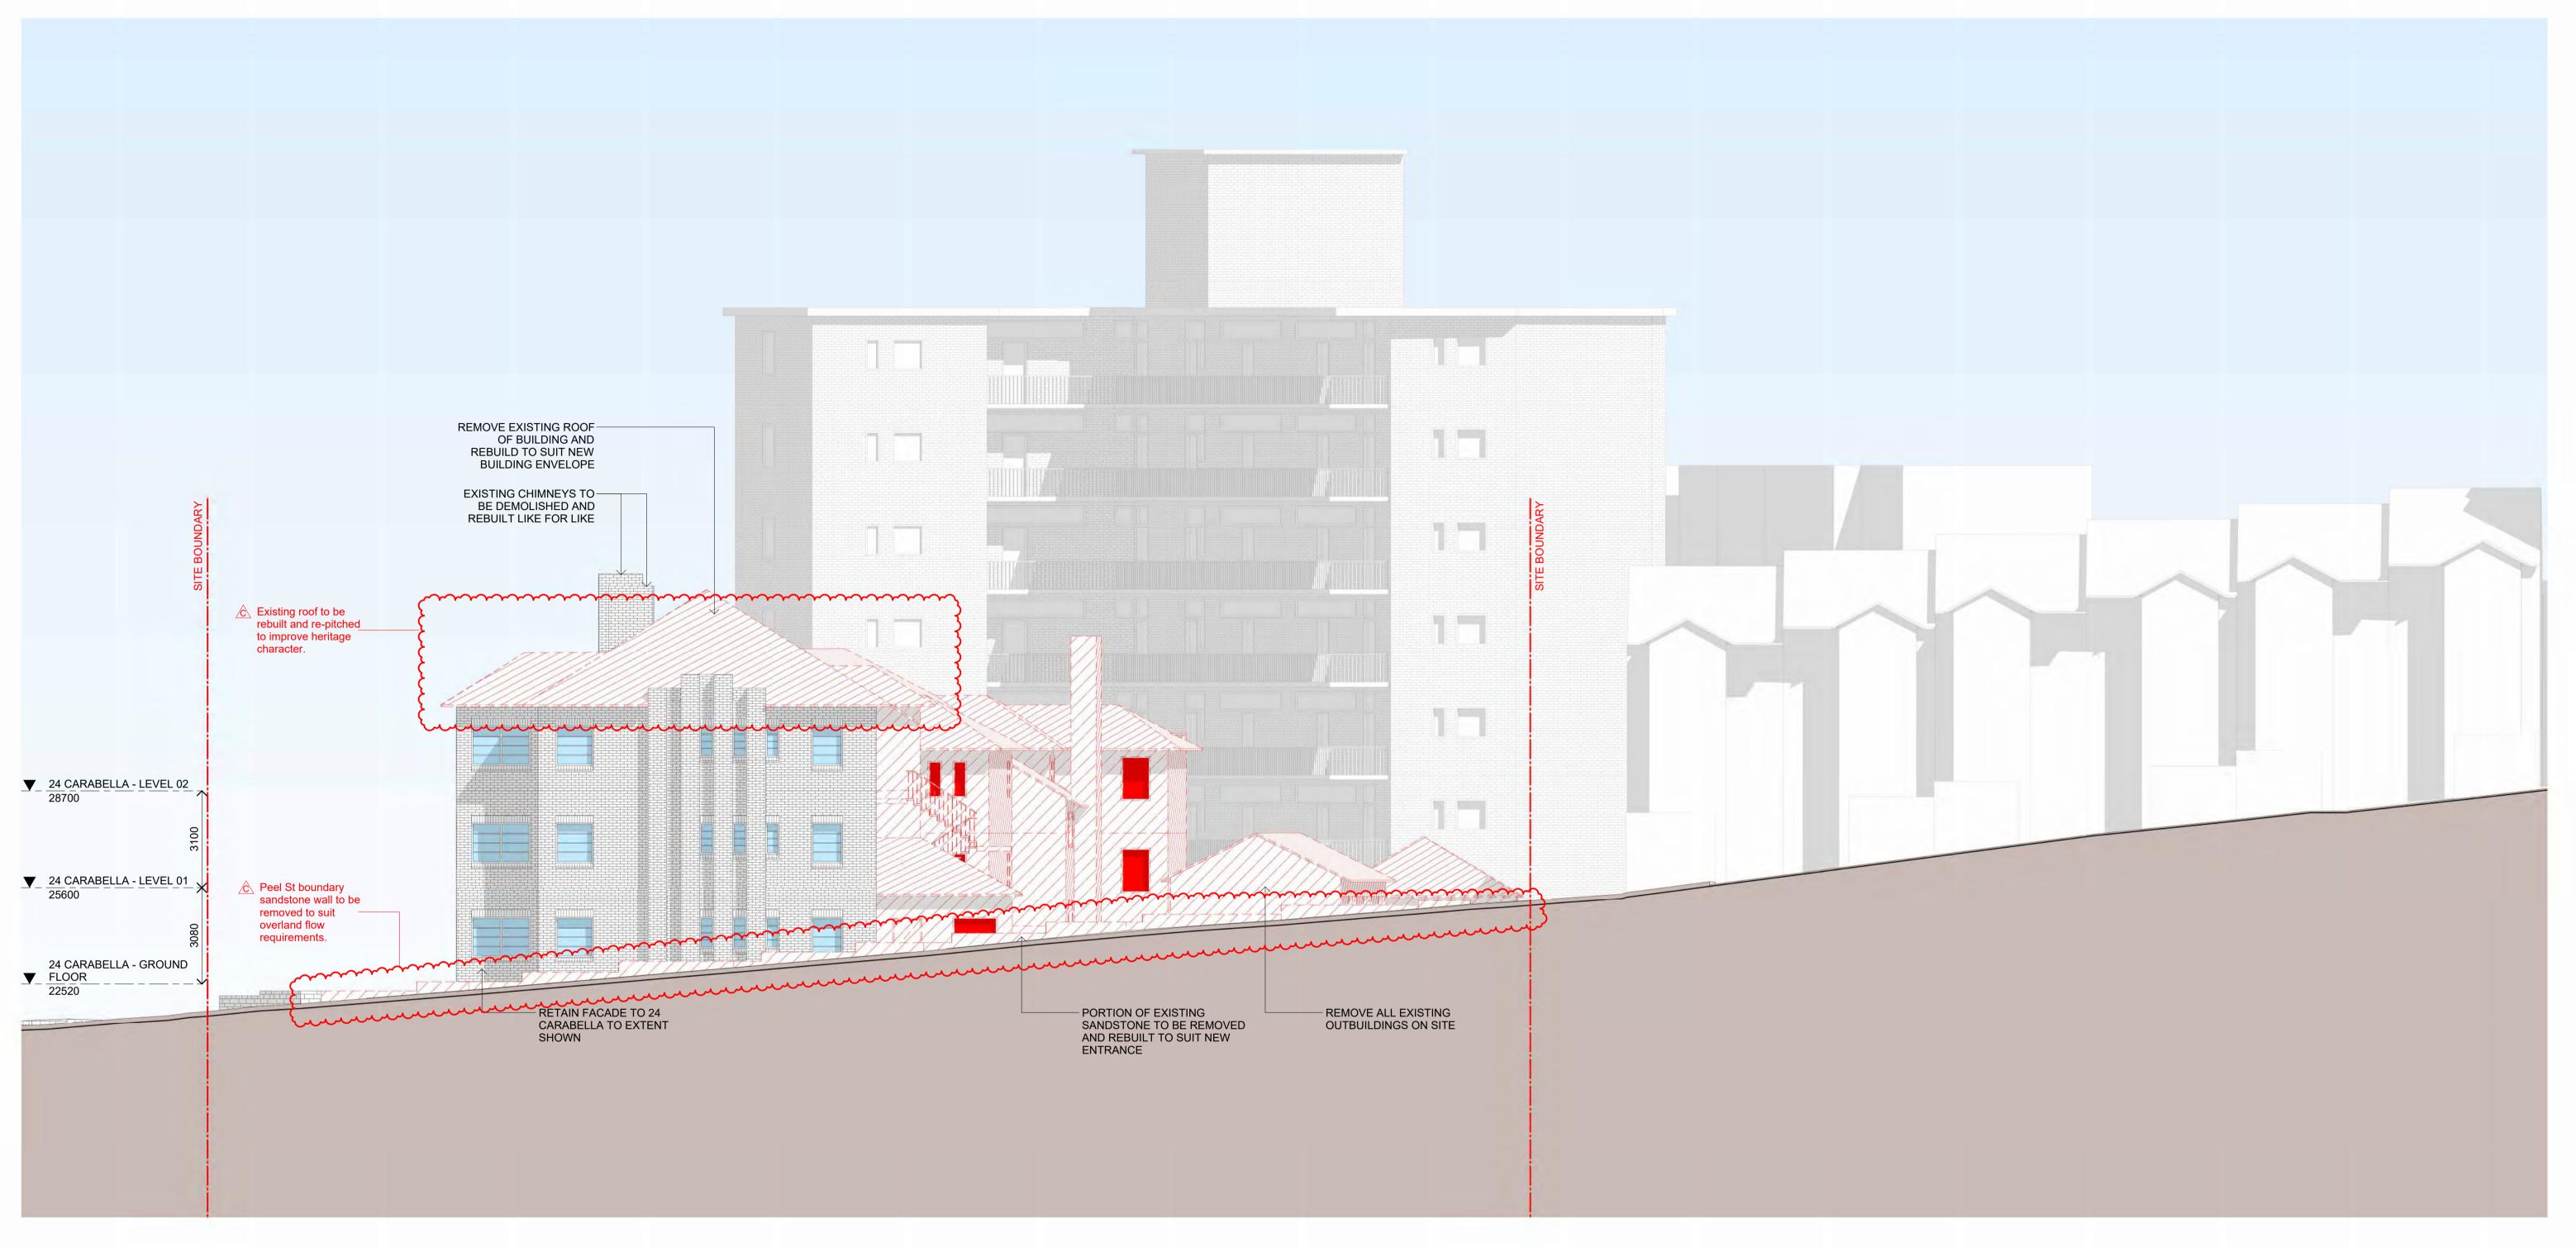



1 ELEVATION - NORTH WEST - DEMOLITION
SCALE 1: 100

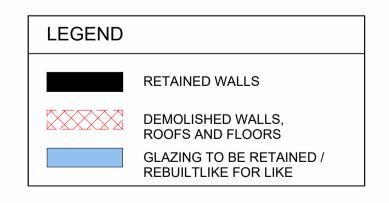

NOT FOR CONSTRUCTION

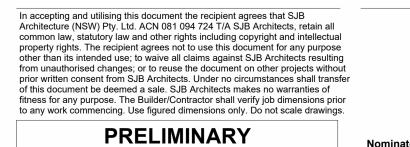

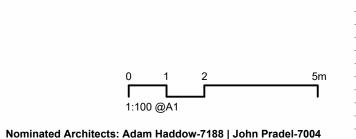

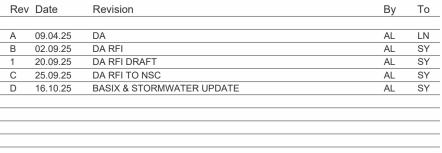







CARABELLA
22-24 Carabella St, Kirribilli NSW 2061
CAMMERAYGAL PEOPLE
Drawing Name
DEMOLITION ELEVATION - NORTH WEST

Date	Scale	Sheet Size
16.10.25	1 : 100	A1
Drawn	Chk.	Job No.
AL	WG	7058
Drawing No.		Revision
DA-024	42	/ D



EXCAVATION ESTIMATES

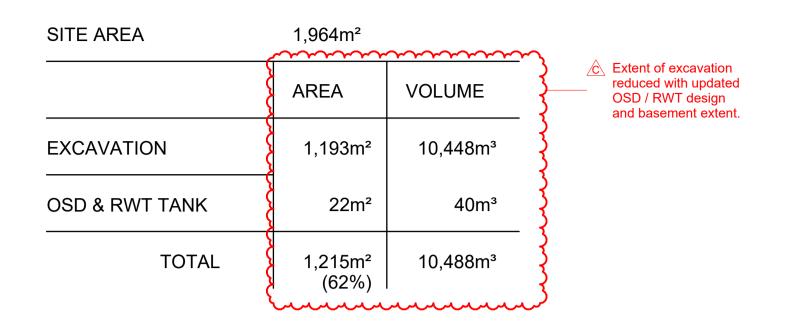


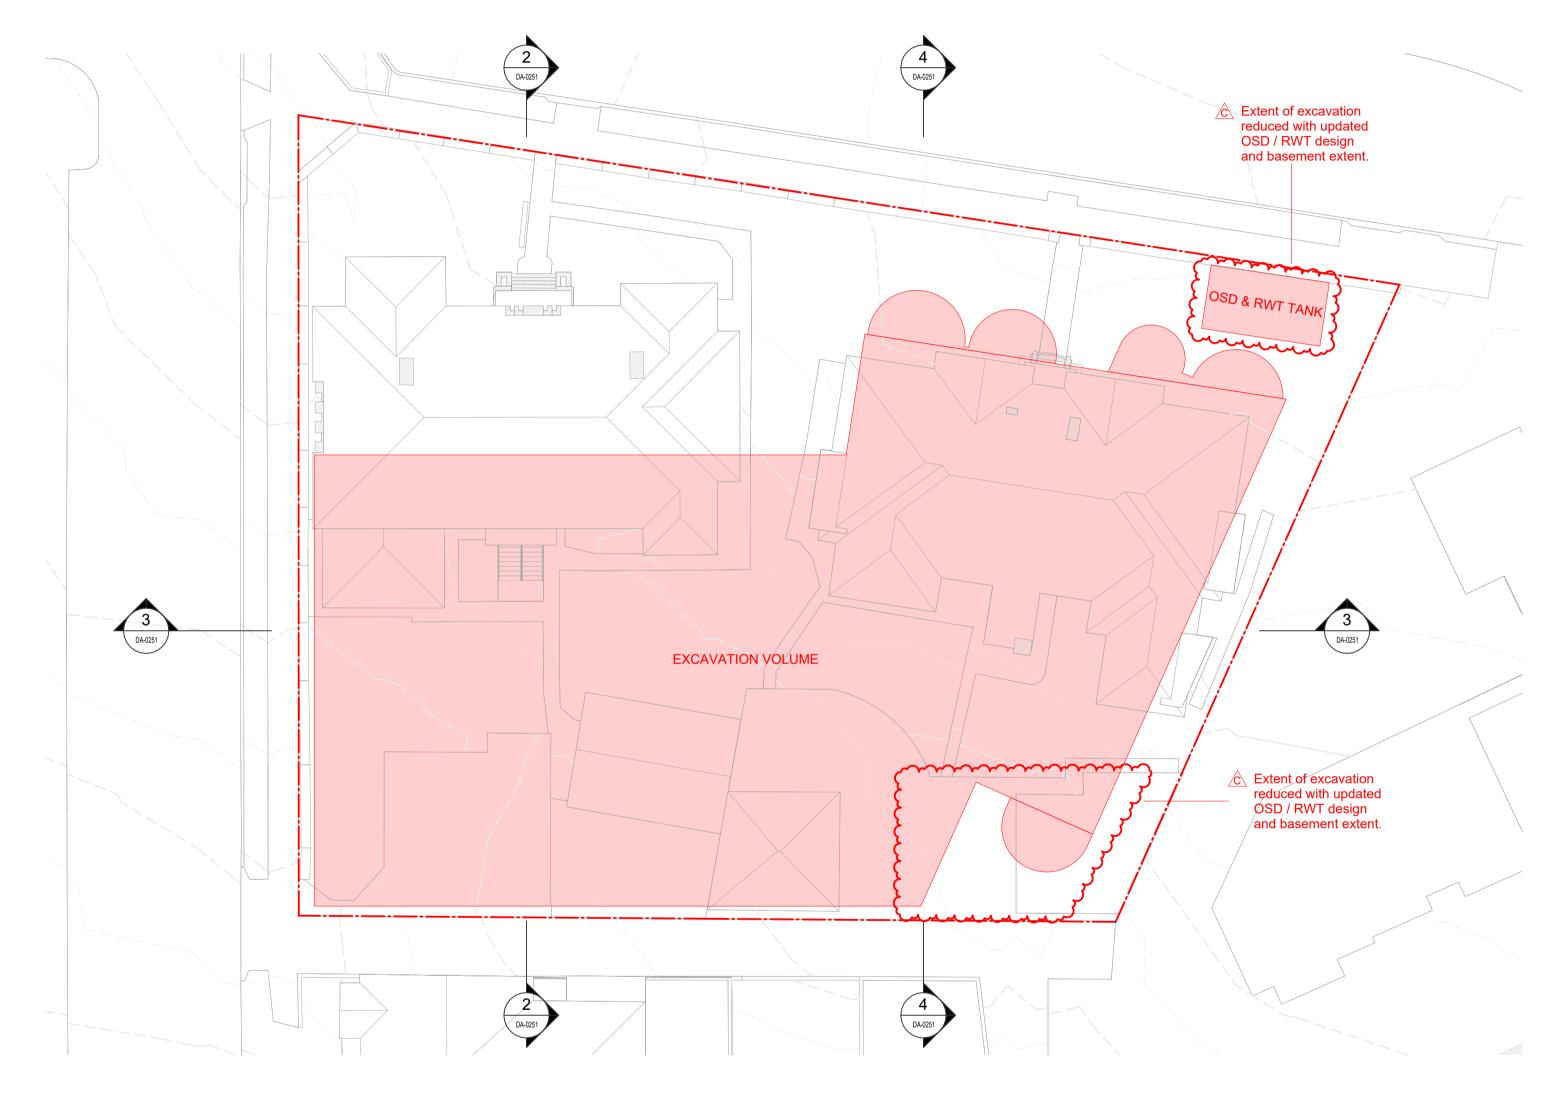



1 SITE PLAN - EXCAVATION DIAGRAM
SCALE 1: 200



NOT FOR CONSTRUCTION

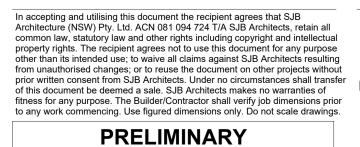

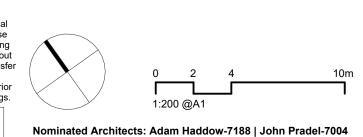

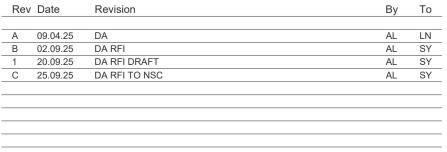






Project
CARABELLA
22-24 Carabella St, Kirribilli NSW 2061
CAMMERAYGAL PEOPLE / EORA NATION
Drawing Name
PROPOSED EXCAVATION DIAGRAM

Date	Scale	Sheet Size
25.09.25	1 : 200	A1
Drawn	Chk.	Job No.
AL	WG	7058
Drawing No.		Revision
DA-02	/ C	





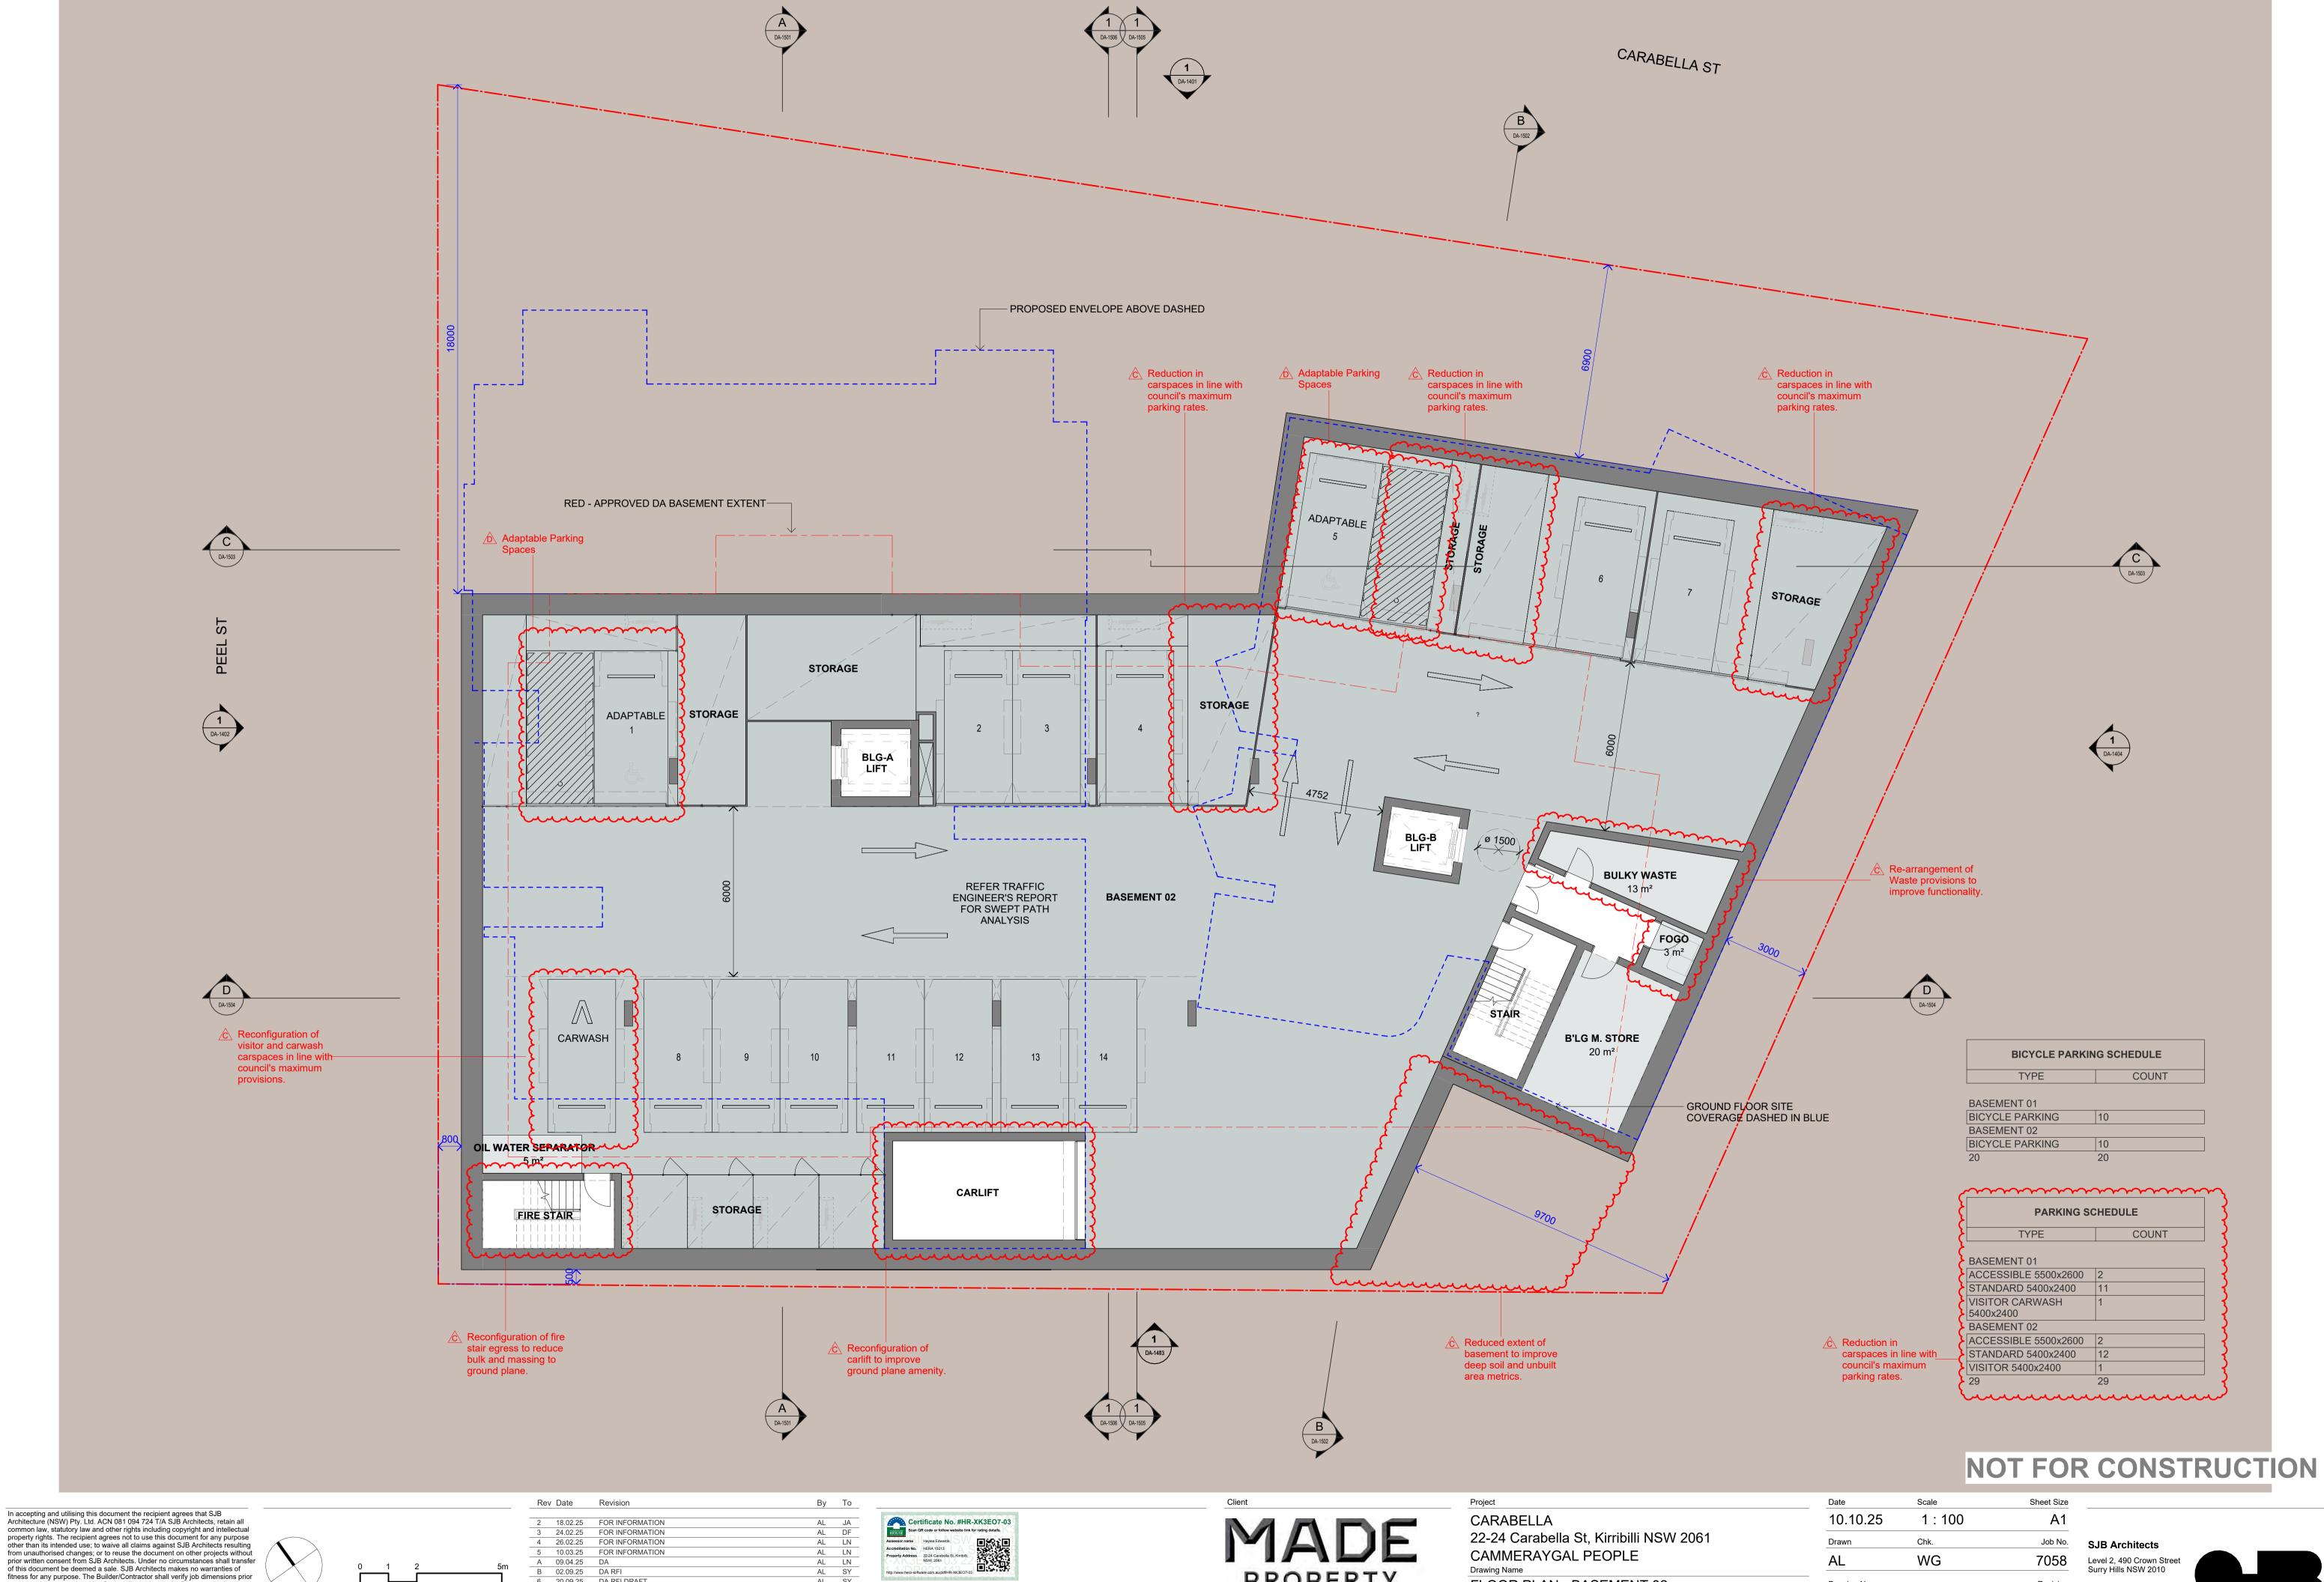

to any work commencing. Use figured dimensions only. Do not scale drawings. **PRELIMINARY**

1:100 @A1

A 09.04.25 DA
B 02.09.25 DA RFI
6 20.09.25 DA RFI DRAFT 22.09.25 BASEMENT UPDATE DRAFT 25.09.25 DA RFI TO NSC Nominated Architects: Adam Haddow-7188 | John Pradel-7004 10.10.25 RFI




MADE PROPERTY

FLOOR PLAN - BASEMENT 02

WG Drawing No. DA-1001



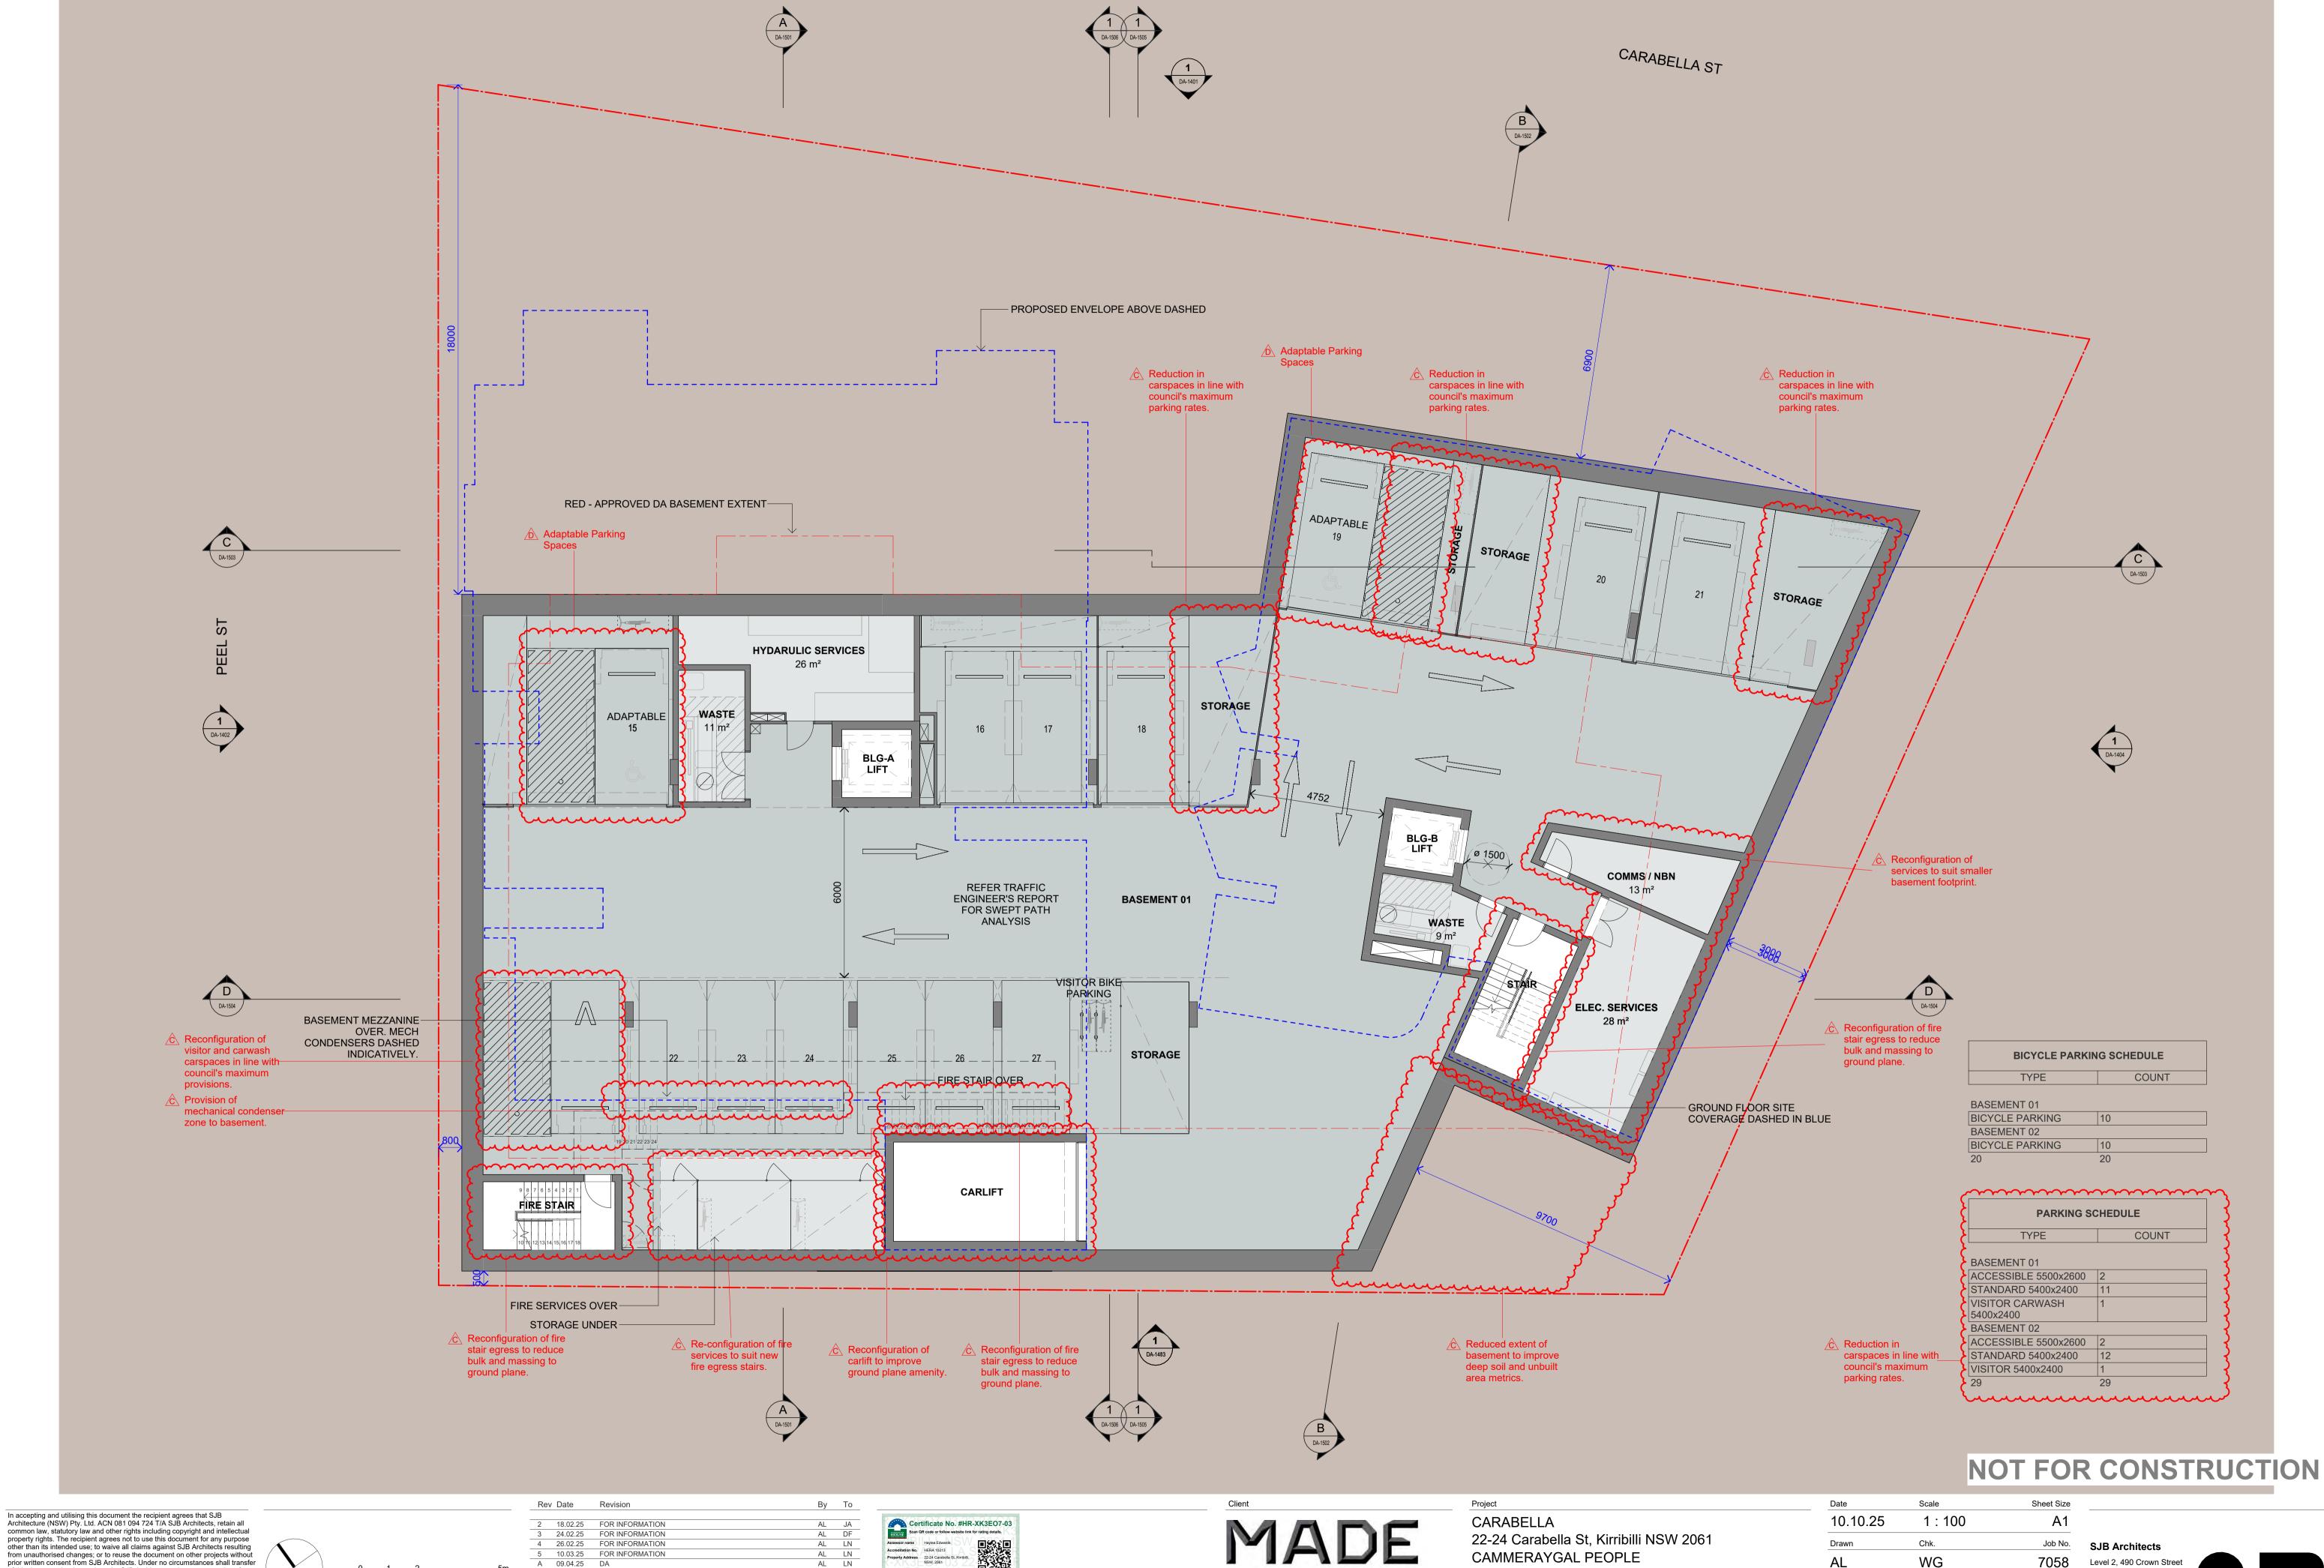

of this document be deemed a sale. SJB Architects makes no warranties of fitness for any purpose. The Builder/Contractor shall verify job dimensions prior to any work commencing. Use figured dimensions only. Do not scale drawings. **PRELIMINARY**

1:100 @A1 Nominated Architects: Adam Haddow-7188 | John Pradel-7004

09.04.25 DA 02.09.25 DA RFI 20.09.25 DA RFI DRAFT 22.09.25 BASEMENT UPDATE DRAFT 25.09.25 DA RFI TO NSC 10.10.25 RFI





MADE **PROPERTY**


FLOOR PLAN - BASEMENT 01


Date	Scale	Sheet Size
10.10.25	1 : 100	A1
Drawn	Chk.	Job No.
AL	WG	7058
Drawing No.		Revision
DA-1002		/ D

Level 2, 490 Crown Street Surry Hills NSW 2010 T 61 2 9380 9911 www.sjb.com.au

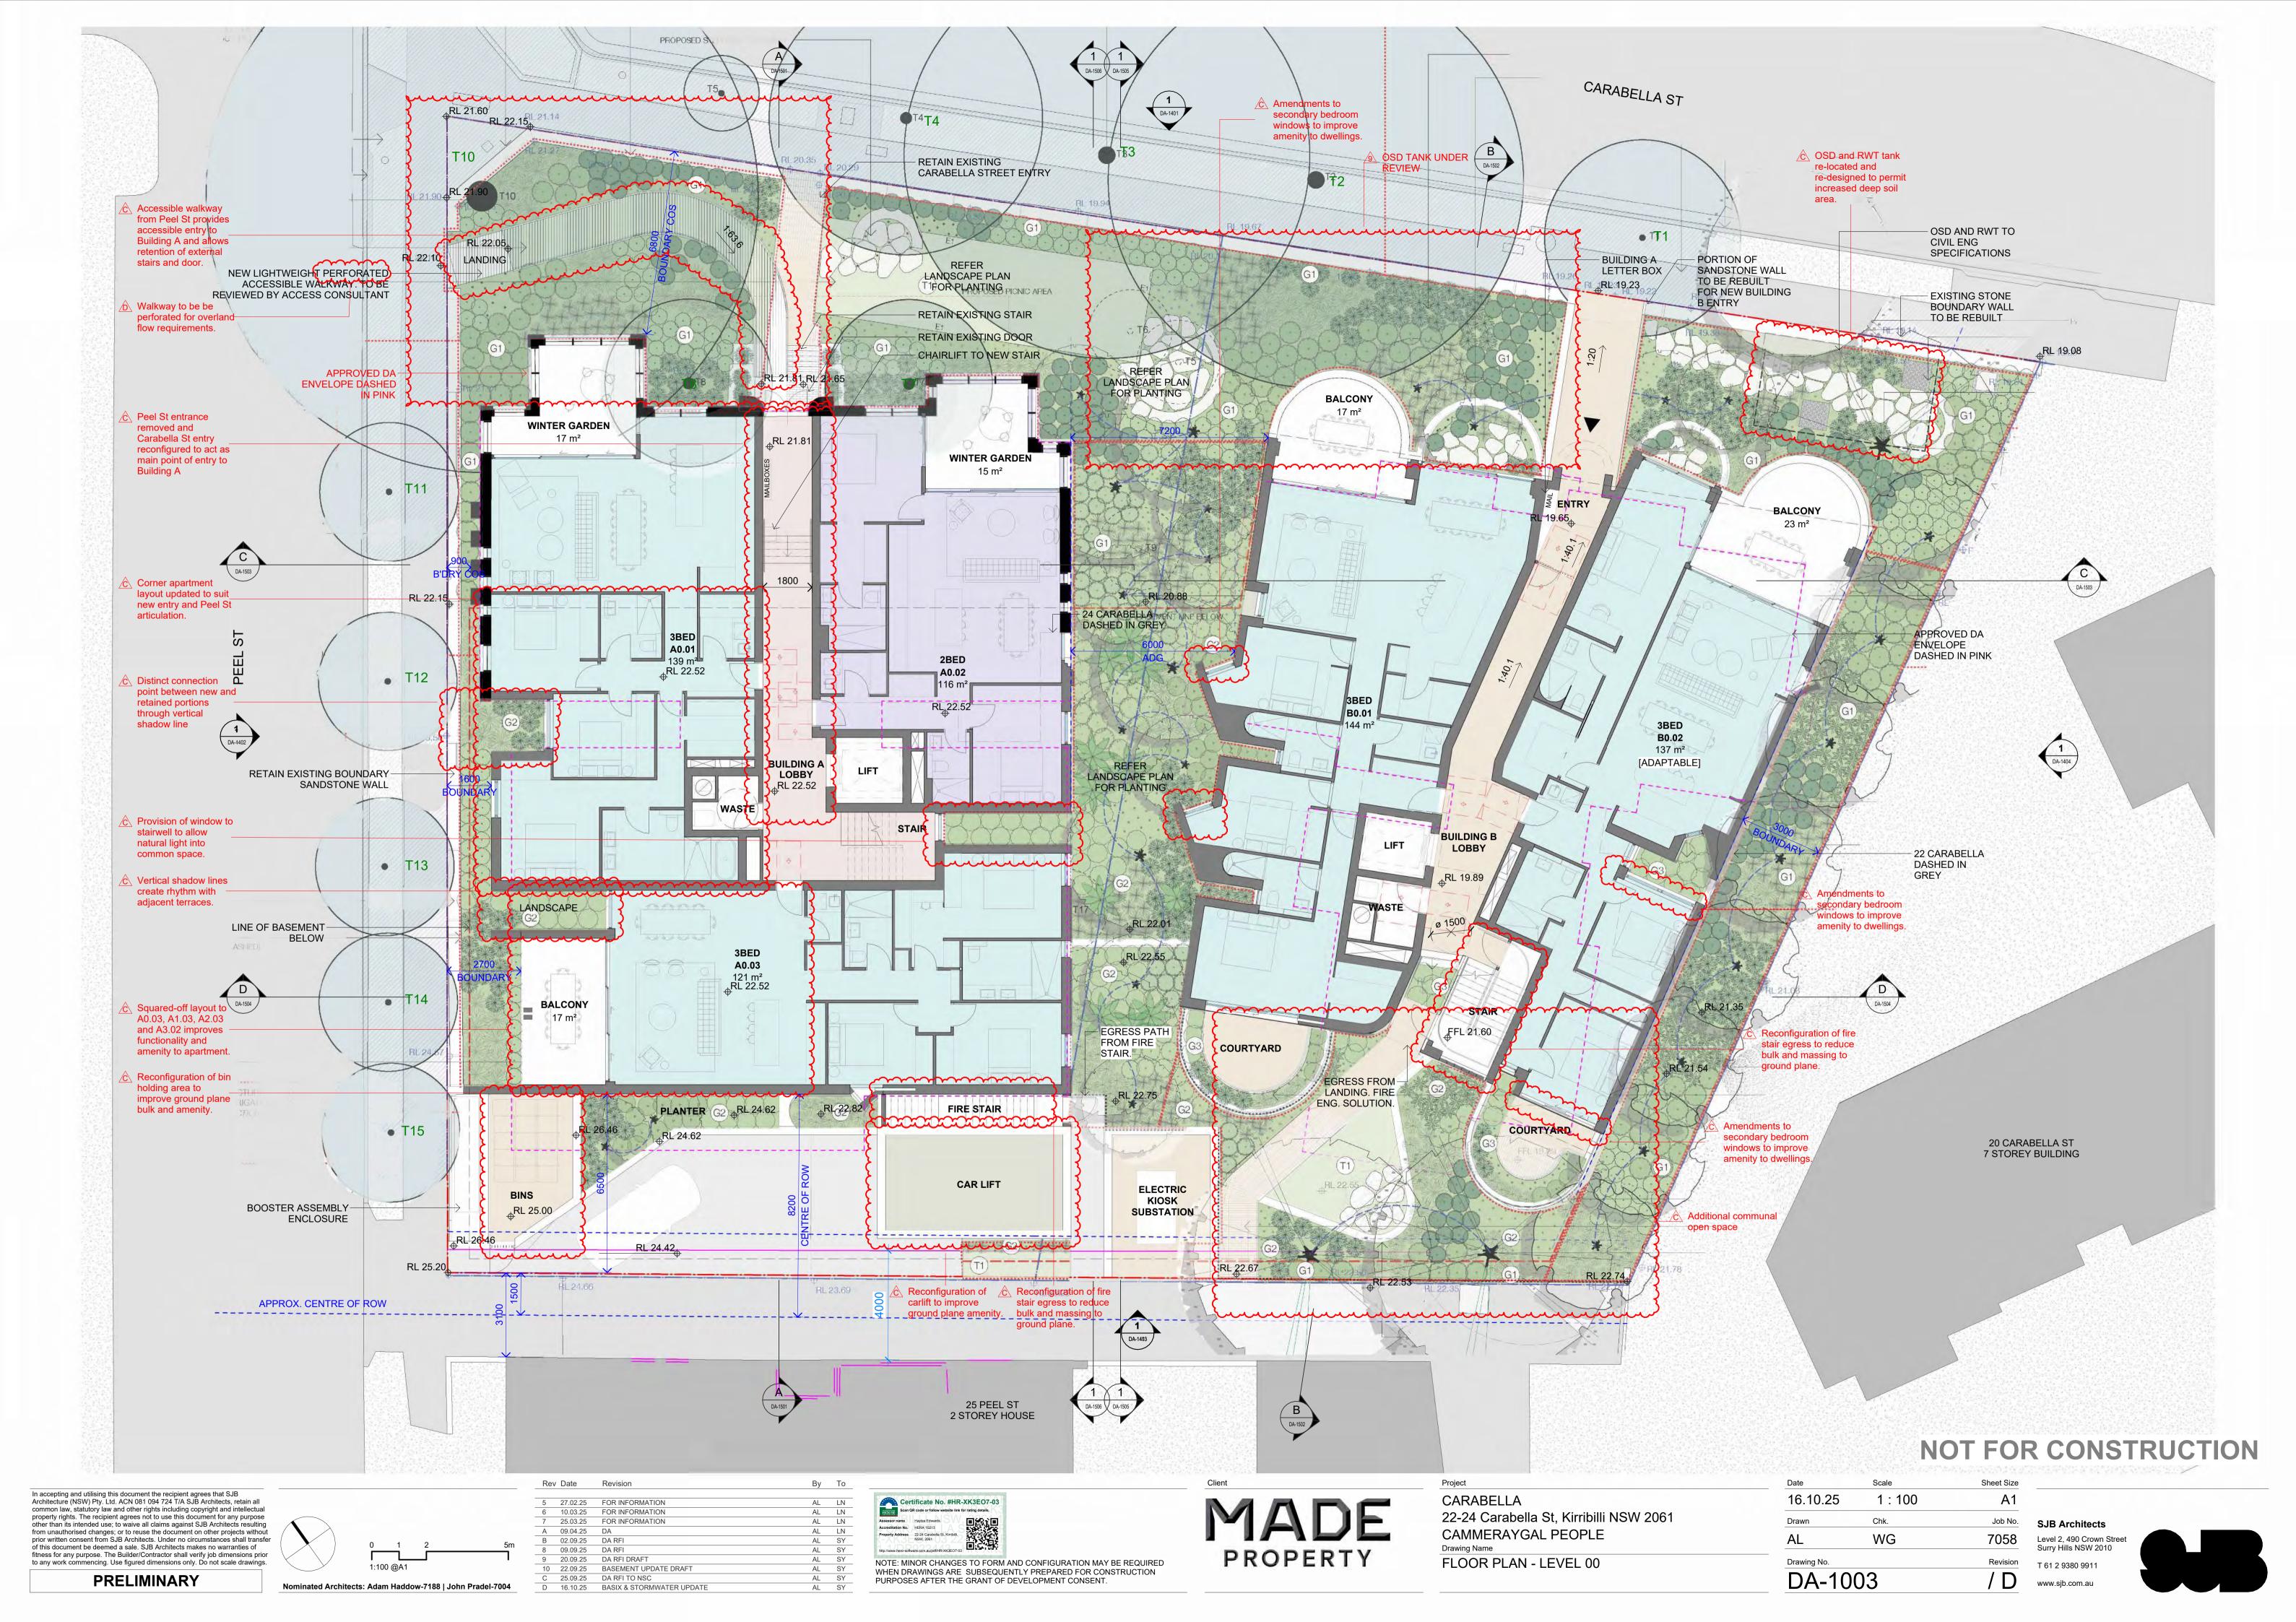


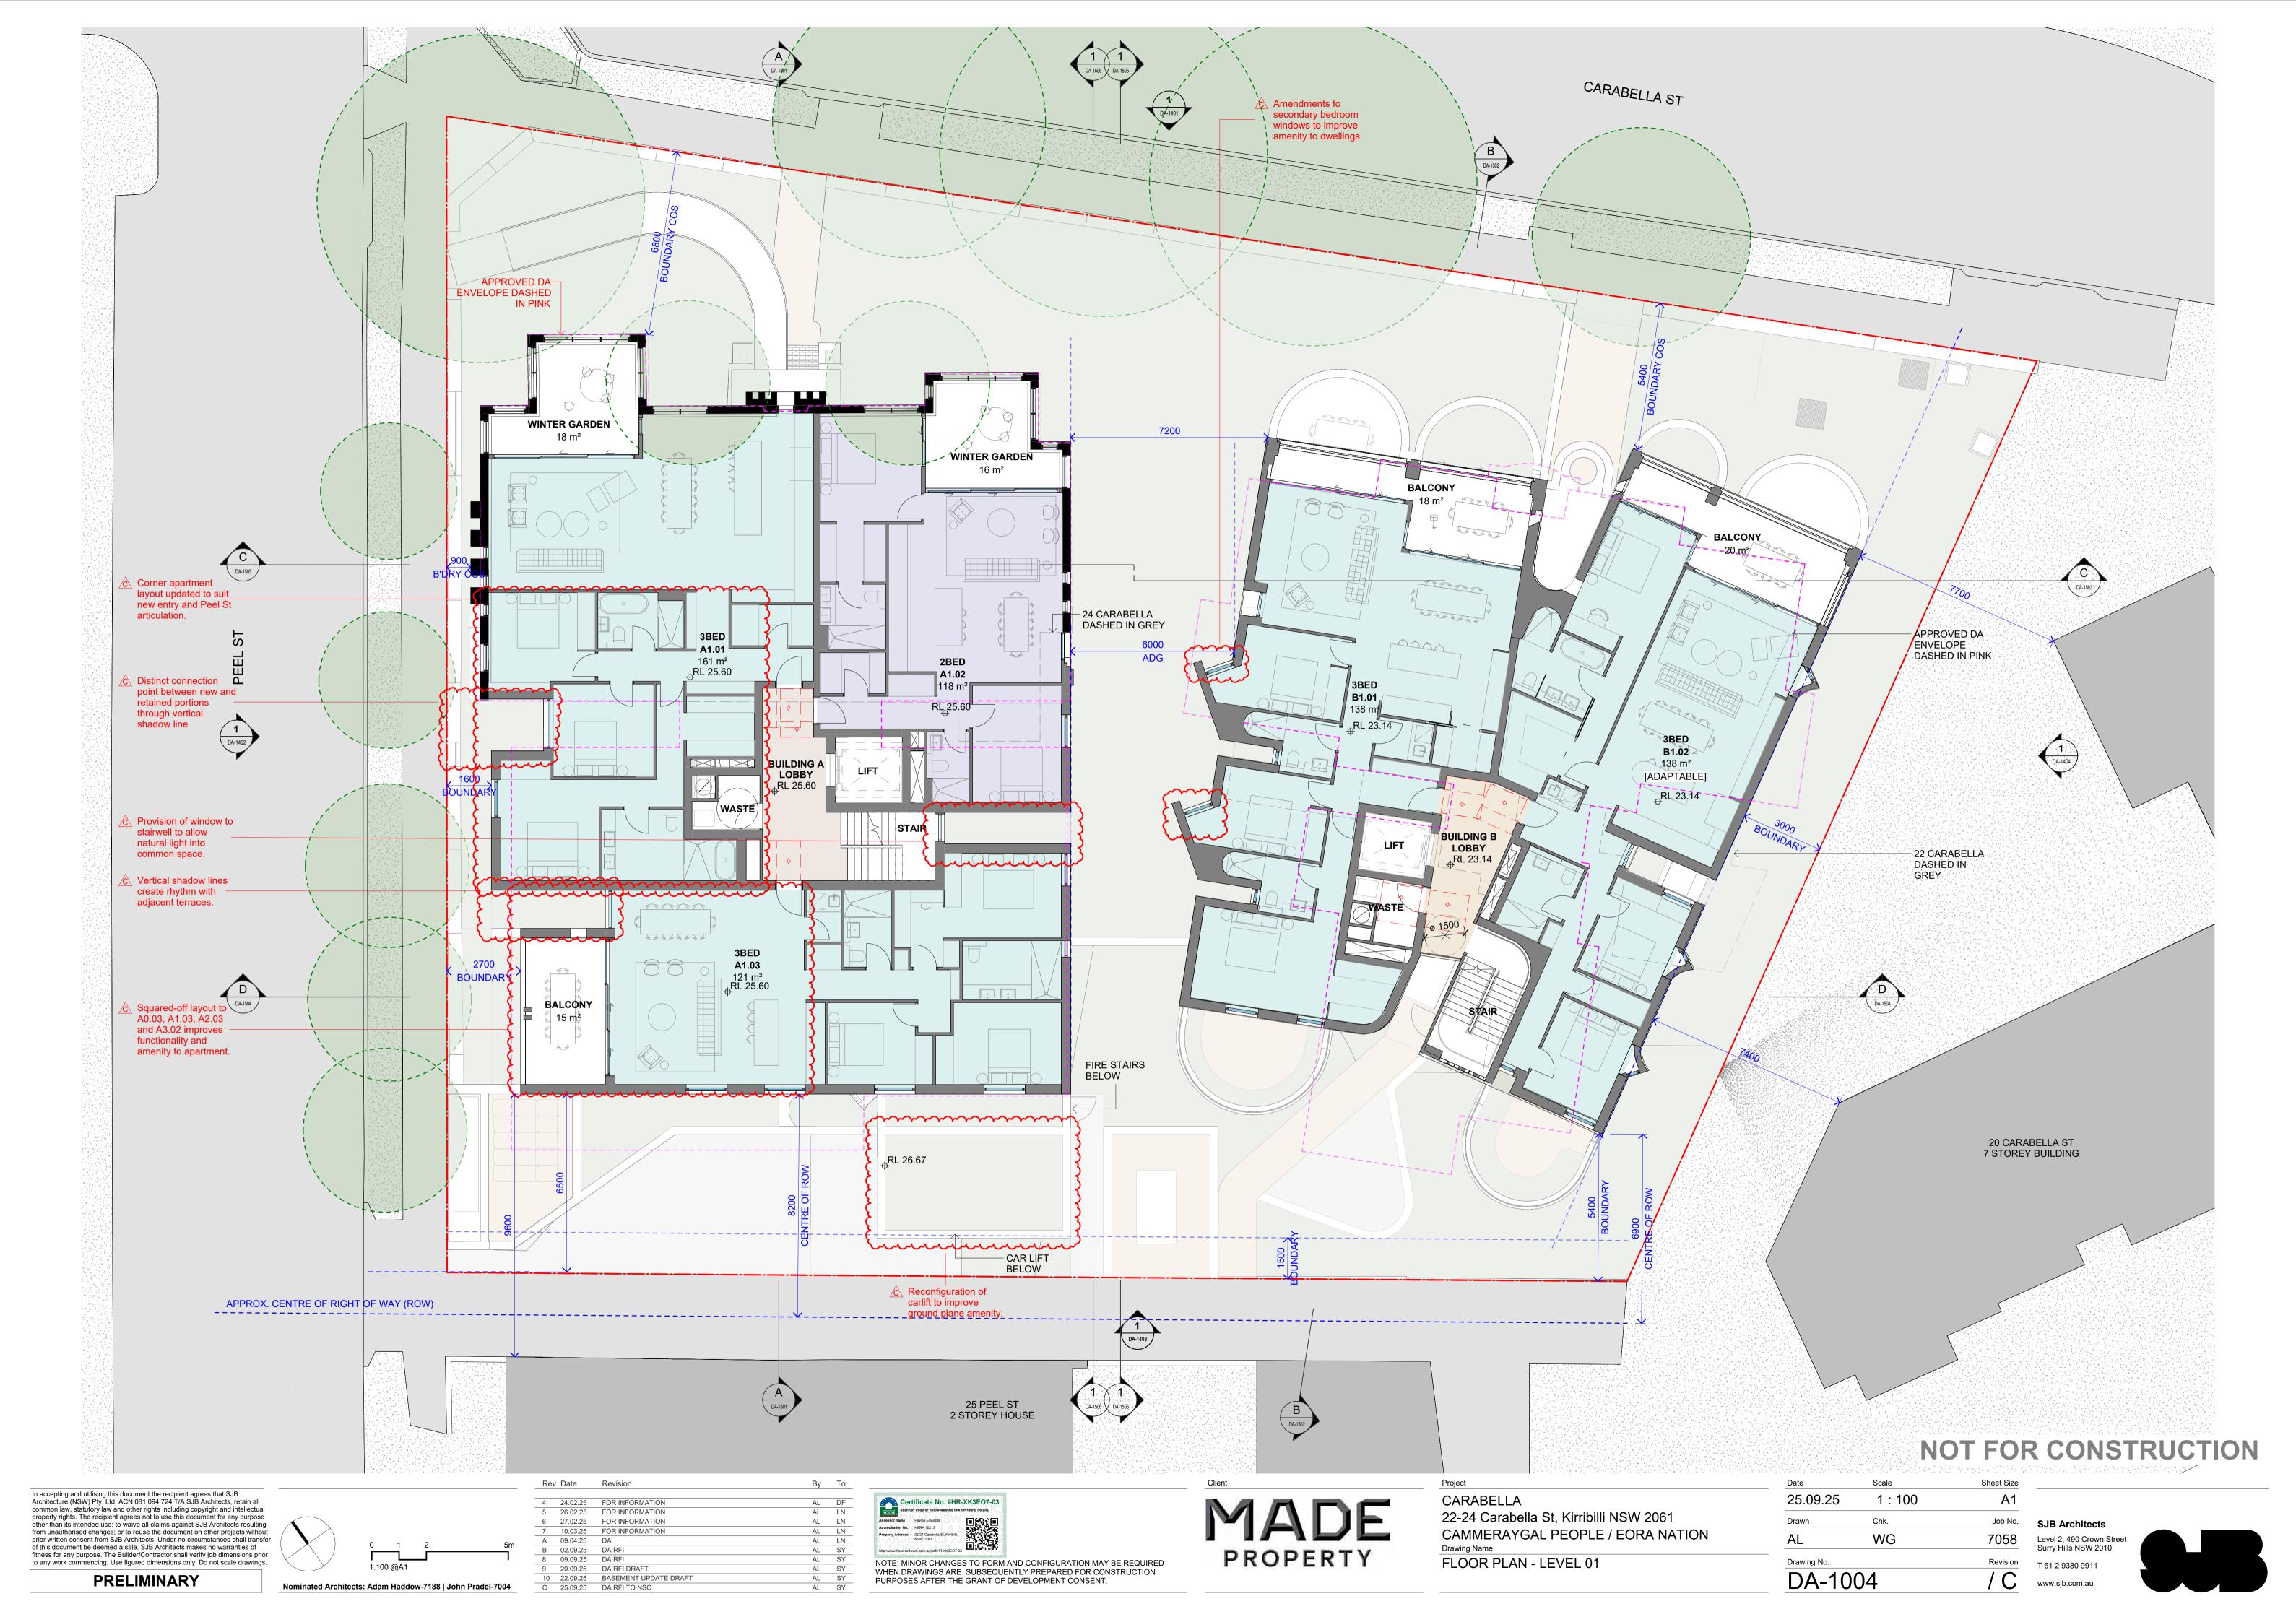


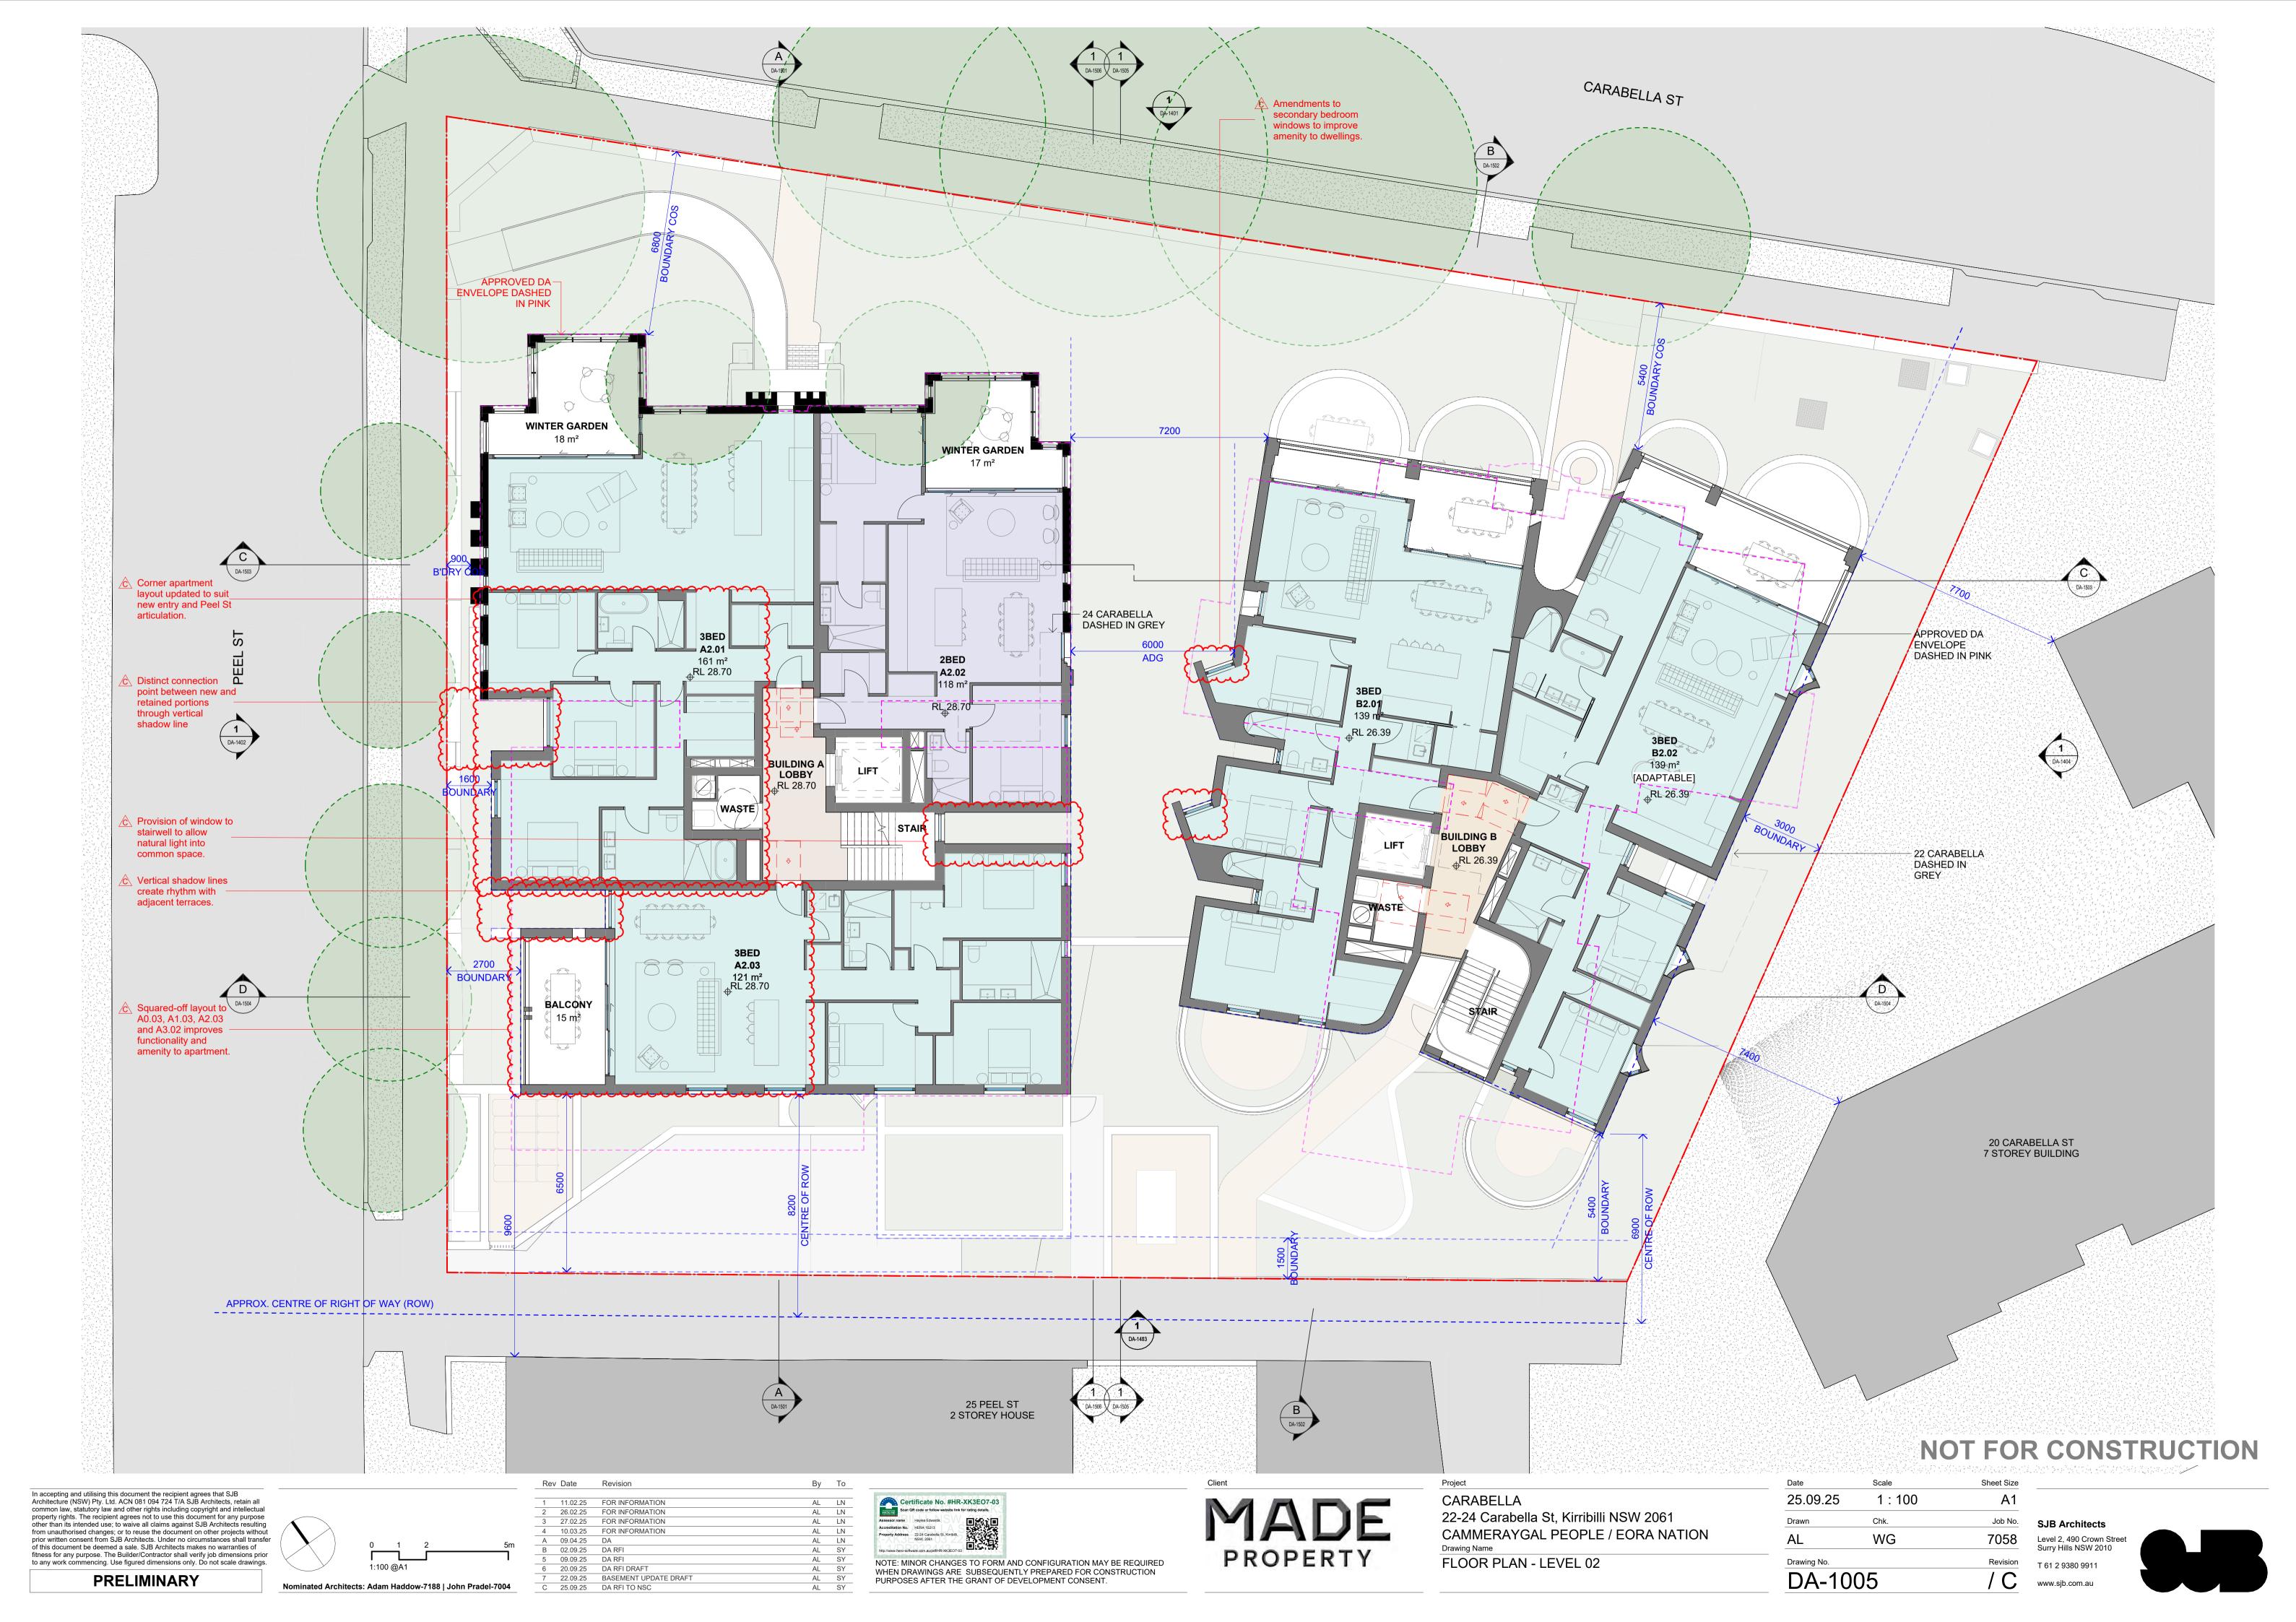

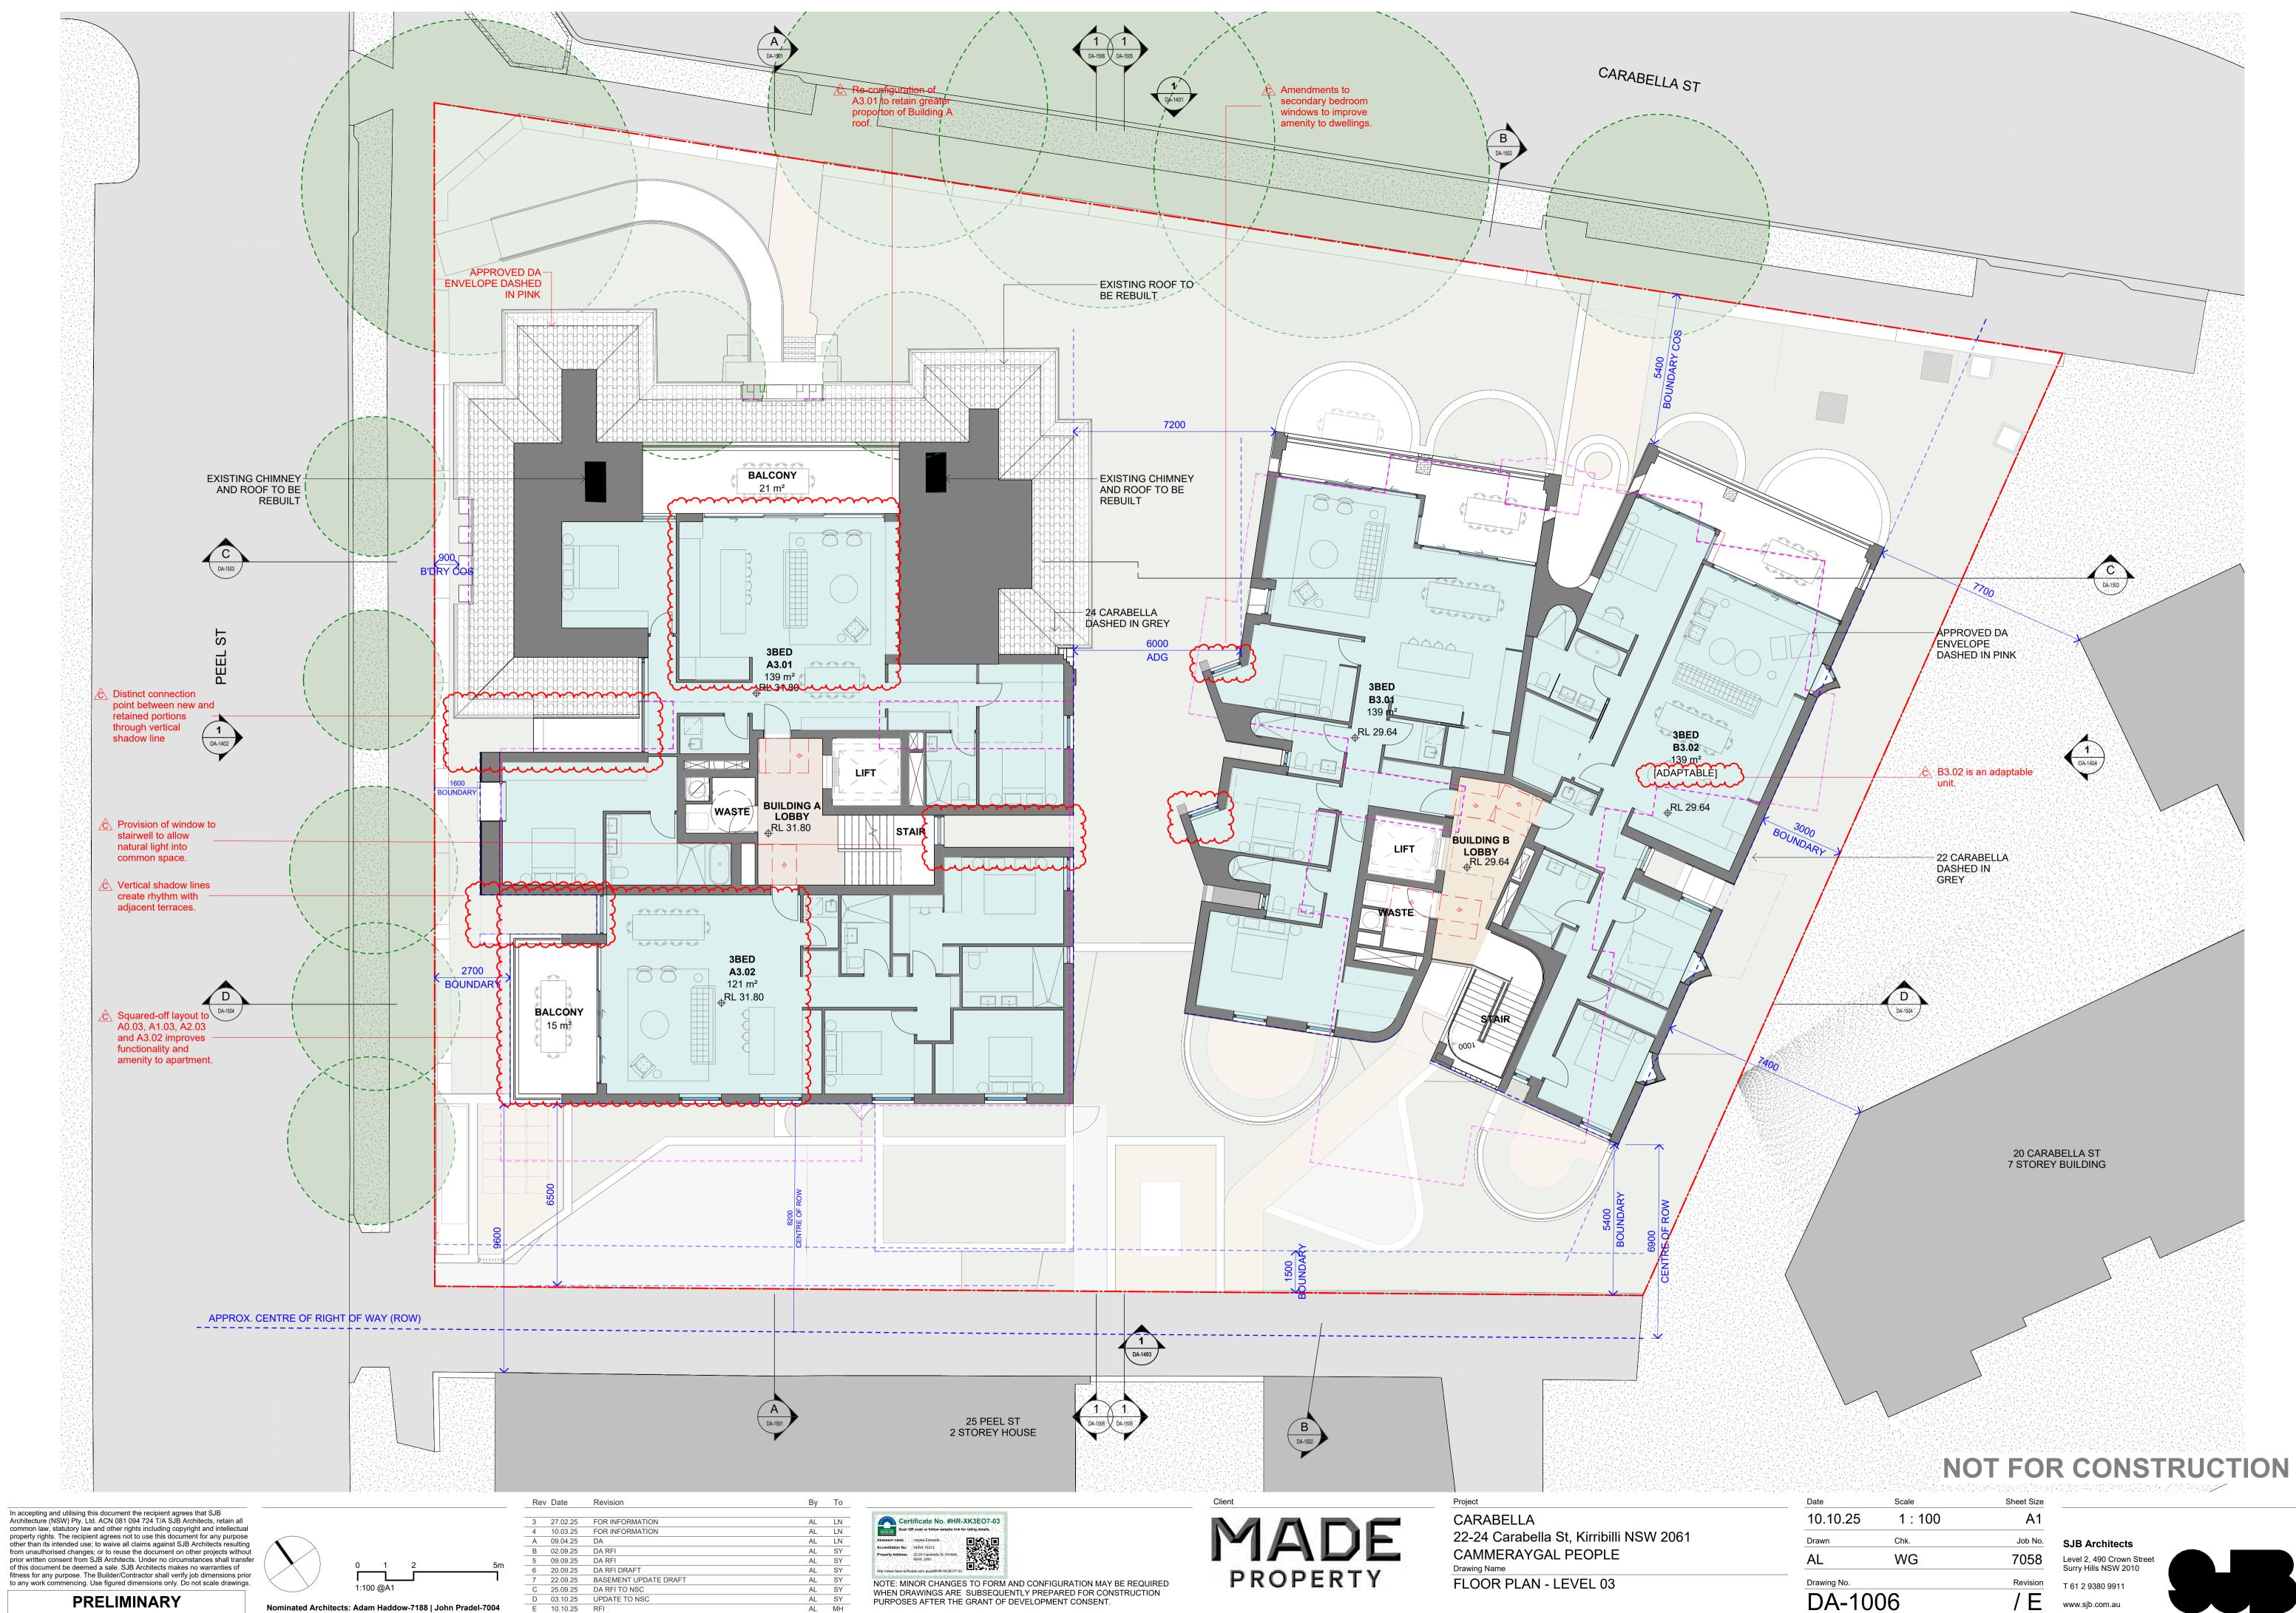

DA-1006

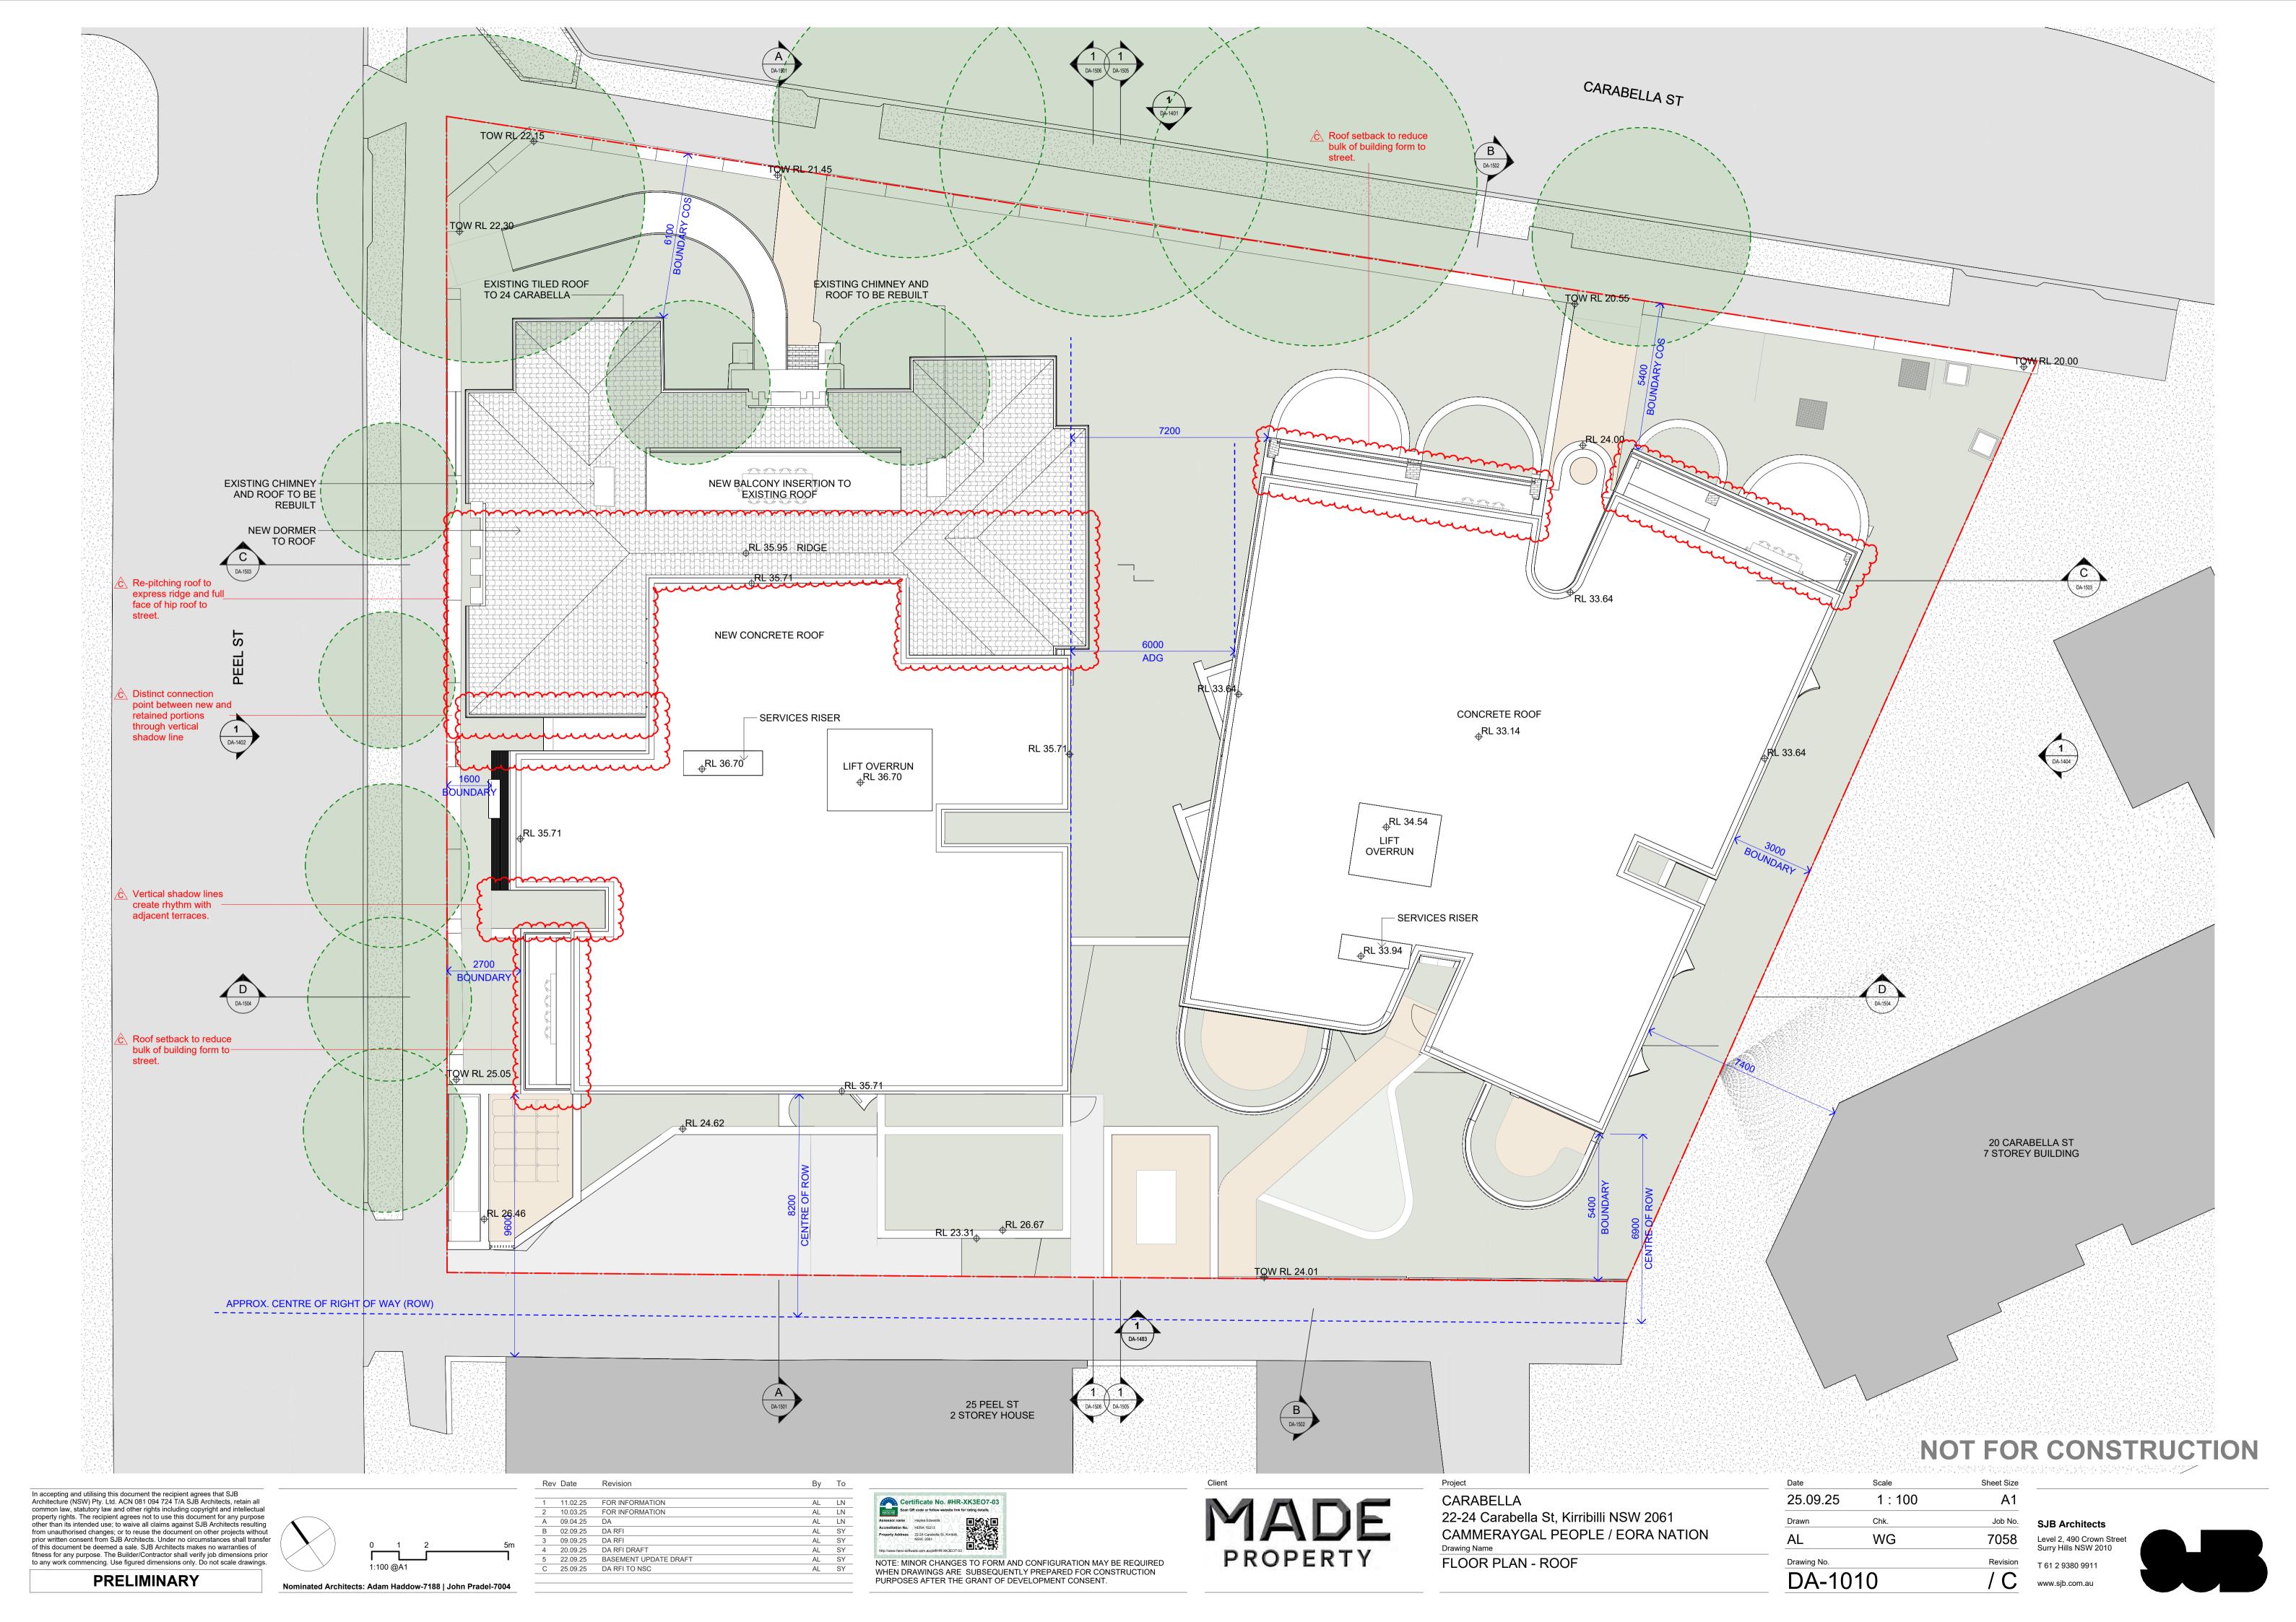

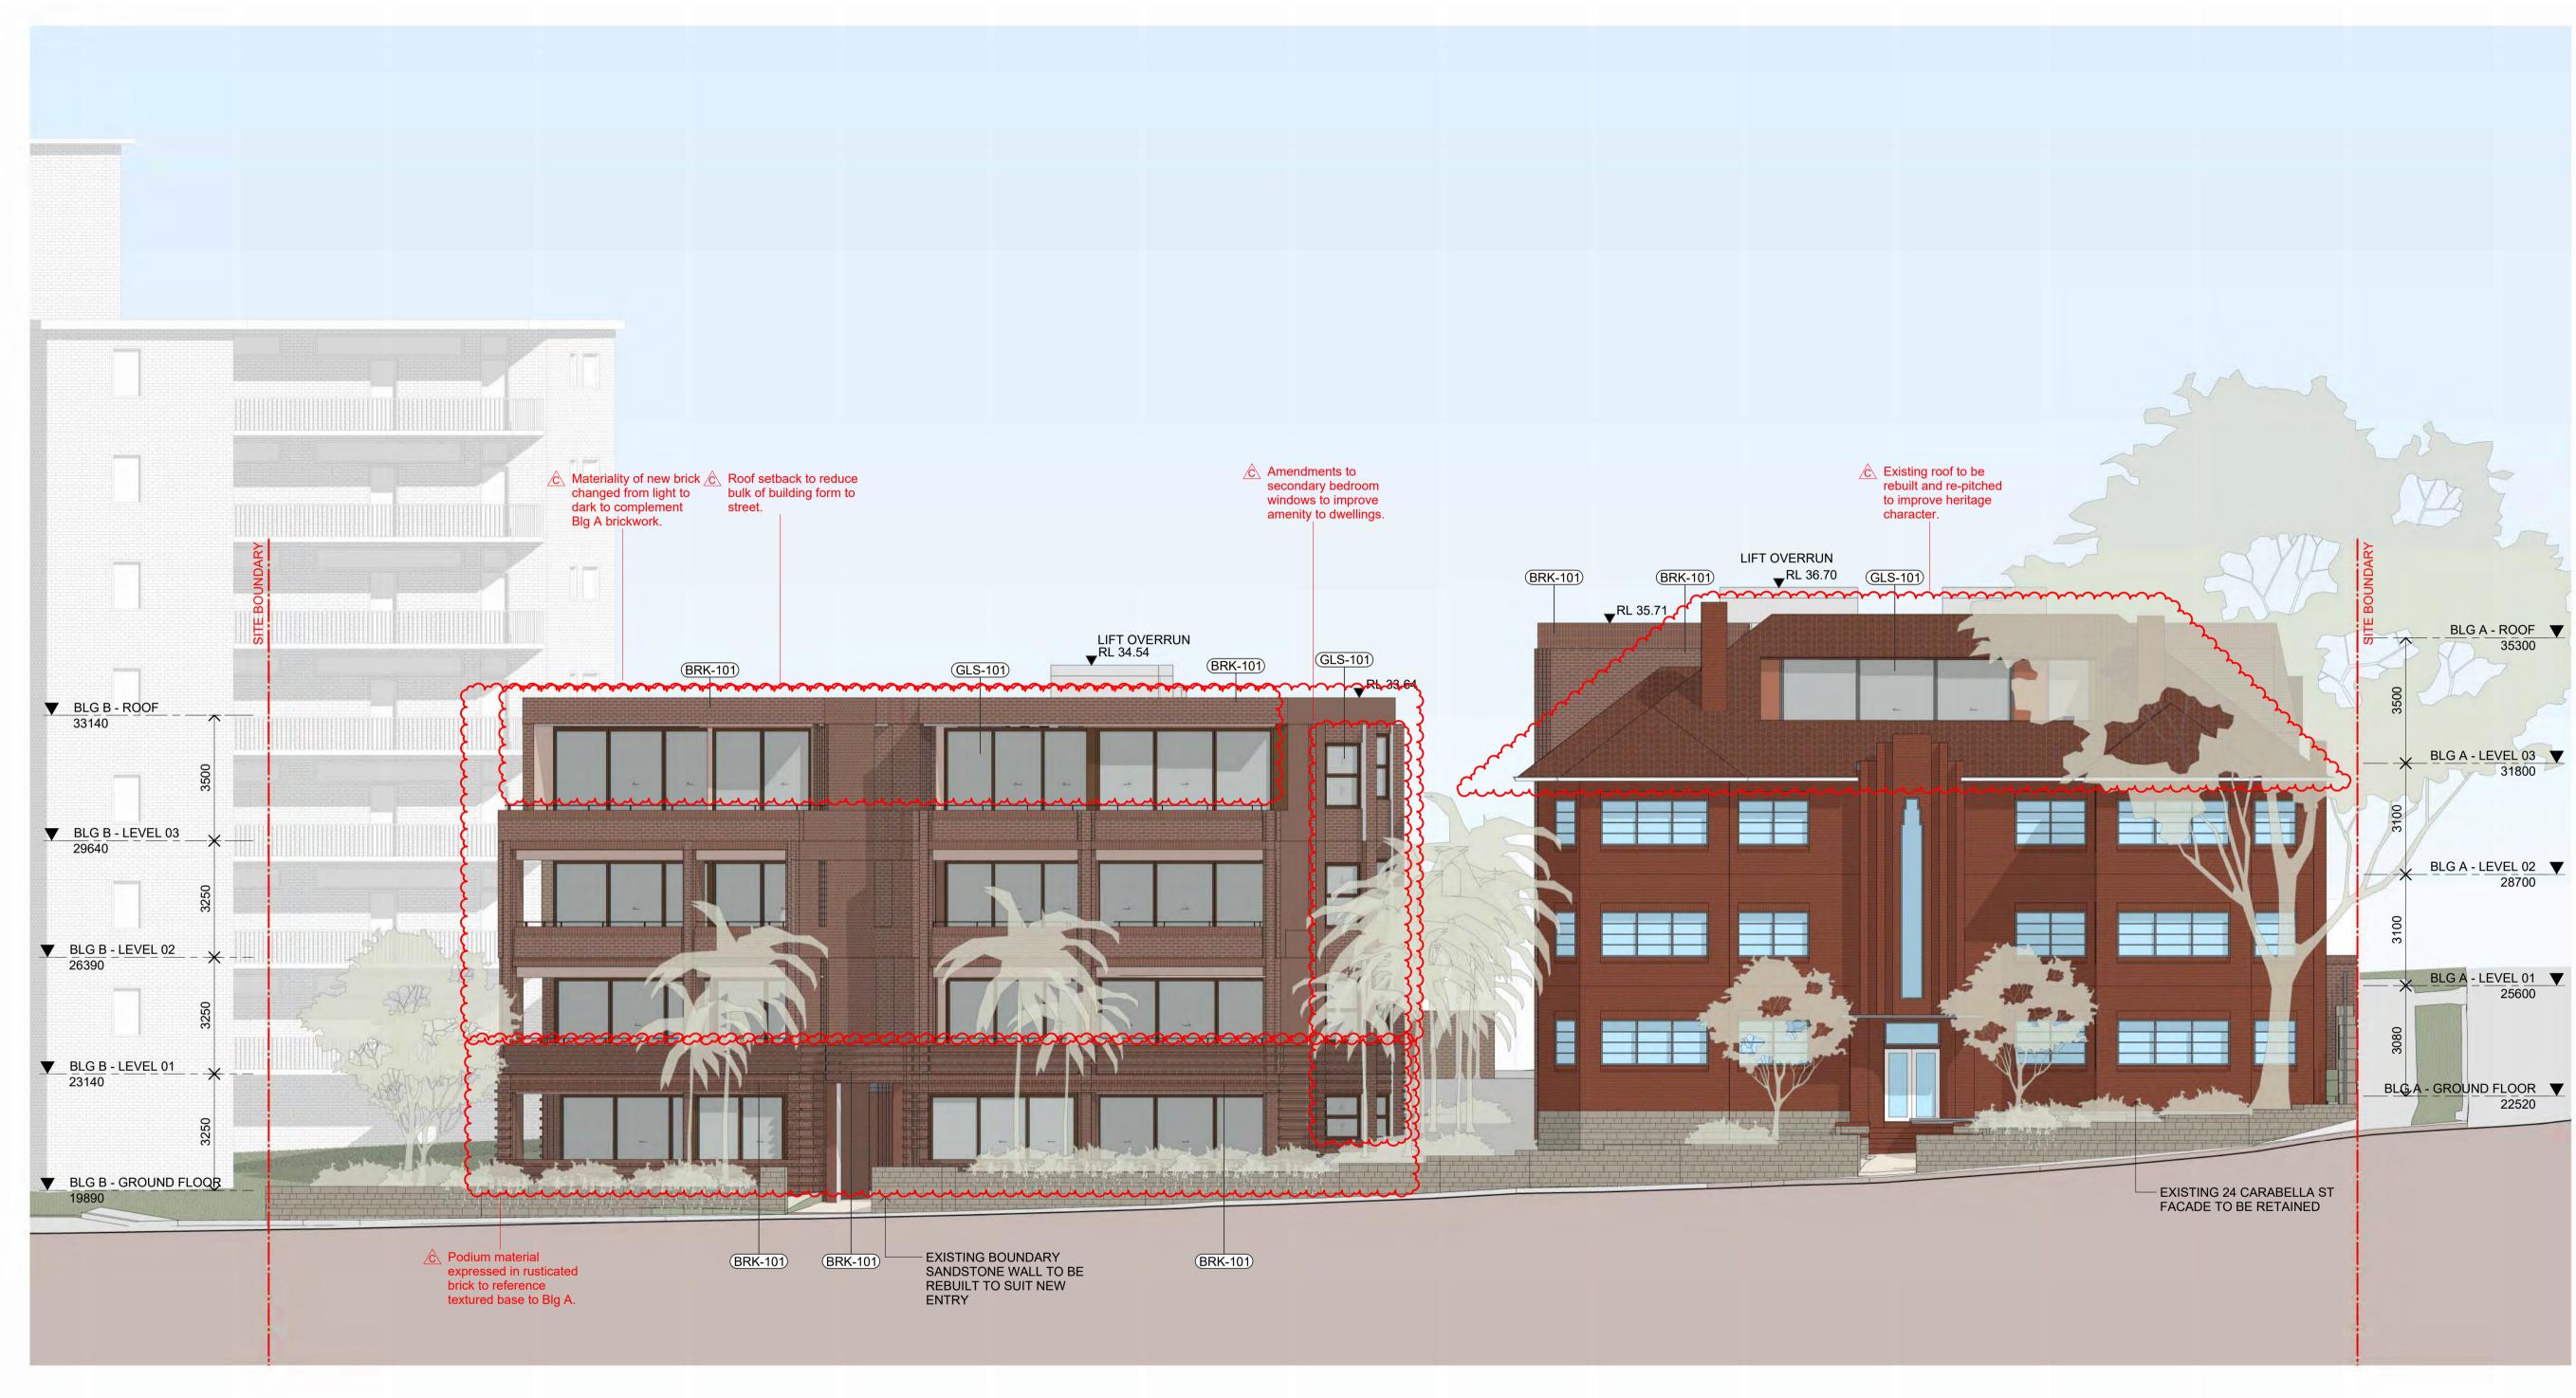



In accepting and utilising this document the recipient agrees that SJB Architecture (NSW) Pty. Ltd. ACN 081 094 724 T/A SJB Architects, retain all common law, statutory law and other rights including copyright and intellectual property rights. The recipient agrees not to use this document for any purpose other than its intended use; to waive all claims against SJB Architects resulting from unauthorised changes; or to reuse the document on other projects without prior written consent from SJB Architects. Under no circumstances shall transfer of this document be deemed a sale. SJB Architects makes no warranties of fitness for any purpose. The Builder/Contractor shall verify job dimensions prior to any work commencing. Use figured dimensions only. Do not scale drawings.

PRELIMINARY

0 1 2 5m 1:100 @A1

 Rev Date
 Revision
 By T

 1
 24.02.25
 FOR INFORMATION
 AL
 D

 2
 26.02.25
 FOR INFORMATION
 AL
 L

 3
 10.03.25
 FOR INFORMATION
 AL
 L

 A
 09.04.25
 DA
 AL
 L

 B
 02.09.25
 DA RFI
 AL
 S

 4
 09.09.25
 DA RFI
 AL
 S

 5
 20.09.25
 DA RFI DRAFT
 AL
 S

 C
 25.09.25
 DA RFI TO NSC
 AL
 S






CARABELLA
22-24 Carabella St, Kirribilli NSW 2061
CAMMERAYGAL PEOPLE / EORA NATION
Drawing Name
ELEVATIONS - NORTH EAST

Data	0 1	01
Date	Scale	Sheet Size
25.09.25	1 : 100	A1
Drawn	Chk.	Job No.
AL	WG	7058
Drawing No.	Revision	
DA-14	/ C	



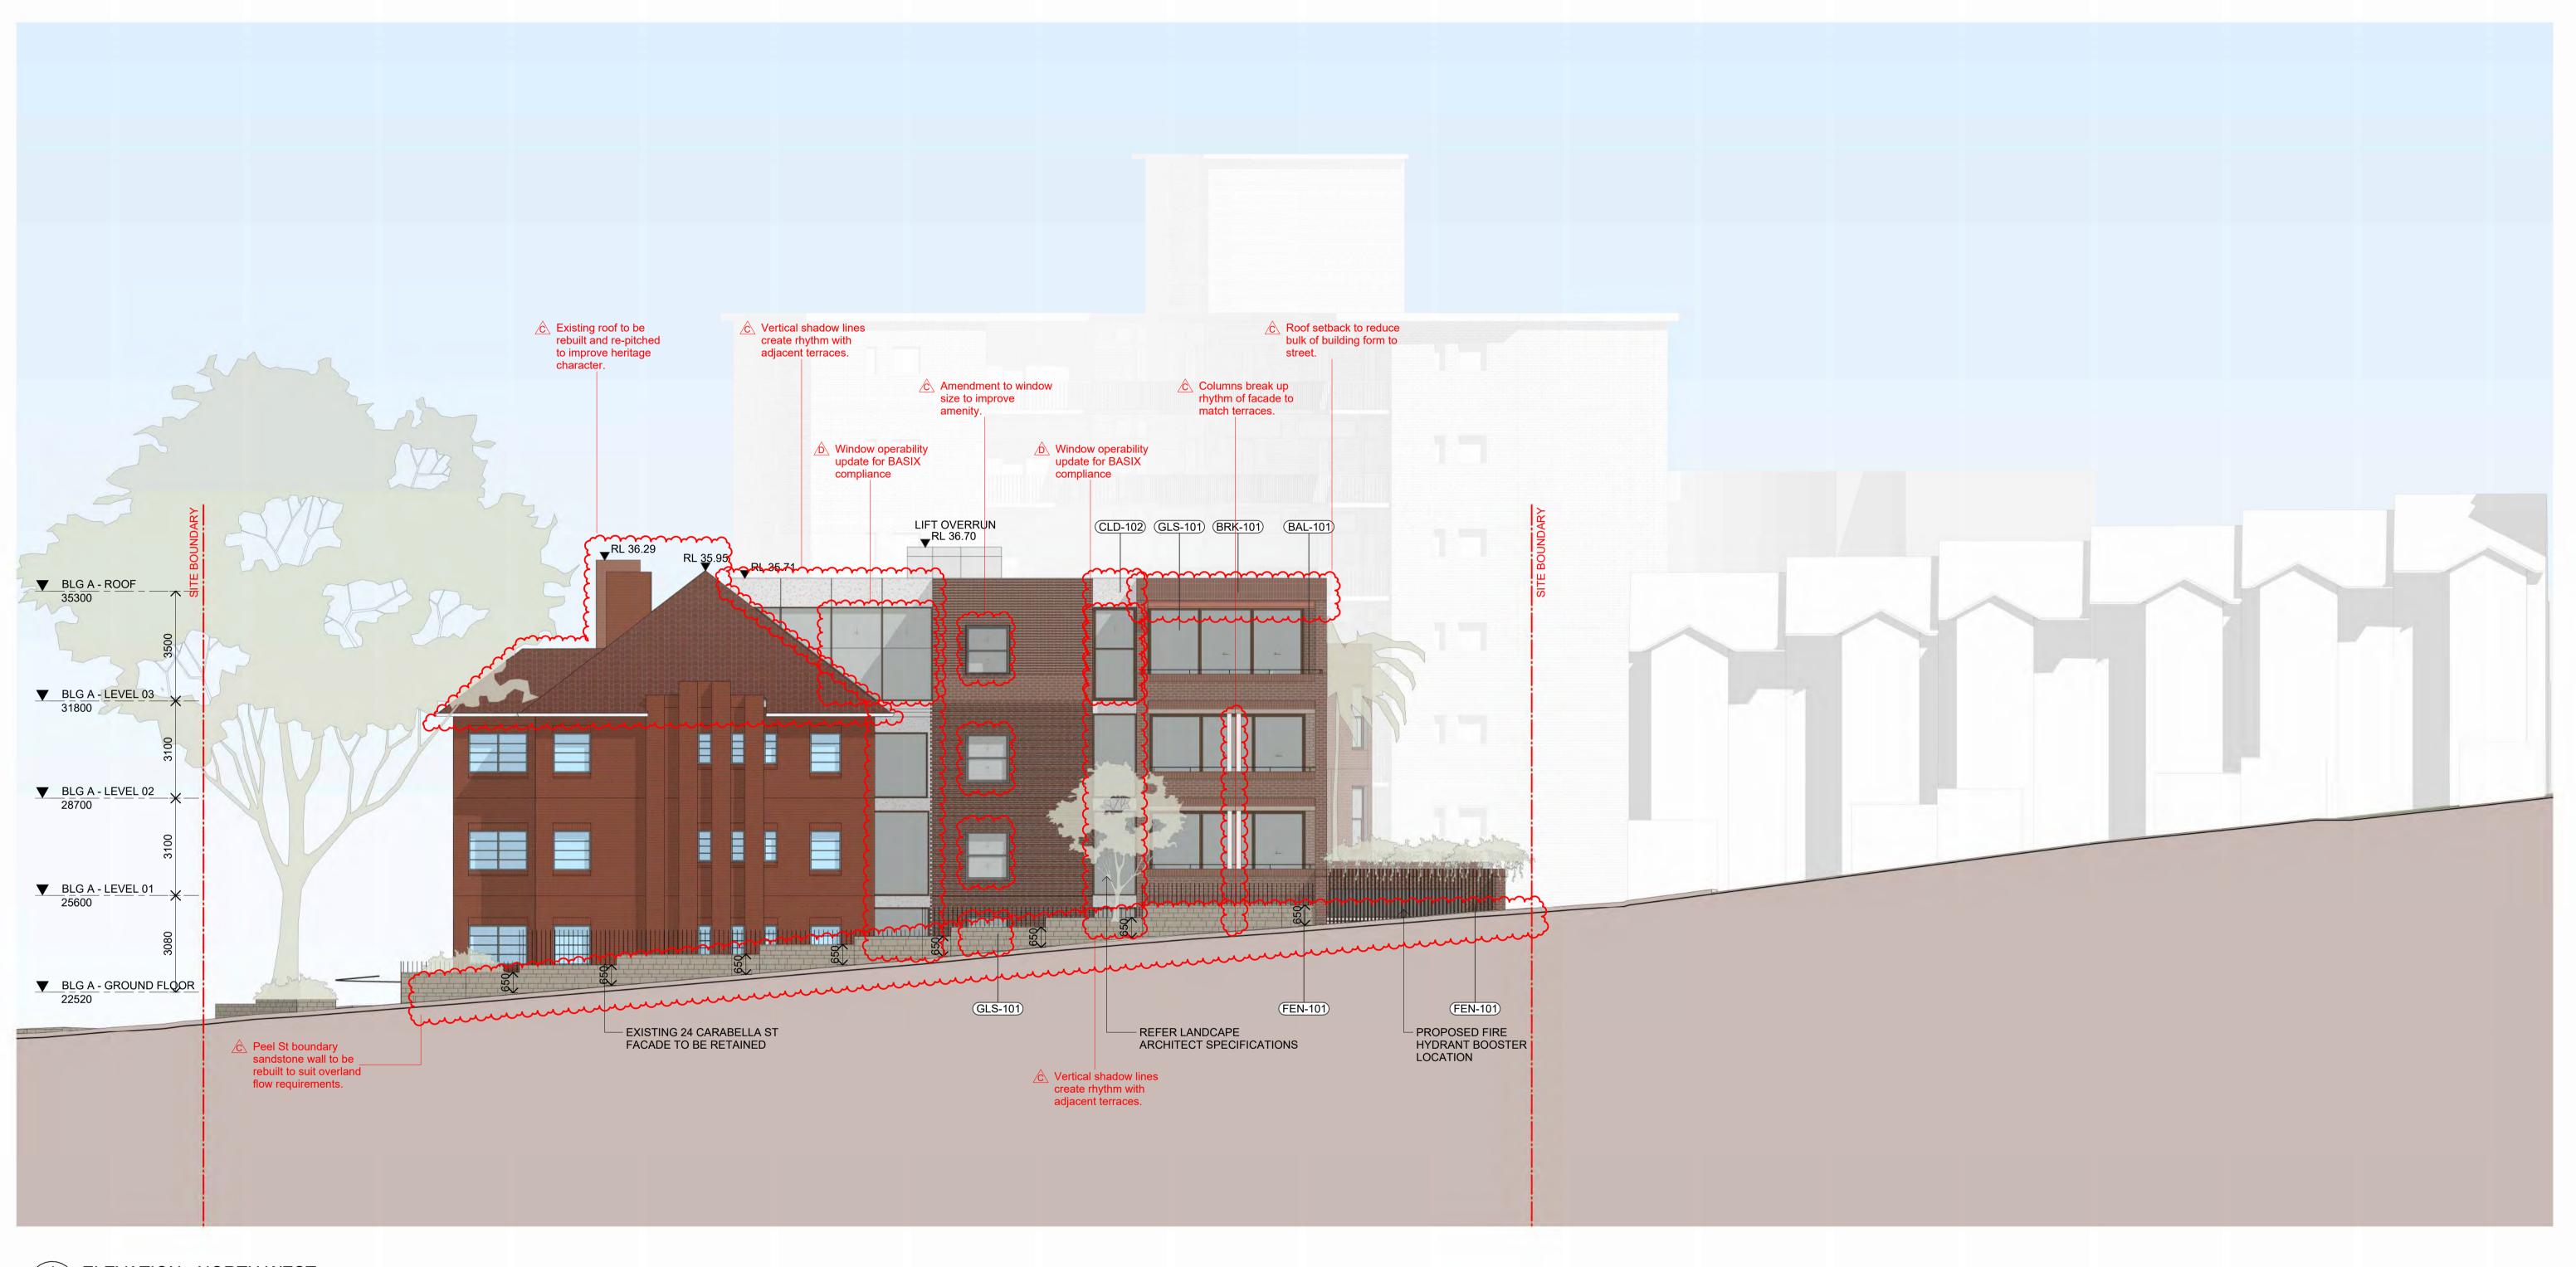

1 ELEVATION - NORTH WEST

DA-1001 SCALE 1:100

NOT FOR CONSTRUCTION

In accepting and utilising this document the recipient agrees that SJB Architecture (NSW) Pty. Ltd. ACN 081 094 724 T/A SJB Architects, retain all common law, statutory law and other rights including copyright and intellectual property rights. The recipient agrees not to use this document for any purpose other than its intended use; to waive all claims against SJB Architects resulting from unauthorised changes; or to reuse the document on other projects without prior written consent from SJB Architects. Under no circumstances shall transfer of this document be deemed a sale. SJB Architects makes no warranties of fitness for any purpose. The Builder/Contractor shall verify job dimensions prior to any work commencing. Use figured dimensions only. Do not scale drawings.

PRELIMINARY

0 1 2 5m 1:100 @A1

Nominated Architects: Adam Haddow-7188 | John Pradel-7004

 Rev Date
 Revision
 By T

 1
 24.02.25
 FOR INFORMATION
 AL
 D

 2
 26.02.25
 FOR INFORMATION
 AL
 L

 3
 10.03.25
 FOR INFORMATION
 AL
 L

 A
 09.04.25
 DA
 AL
 L

 B
 02.09.25
 DA RFI
 AL
 S

 4
 09.09.25
 DA RFI
 AL
 S

 5
 20.09.25
 DA RFI DRAFT
 AL
 S

 C
 25.09.25
 DA RFI TO NSC
 AL
 S

 D
 16.10.25
 BASIX & STORMWATER UPDATE
 AL
 S






Project
CARABELLA
22-24 Carabella St, Kirribilli NSW 2061
CAMMERAYGAL PEOPLE
Drawing Name
ELEVATIONS - NORTH WEST

Date	Scale	Sheet Size
16.10.25	1 : 100	A1
Drawn	Chk.	Job No.
AL	WG	7058
Drawing No.	Revision	
DA-14	/ D	



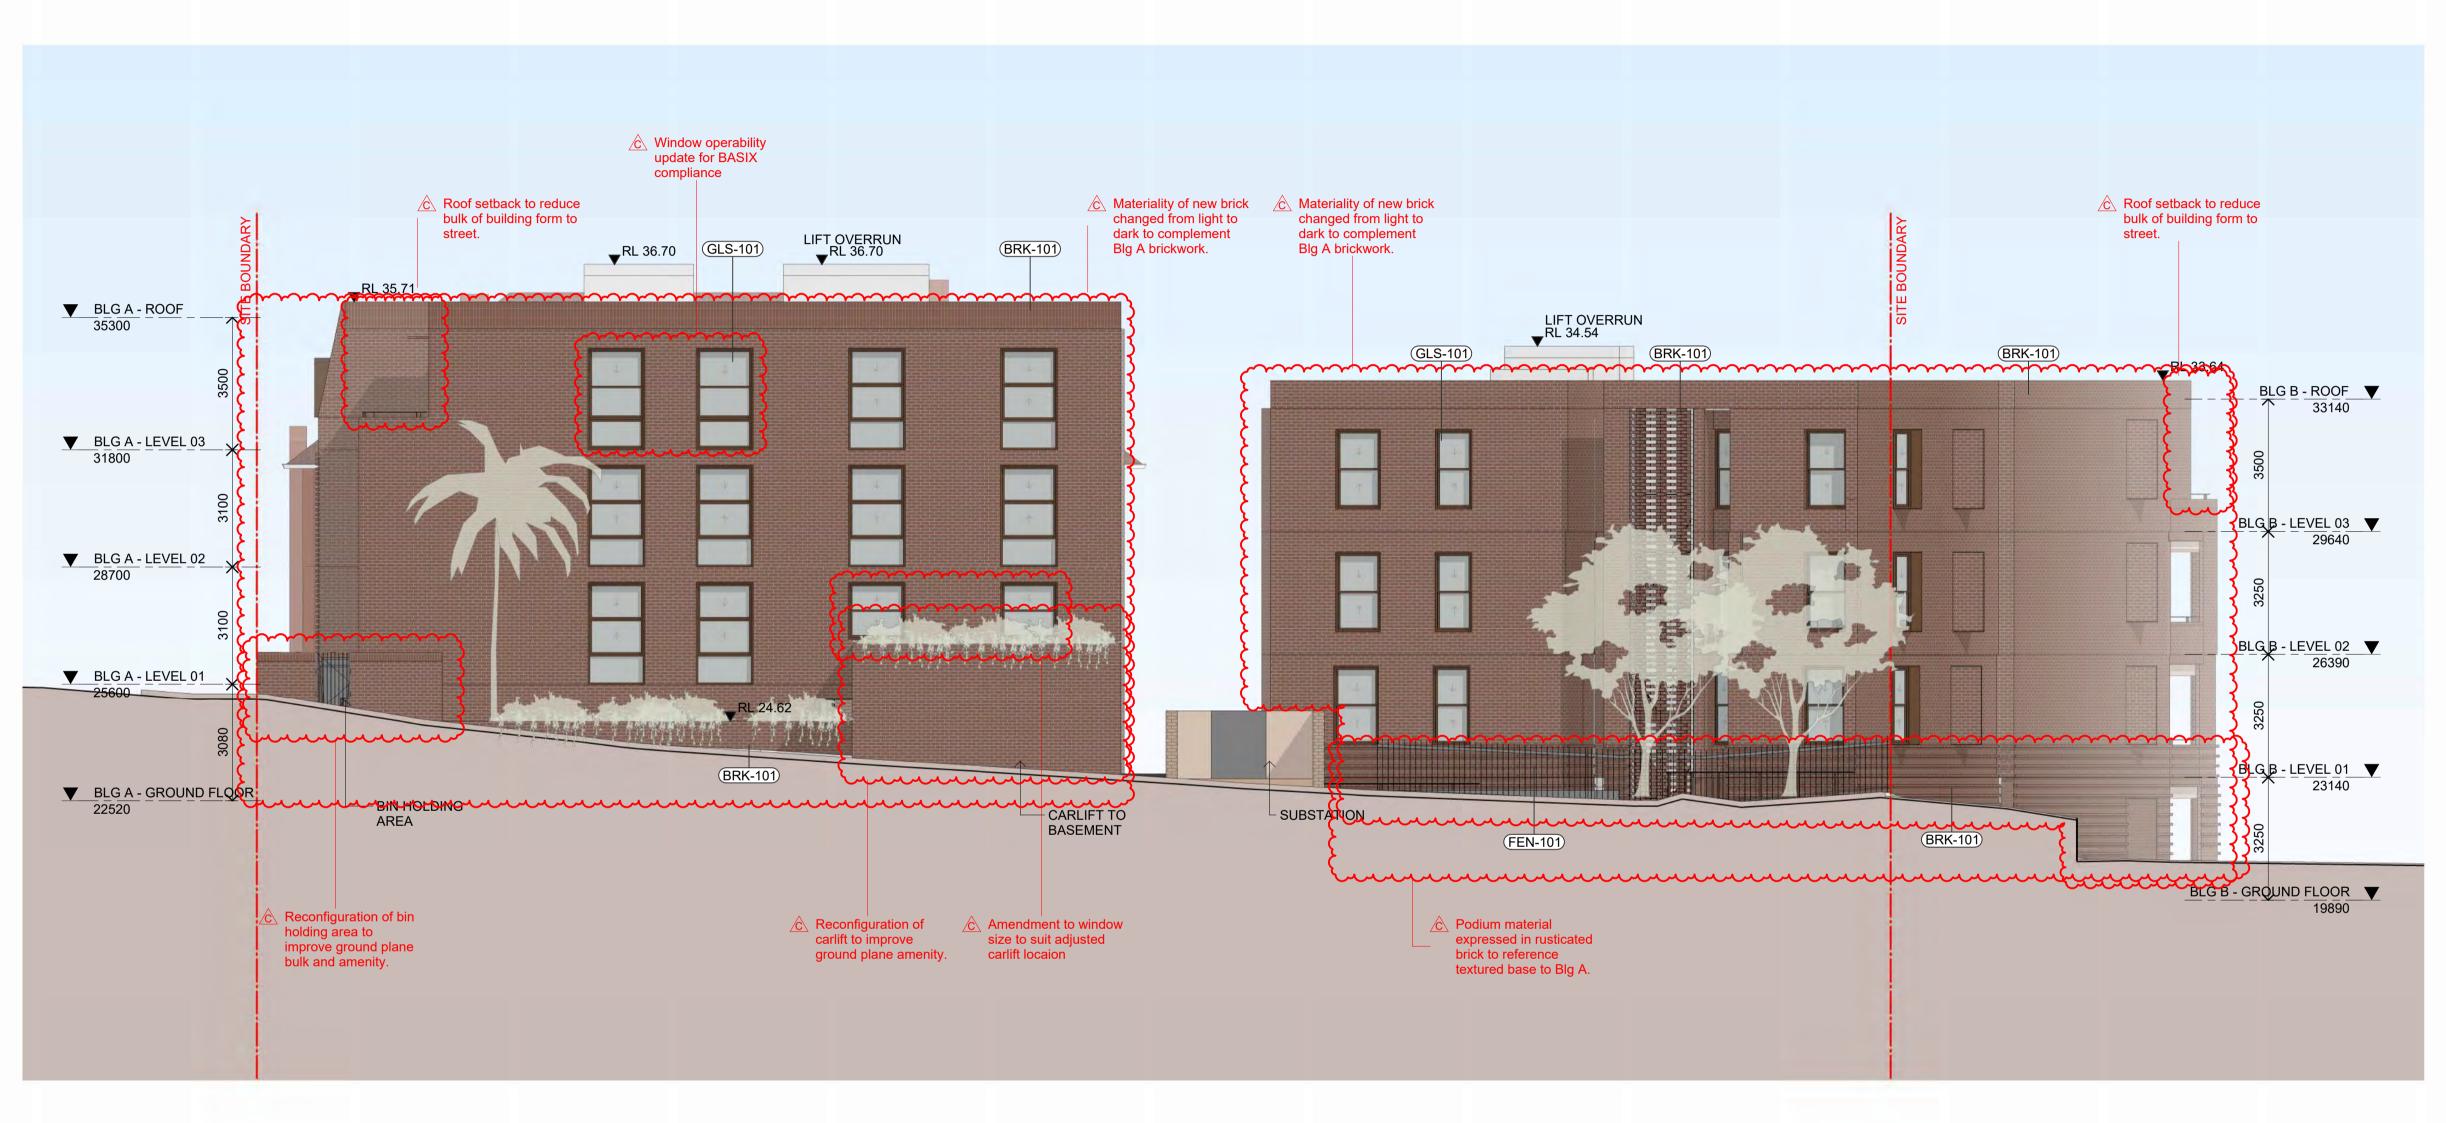

1 ELEVATION - SOUTH WEST SCALE 1:100


NOT FOR CONSTRUCTION

In accepting and utilising this document the recipient agrees that SJB Architecture (NSW) Pty. Ltd. ACN 081 094 724 T/A SJB Architects, retain all common law, statutory law and other rights including copyright and intellectual property rights. The recipient agrees not to use this document for any purpose other than its intended use; to waive all claims against SJB Architects resulting from unauthorised changes; or to reuse the document on other projects without prior written consent from SJB Architects. Under no circumstances shall transfer of this document be deemed a sale. SJB Architects makes no warranties of fitness for any purpose. The Builder/Contractor shall verify job dimensions prior to any work commencing. Use figured dimensions only. Do not scale drawings.

PRELIMINARY

0 1 2 5m
1:100 @A1

Nominated Architects: Adam Haddow-7188 | John Pradel-7004

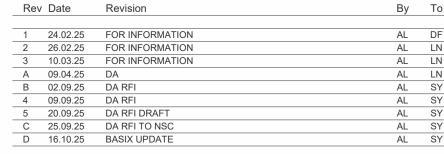






Project
CARABELLA
22-24 Carabella St, Kirribilli NSW 2061
CAMMERAYGAL PEOPLE
Drawing Name
ELEVATIONS - SOUTH WEST

Date	Scale	Sheet Size
16.10.25	1 : 100	A1
Drawn	Chk.	Job No.
AL	WG	7058
Drawing No.	Revision	
DA-1403		/ D



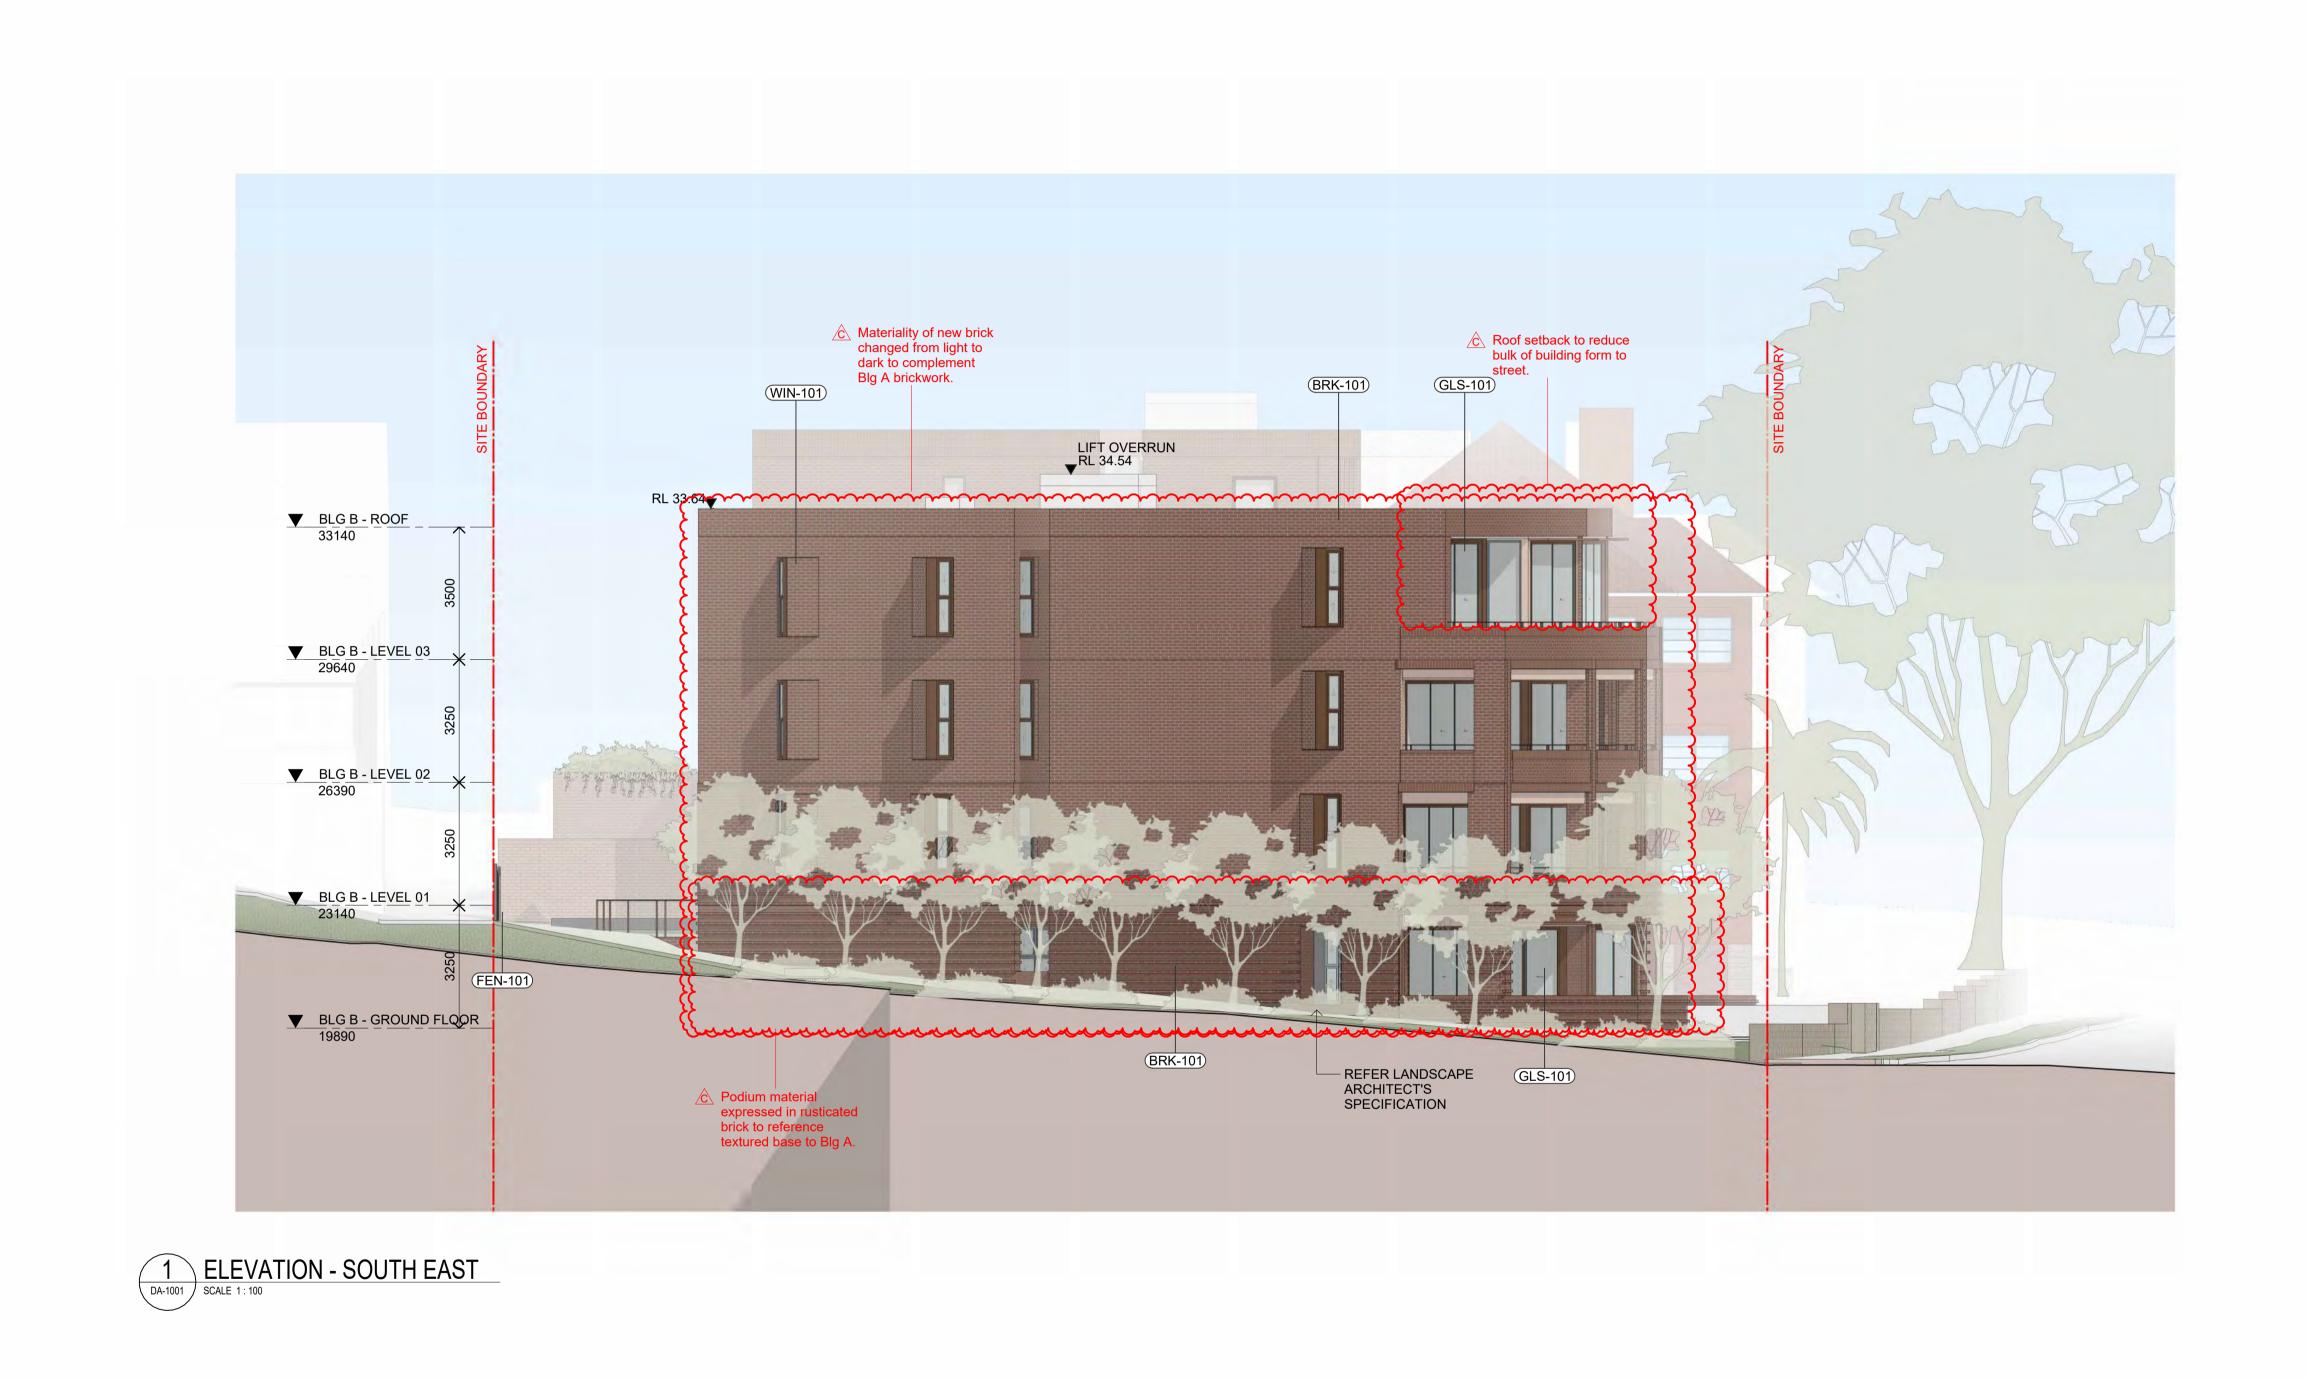


In accepting and utilising this document the recipient agrees that SJB Architecture (NSW) Pty. Ltd. ACN 081 094 724 T/A SJB Architects, retain all common law, statutory law and other rights including copyright and intellectual property rights. The recipient agrees not to use this document for any purpose other than its intended use; to waive all claims against SJB Architects resulting from unauthorised changes; or to reuse the document on other projects without prior written consent from SJB Architects. Under no circumstances shall transfer of this document be deemed a sale. SJB Architects makes no warranties of fitness for any purpose. The Builder/Contractor shall verify job dimensions prior to any work commencing. Use figured dimensions only. Do not scale drawings.

PRELIMINARY

0 1 2 5m 1:100 @A1

Nominated Architects: Adam Haddow-7188 | John Pradel-7004

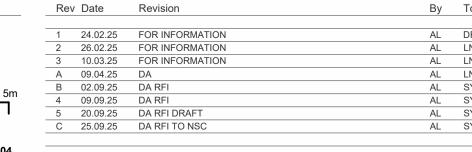





Project
CARABELLA
22-24 Carabella St, Kirribilli NSW 2061
CAMMERAYGAL PEOPLE / EORA NATION
Drawing Name
ELEVATIONS - SOUTH EAST

Date	Scale	Sheet Size
25.09.25	1 : 100	A1
Drawn	Chk.	Job No.
AL	WG	7058
Drawing No.	Revision	
DA-1404		/ C





CARABELLA ST




PEEL ST

NOT FOR CONSTRUCTION

In accepting and utilising this document the recipient agrees that SJB Architecture (NSW) Pty. Ltd. ACN 081 094 724 T/A SJB Architects, retain all common law, statutory law and other rights including copyright and intellectual property rights. The recipient agrees not to use this document for any purpose other than its intended use; to waive all claims against SJB Architects resulting from unauthorised changes; or to reuse the document on other projects without prior written consent from SJB Architects. Under no circumstances shall transfer of this document be deemed a sale. SJB Architects makes no warranties of fitness for any purpose. The Builder/Contractor shall verify job dimensions prior to any work commencing. Use figured dimensions only. Do not scale drawings.

							_
							_
	0	1	2			5m	_
		\neg				7	_
	1:100	<u></u> Δ1					_
	1.100	WA1					_
Architects:	Adam	Haddo	w-7188	John Pr	adel-70	04	_

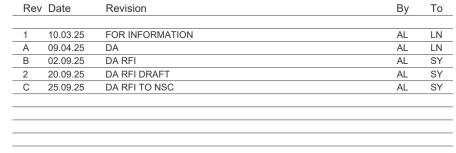






Project
CARABELLA
22-24 Carabella St, Kirribilli NSW 2061
CAMMERAYGAL PEOPLE / EORA NATION
Drawing Name
STREETSCAPE ELEVATIONS

Date	Scale	Sheet Size
25.09.25		A1
Drawn	Chk.	Job No.
AL	WG	7058
Drawing No.	Revision	
DA-1415		/ C




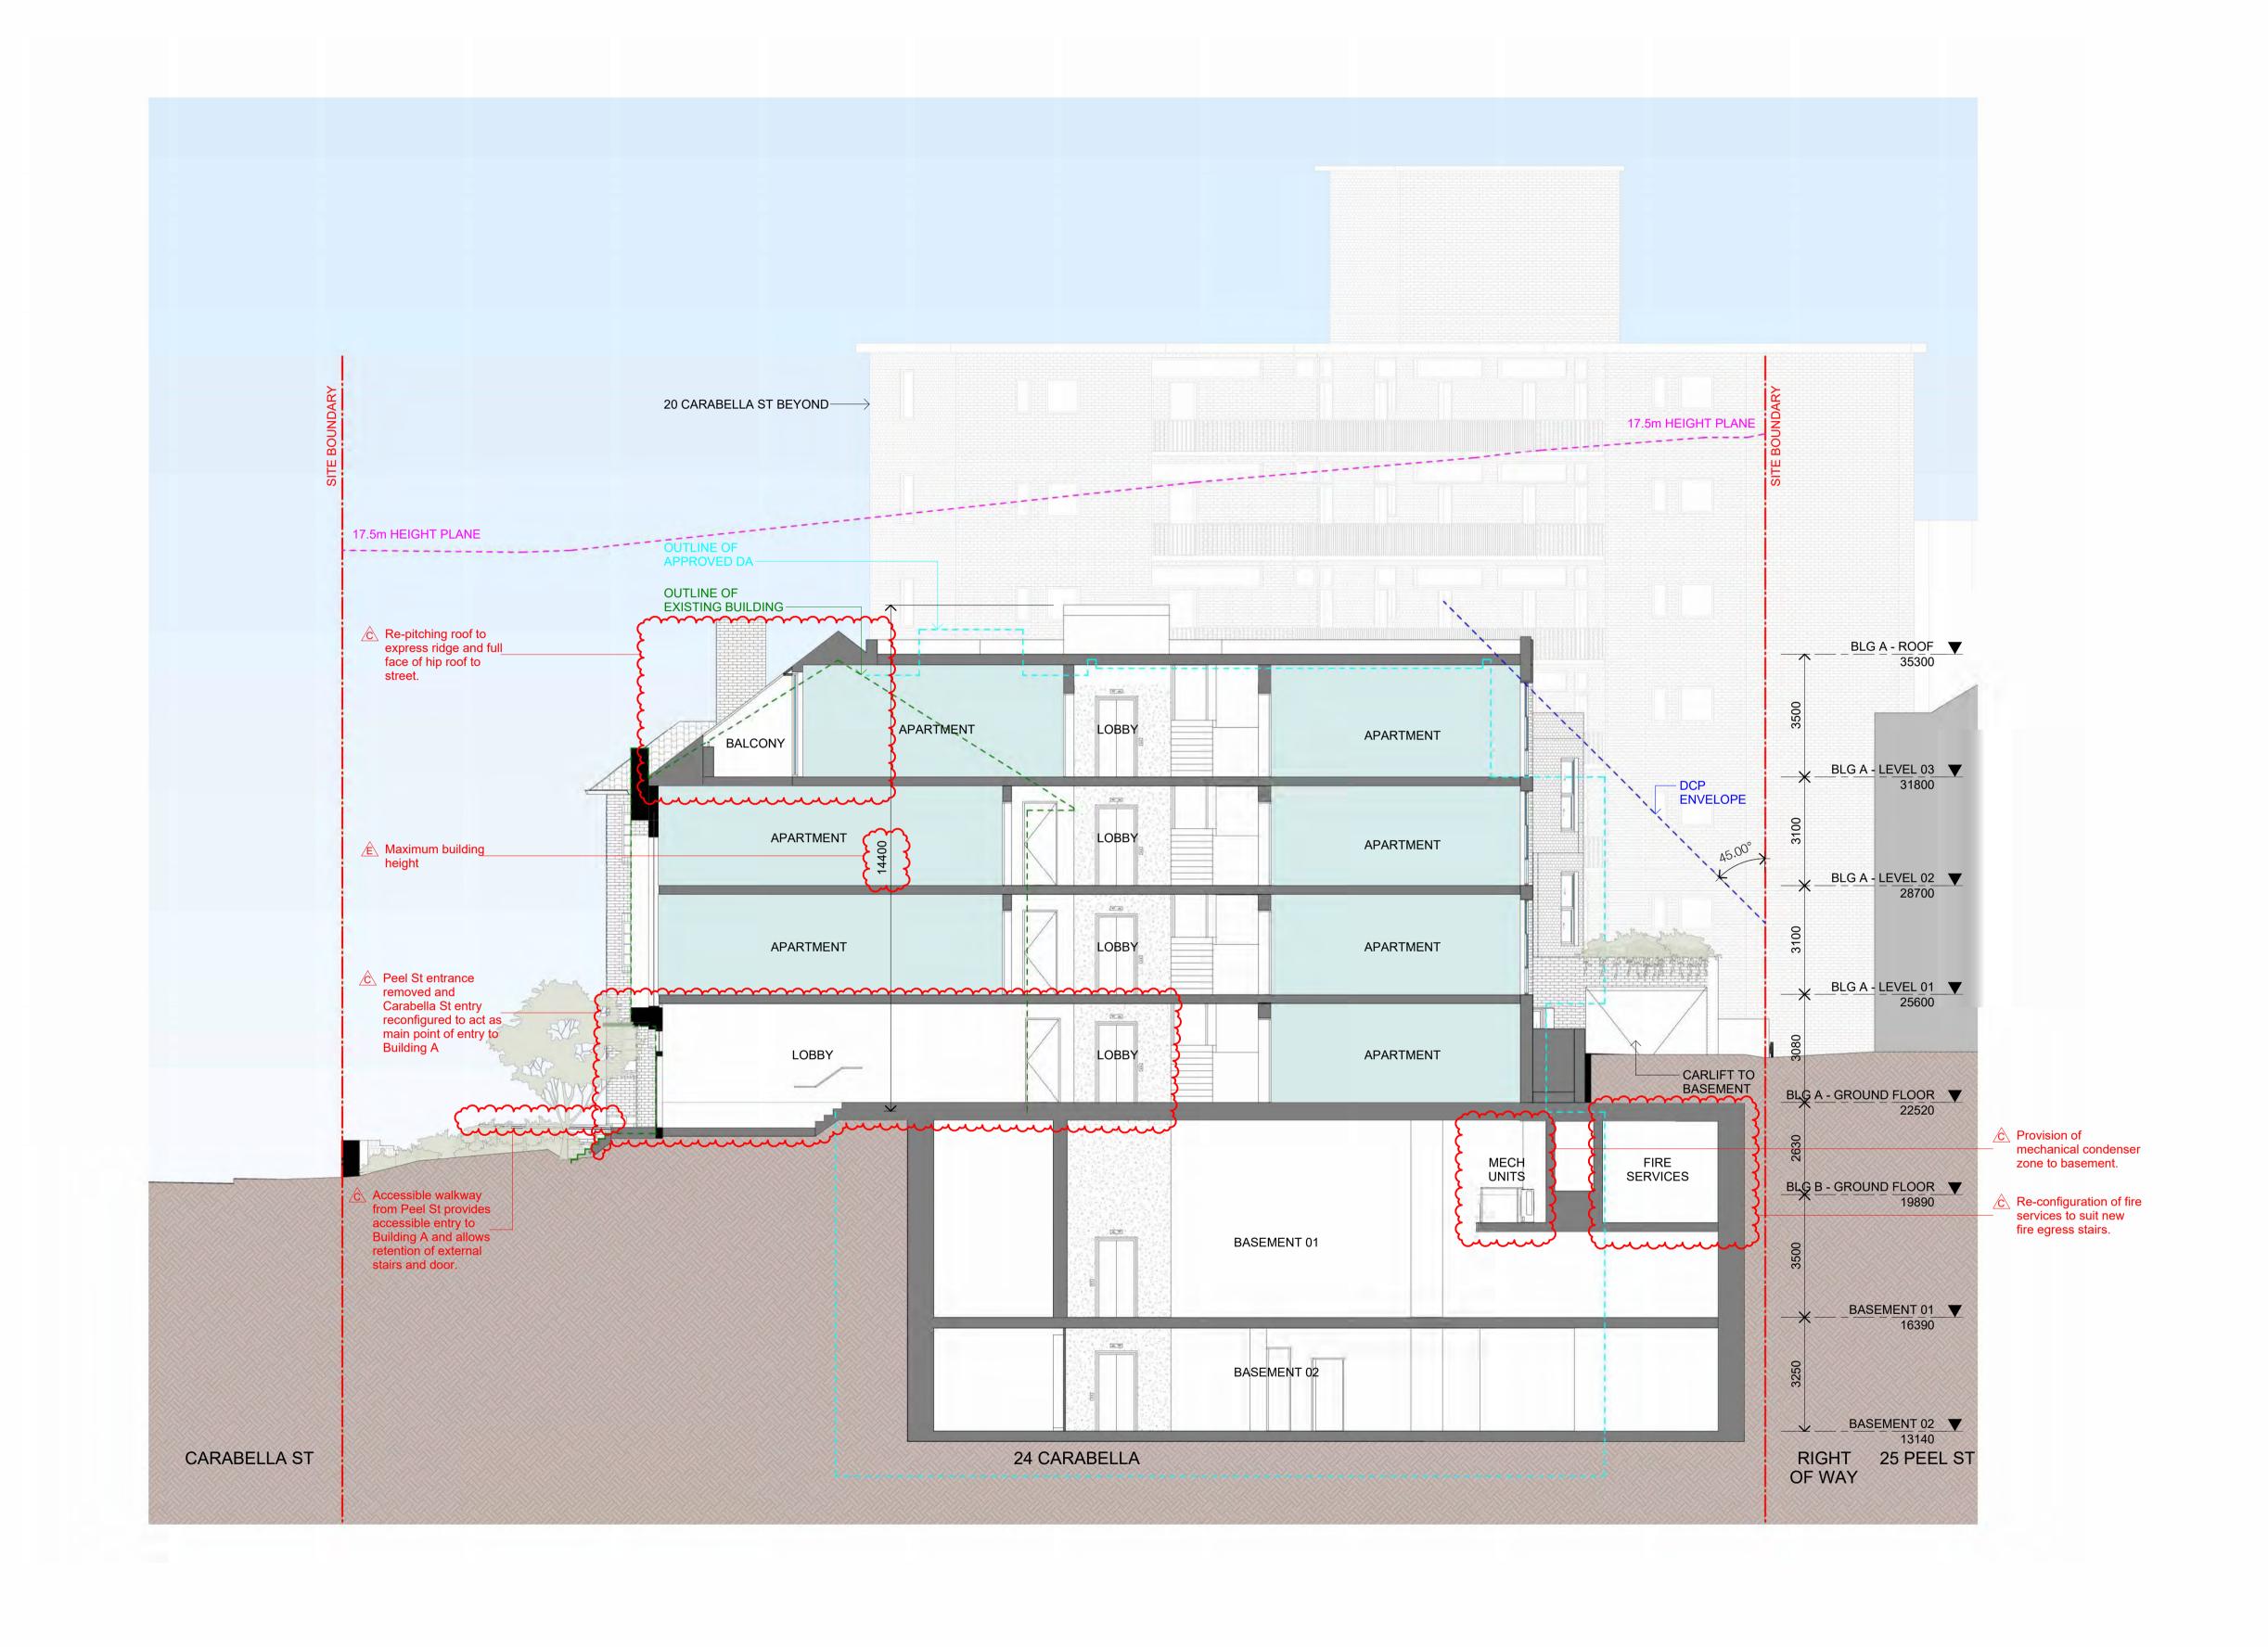

In accepting and utilising this document the recipient agrees that SJB Architecture (NSW) Pty. Ltd. ACN 081 094 724 T/A SJB Architects, retain all common law, statutory law and other rights including copyright and intellectual property rights. The recipient agrees not to use this document for any purpose other than its intended use; to waive all claims against SJB Architects resulting from unauthorised changes; or to reuse the document on other projects without prior written consent from SJB Architects. Under no circumstances shall transfer of this document be deemed a sale. SJB Architects makes no warranties of fitness for any purpose. The Builder/Contractor shall verify job dimensions prior to any work commencing. Use figured dimensions only. Do not scale drawings.

PRELIMINARY

0 1 2 5m 1:100 @A1 Nominated Architects: Adam Haddow-7188 | John Pradel-7004

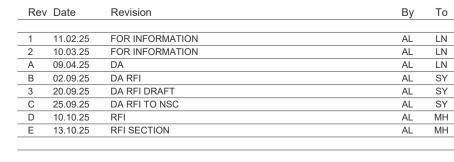






CARABELLA
22-24 Carabella St, Kirribilli NSW 2061
CAMMERAYGAL PEOPLE
Drawing Name
BUILDING SECTION A

Date	Scale	Sheet Size
13.10.25	1 : 100	A1
Drawn	Chk.	Job No.
AL	WG	7058
Drawing No.		Revision
DA-1501		/ F




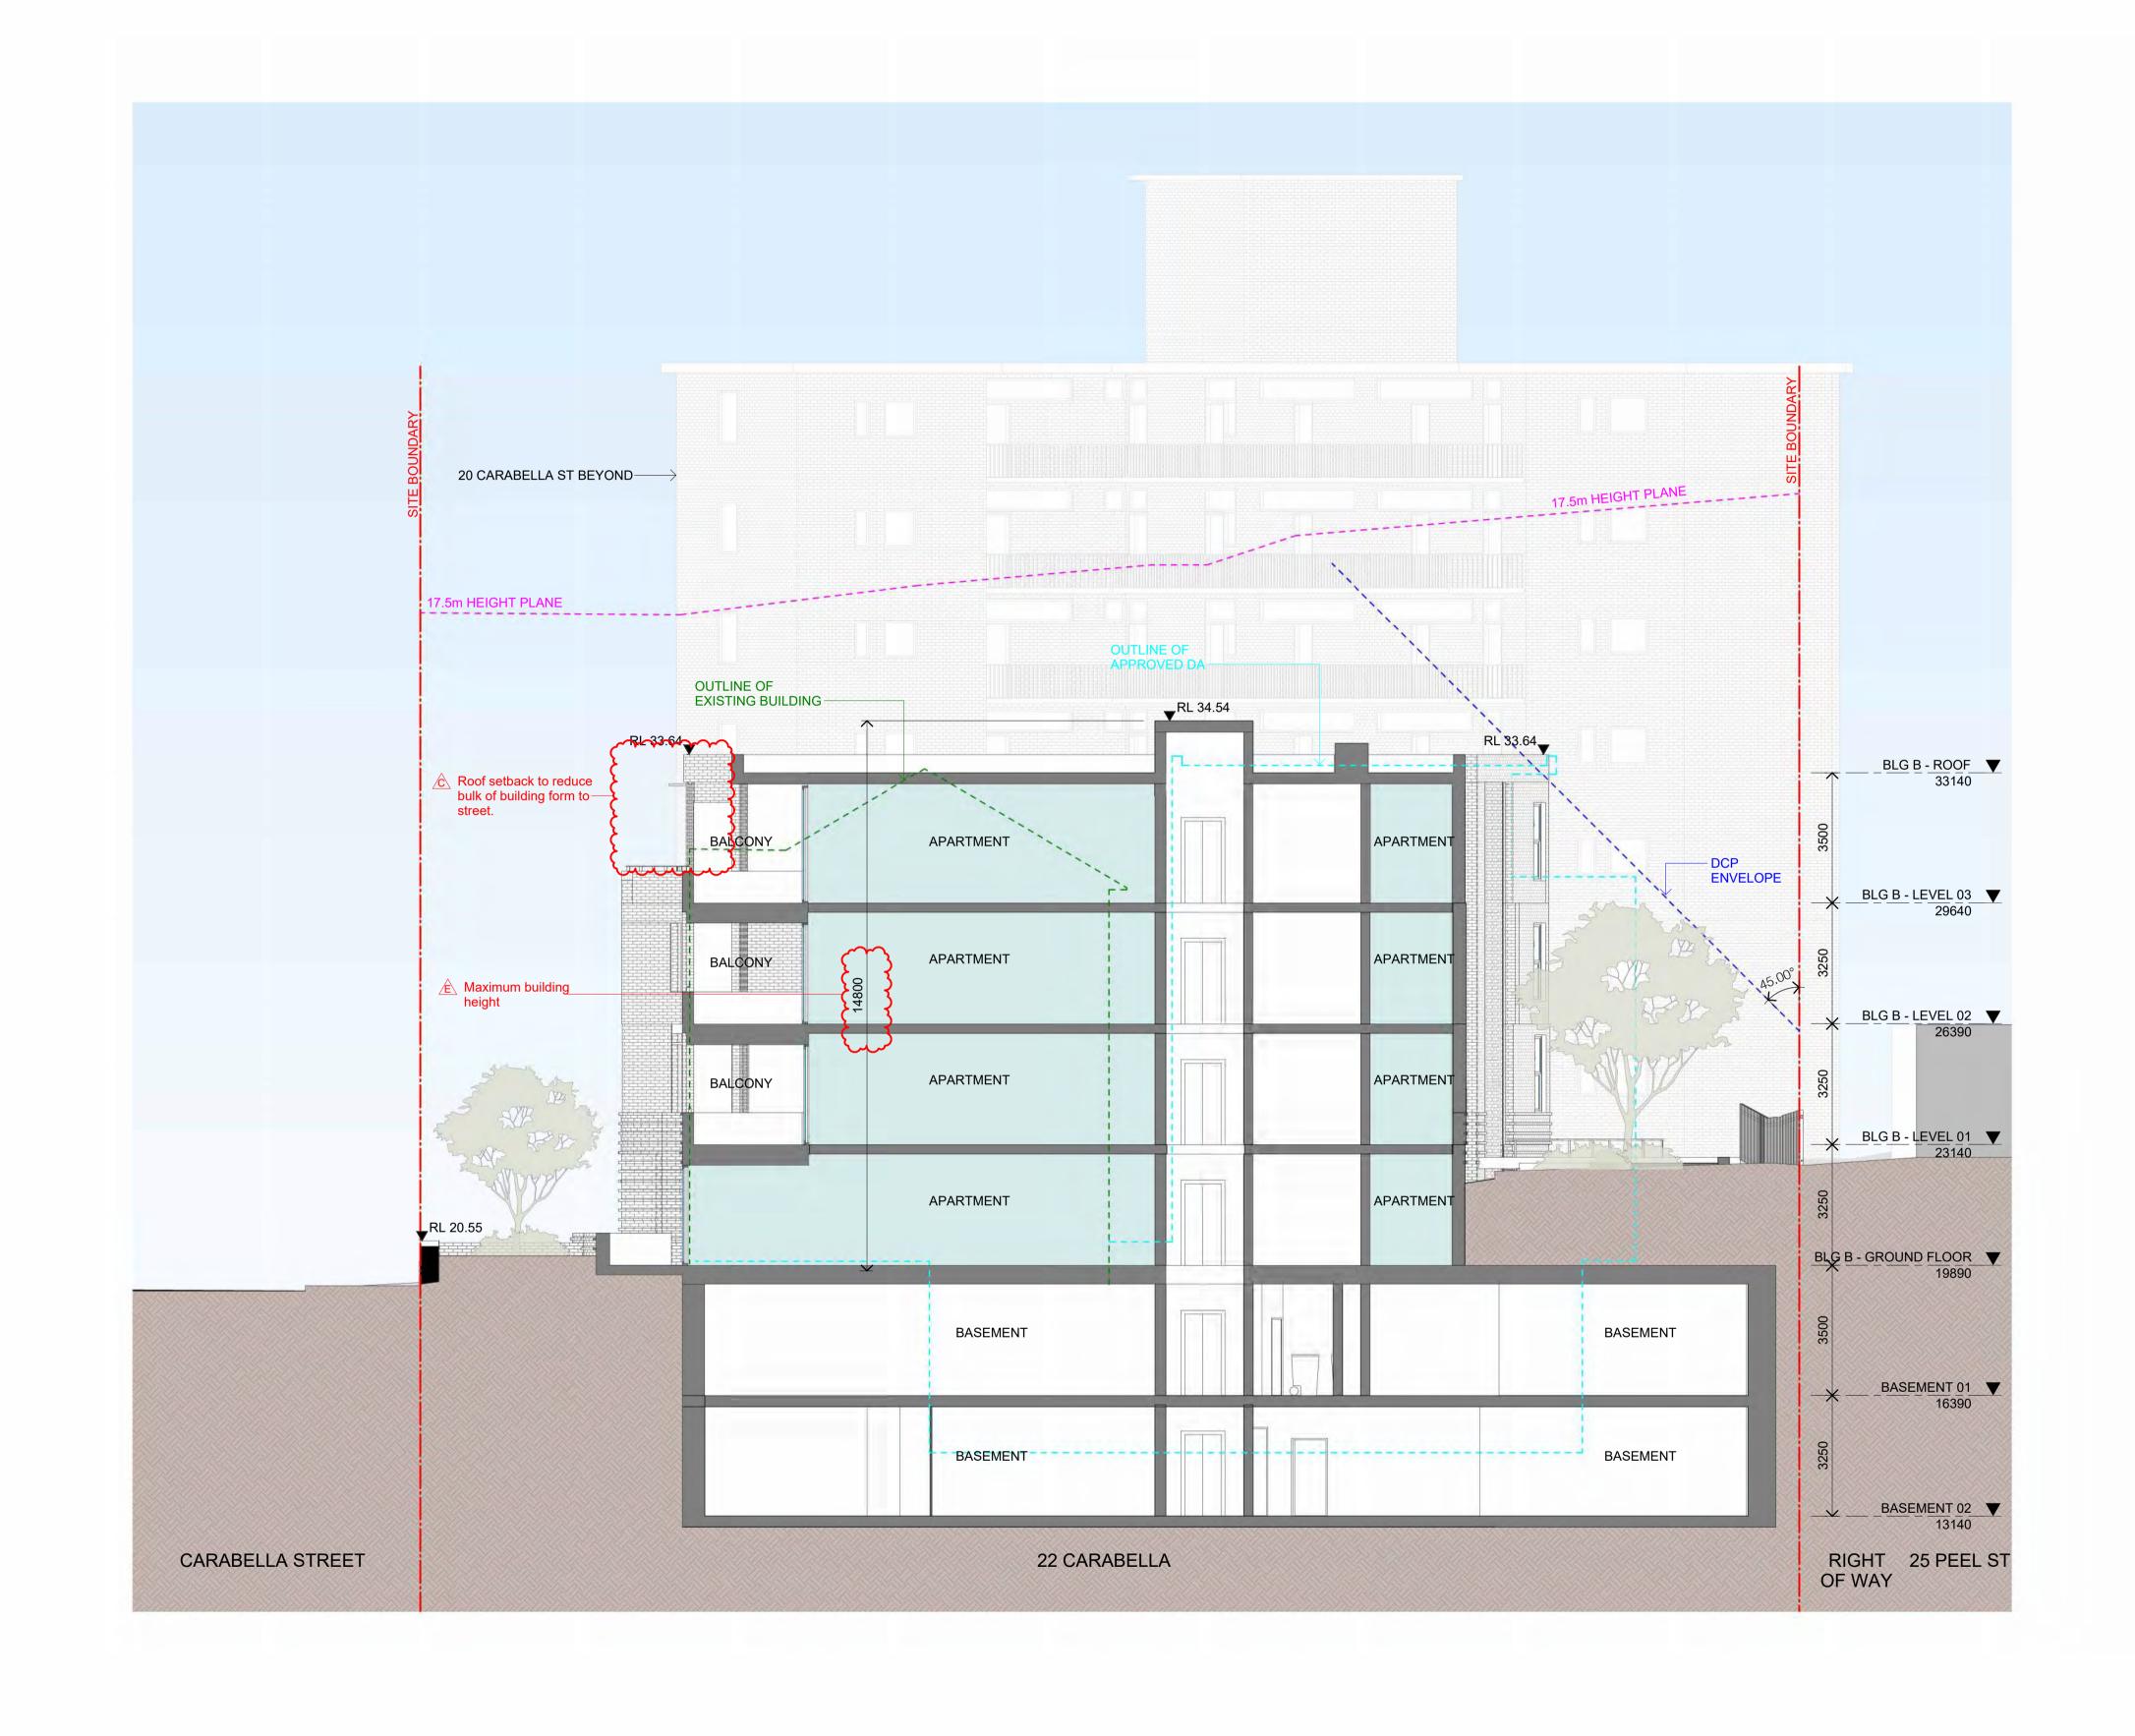

In accepting and utilising this document the recipient agrees that SJB Architecture (NSW) Pty. Ltd. ACN 081 094 724 T/A SJB Architects, retain all common law, statutory law and other rights including copyright and intellectual property rights. The recipient agrees not to use this document for any purpose other than its intended use; to waive all claims against SJB Architects resulting from unauthorised changes; or to reuse the document on other projects without prior written consent from SJB Architects. Under no circumstances shall transfer of this document be deemed a sale. SJB Architects makes no warranties of fitness for any purpose. The Builder/Contractor shall verify job dimensions prior to any work commencing. Use figured dimensions only. Do not scale drawings.

PRELIMINARY

0 1 2 5m 1:100 @A1

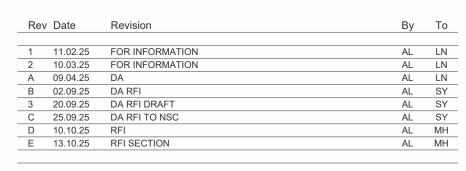






Project
CARABELLA
22-24 Carabella St, Kirribilli NSW 2061
CAMMERAYGAL PEOPLE
Drawing Name
BUILDING SECTION B

DA-1502		/ E
Drawing No.		Revision
AL	WG	7058
Drawn	Chk.	Job No
13.10.25	1 : 100	A1
Date	Scale	Sheet Size



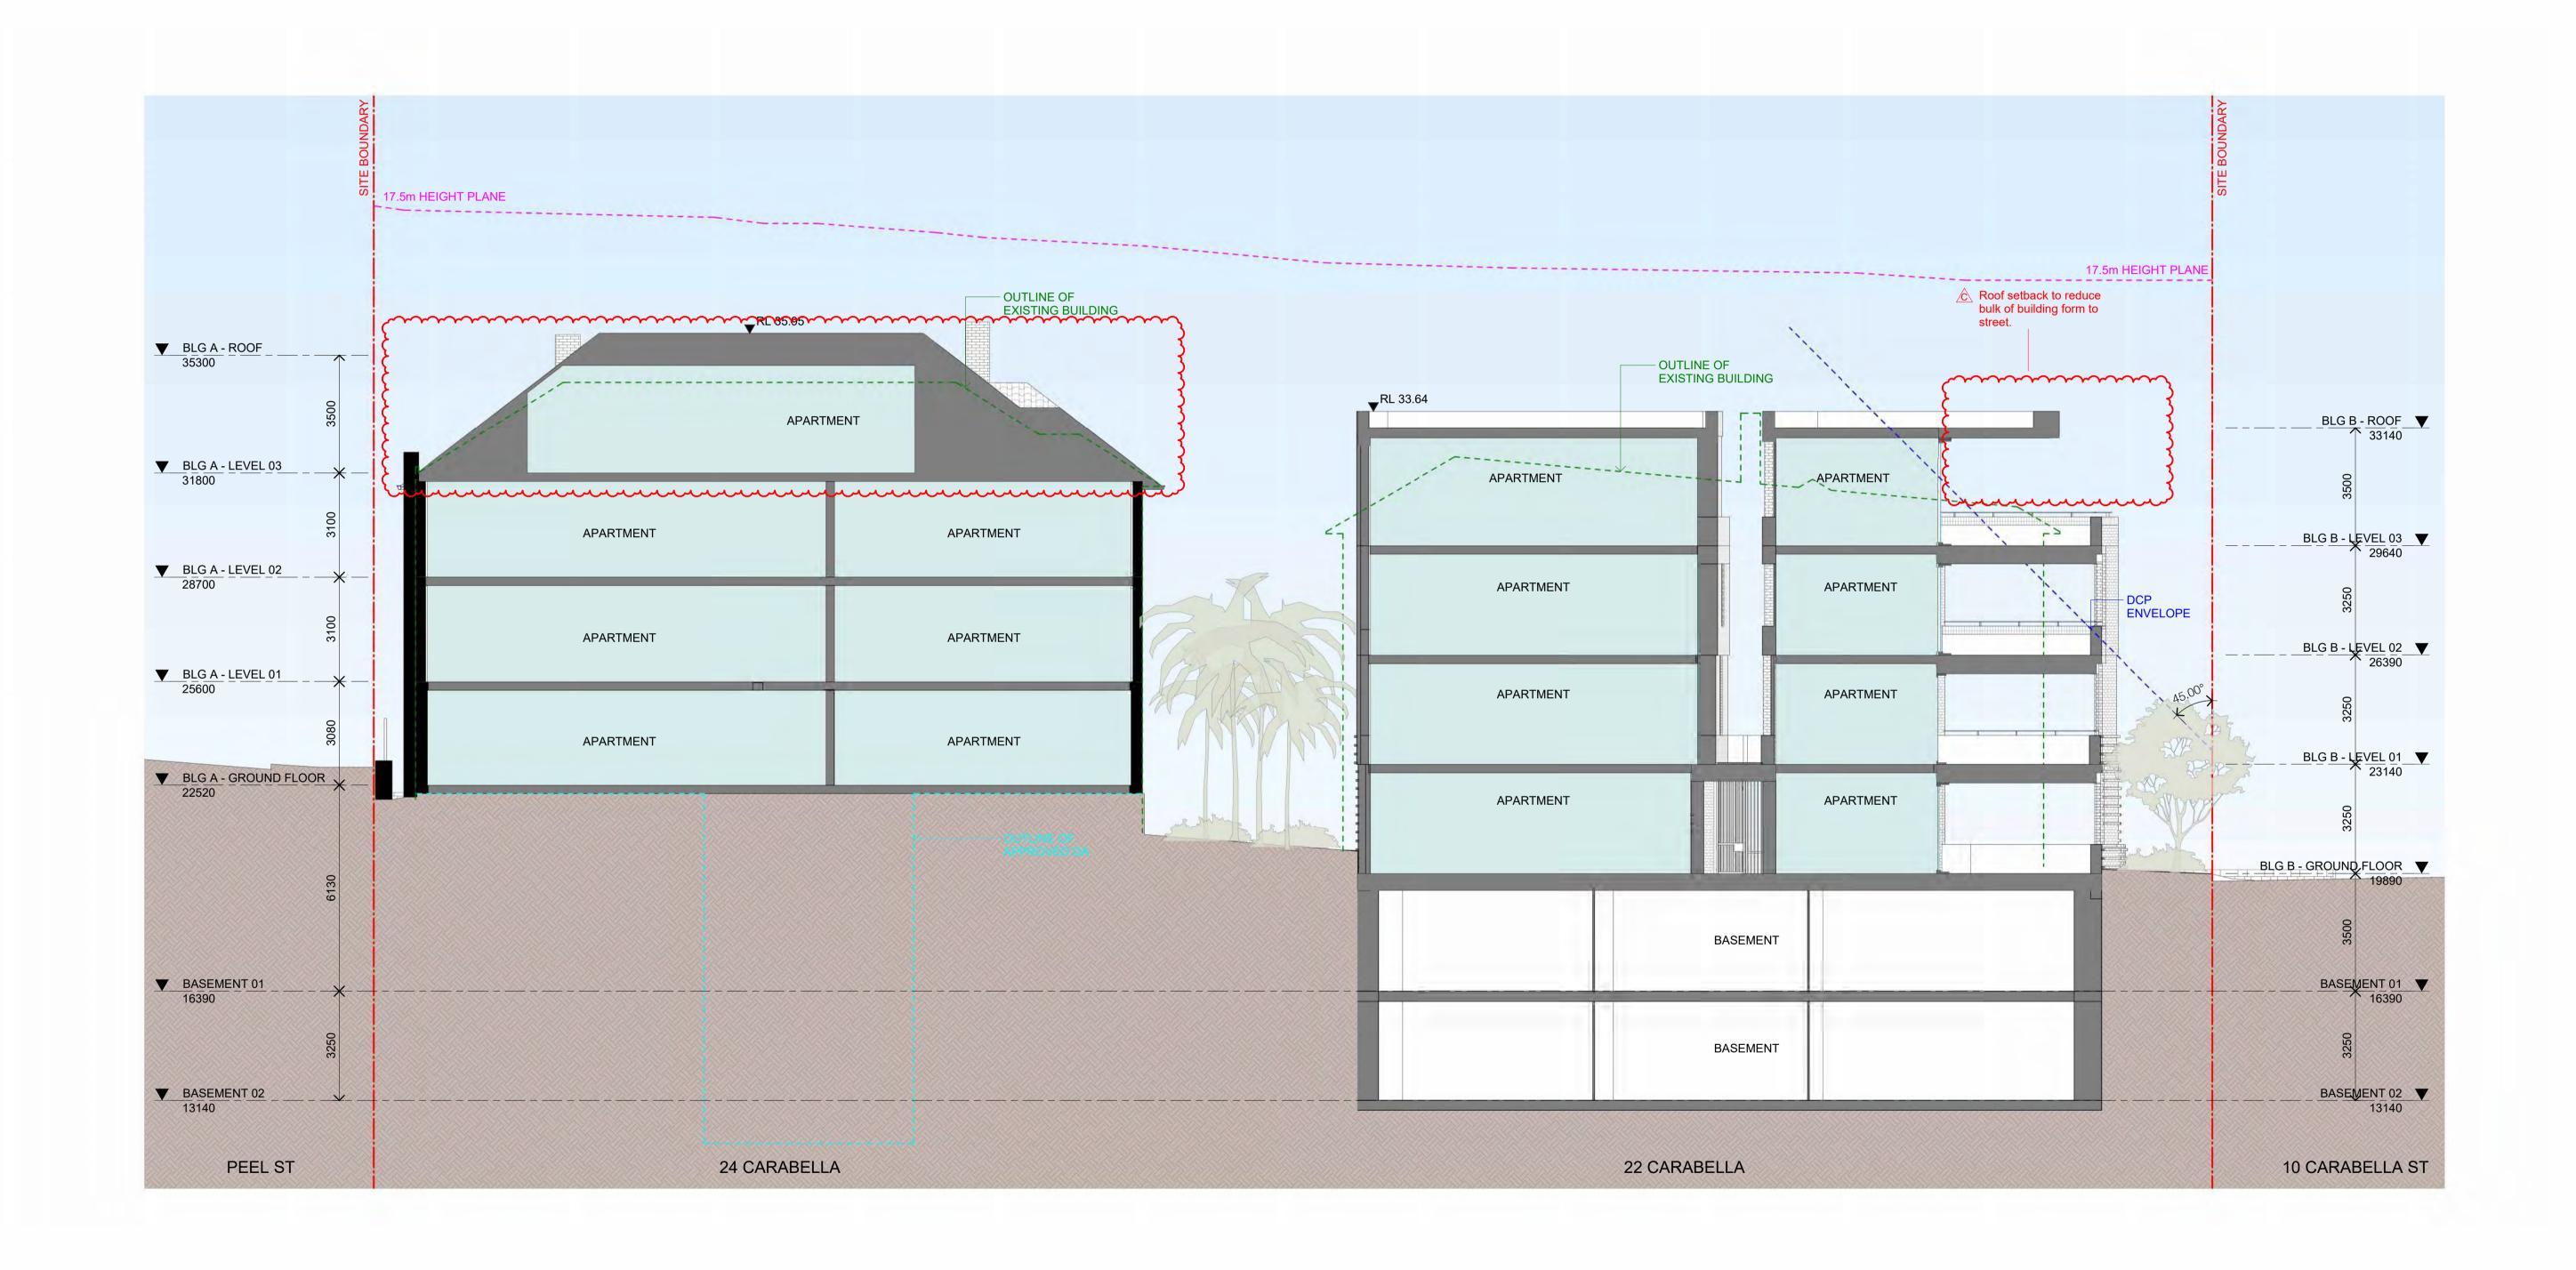

In accepting and utilising this document the recipient agrees that SJB Architecture (NSW) Pty. Ltd. ACN 081 094 724 T/A SJB Architects, retain all common law, statutory law and other rights including copyright and intellectual property rights. The recipient agrees not to use this document for any purpose other than its intended use; to waive all claims against SJB Architects resulting from unauthorised changes; or to reuse the document on other projects without prior written consent from SJB Architects. Under no circumstances shall transfer of this document be deemed a sale. SJB Architects makes no warranties of fitness for any purpose. The Builder/Contractor shall verify job dimensions prior to any work commencing. Use figured dimensions only. Do not scale drawings.

PRELIMINARY

0 1 2 5m 1:100 @A1

Nominated Architects: Adam Haddow-7188 | John Pradel-7004

 Rev
 Date
 Revision
 By
 To

 1
 11.02.25
 FOR INFORMATION
 AL
 LN

 2
 10.03.25
 FOR INFORMATION
 AL
 LN

 A
 09.04.25
 DA
 AL
 LN

 B
 02.09.25
 DA RFI
 AL
 SY

 3
 20.09.25
 DA RFI DRAFT
 AL
 SY

 C
 25.09.25
 DA RFI TO NSC
 AL
 SY






CARABELLA
22-24 Carabella St, Kirribilli NSW 2061
CAMMERAYGAL PEOPLE / EORA NATION
Drawing Name
BUILDING SECTION C

Date	Scale	Sheet Size
25.09.25	1 : 100	A1
Drawn	Chk.	Job No.
AL	WG	7058
Drawing No.		Revision
DA-1503		/ C



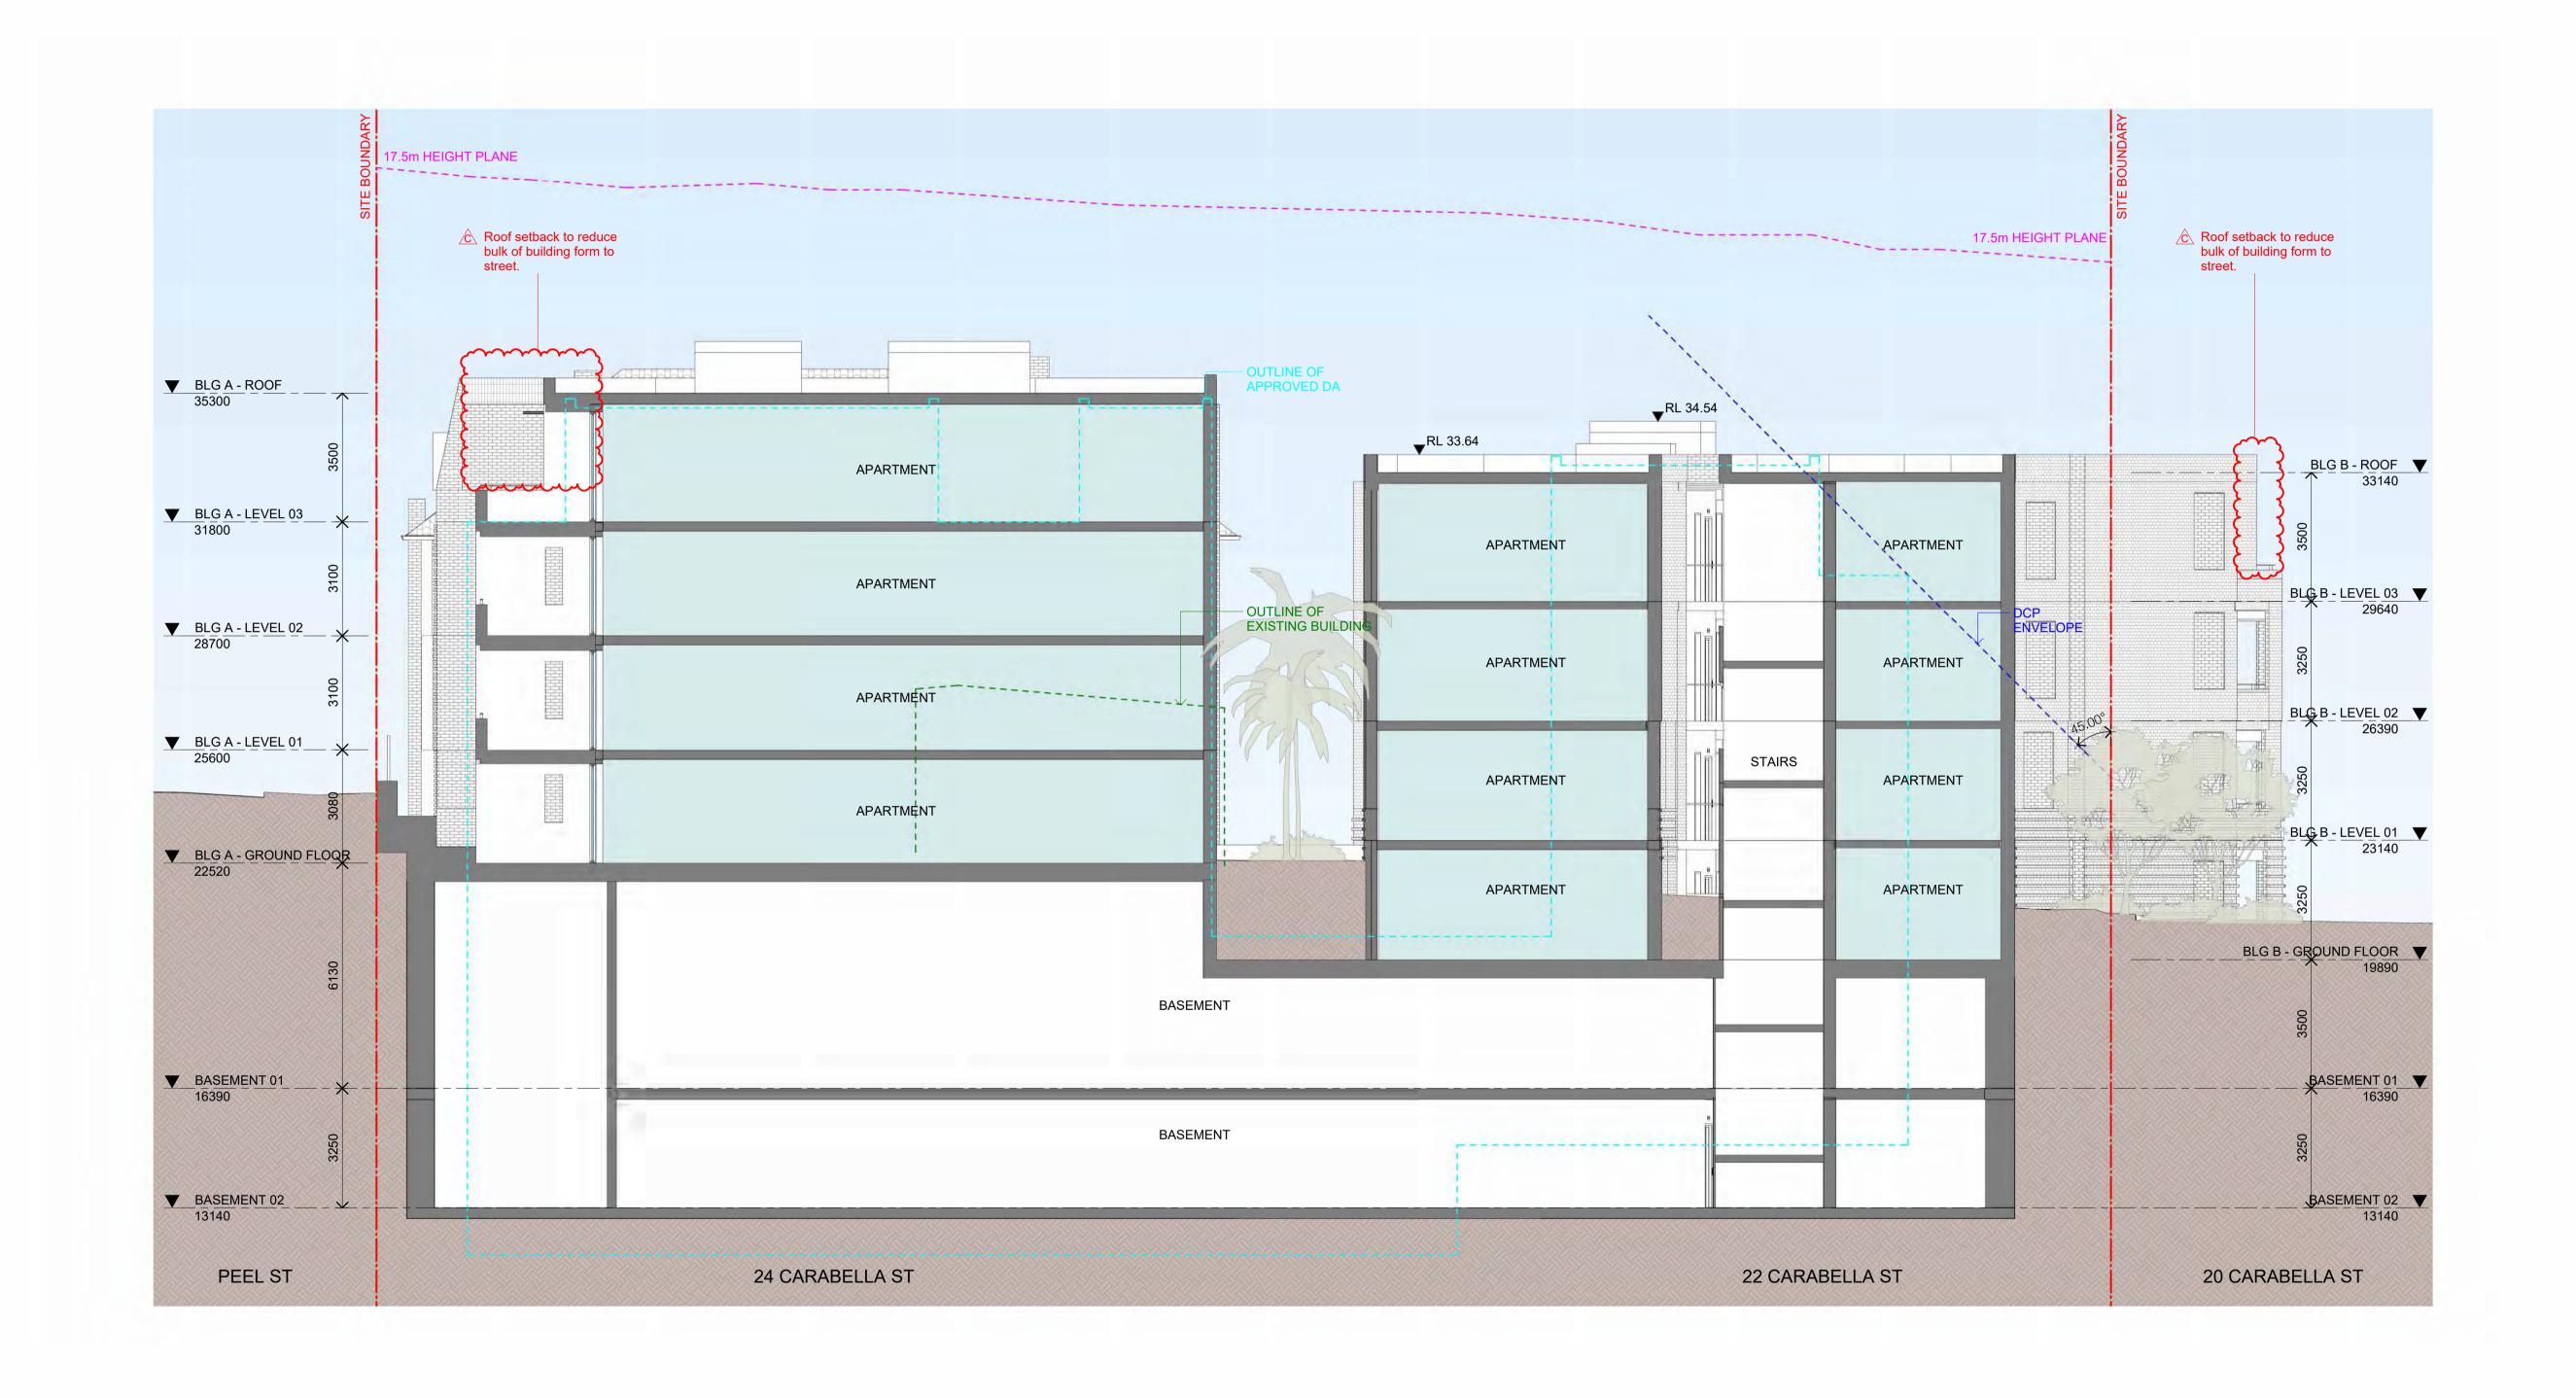


In accepting and utilising this document the recipient agrees that SJB Architecture (NSW) Pty. Ltd. ACN 081 094 724 T/A SJB Architects, retain all common law, statutory law and other rights including copyright and intellectual property rights. The recipient agrees not to use this document for any purpose other than its intended use; to waive all claims against SJB Architects resulting from unauthorised changes; or to reuse the document on other projects without prior written consent from SJB Architects. Under no circumstances shall transfer of this document be deemed a sale. SJB Architects makes no warranties of fitness for any purpose. The Builder/Contractor shall verify job dimensions prior to any work commencing. Use figured dimensions only. Do not scale drawings.

PRELIMINARY

0 1 2 5m
1:100 @A1

Nominated Architects: Adam Haddow-7188 | John Pradel-7004

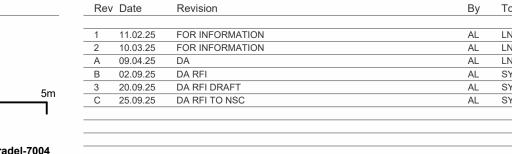






Project
CARABELLA
22-24 Carabella St, Kirribilli NSW 2061
CAMMERAYGAL PEOPLE / EORA NATION
Drawing Name
BUILDING SECTION D

Date	Scale	Sheet Size
25.09.25	1:100	A1
Drawn	Chk.	Job No
AL	WG	7058
Drawing No.		Revision
DA-1504		/ C




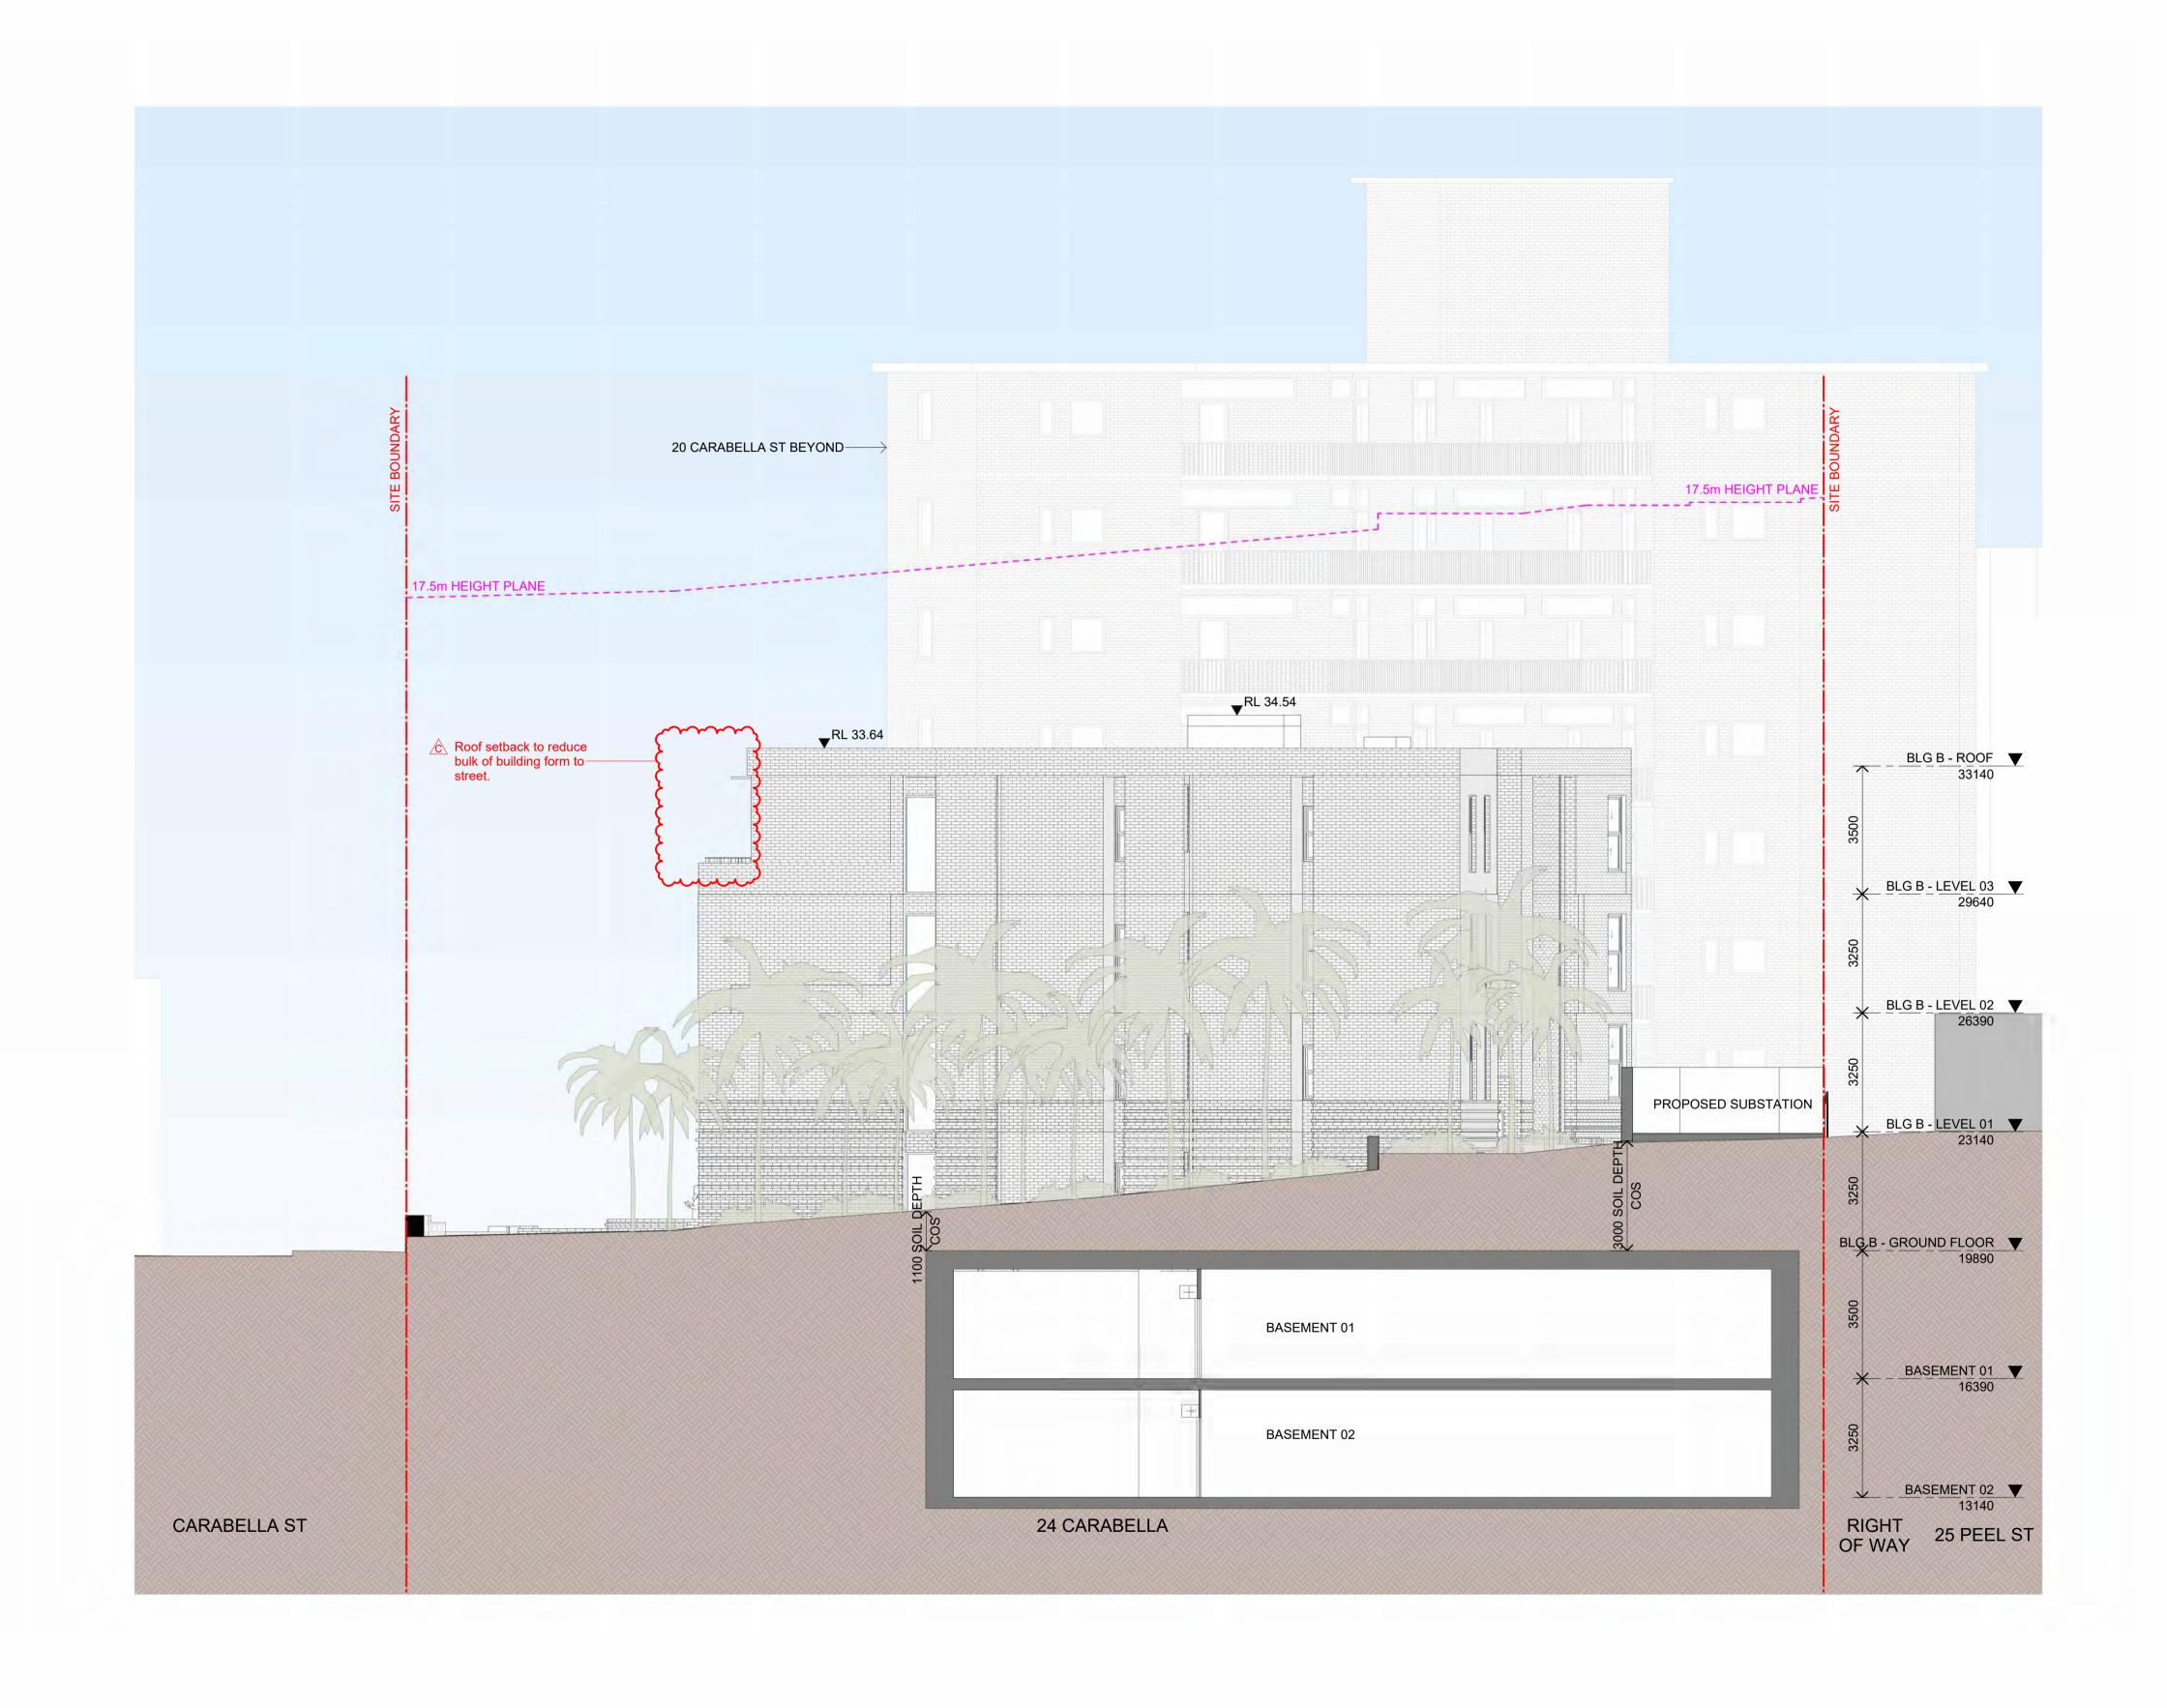

In accepting and utilising this document the recipient agrees that SJB Architecture (NSW) Pty. Ltd. ACN 081 094 724 T/A SJB Architects, retain all common law, statutory law and other rights including copyright and intellectual property rights. The recipient agrees not to use this document for any purpose other than its intended use; to waive all claims against SJB Architects resulting from unauthorised changes; or to reuse the document on other projects without prior written consent from SJB Architects. Under no circumstances shall transfer of this document be deemed a sale. SJB Architects makes no warranties of fitness for any purpose. The Builder/Contractor shall verify job dimensions prior to any work commencing. Use figured dimensions only. Do not scale drawings.

PRELIMINARY

0 1 2 5m 1:100 @A1 Nominated Architects: Adam Haddow-7188 | John Pradel-7004

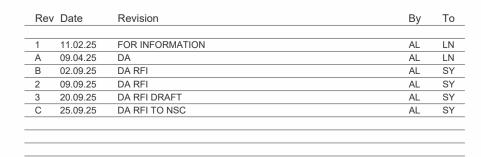






CARABELLA
22-24 Carabella St, Kirribilli NSW 2061
CAMMERAYGAL PEOPLE / EORA NATION
Drawing Name
BUILDING SECTION E

Date	Scale	Sheet Size
25.09.25	1 : 100	A1
Drawn	Chk.	Job No.
AL	WG	7058
Drawing No.		Revision
DA-1505		/ C



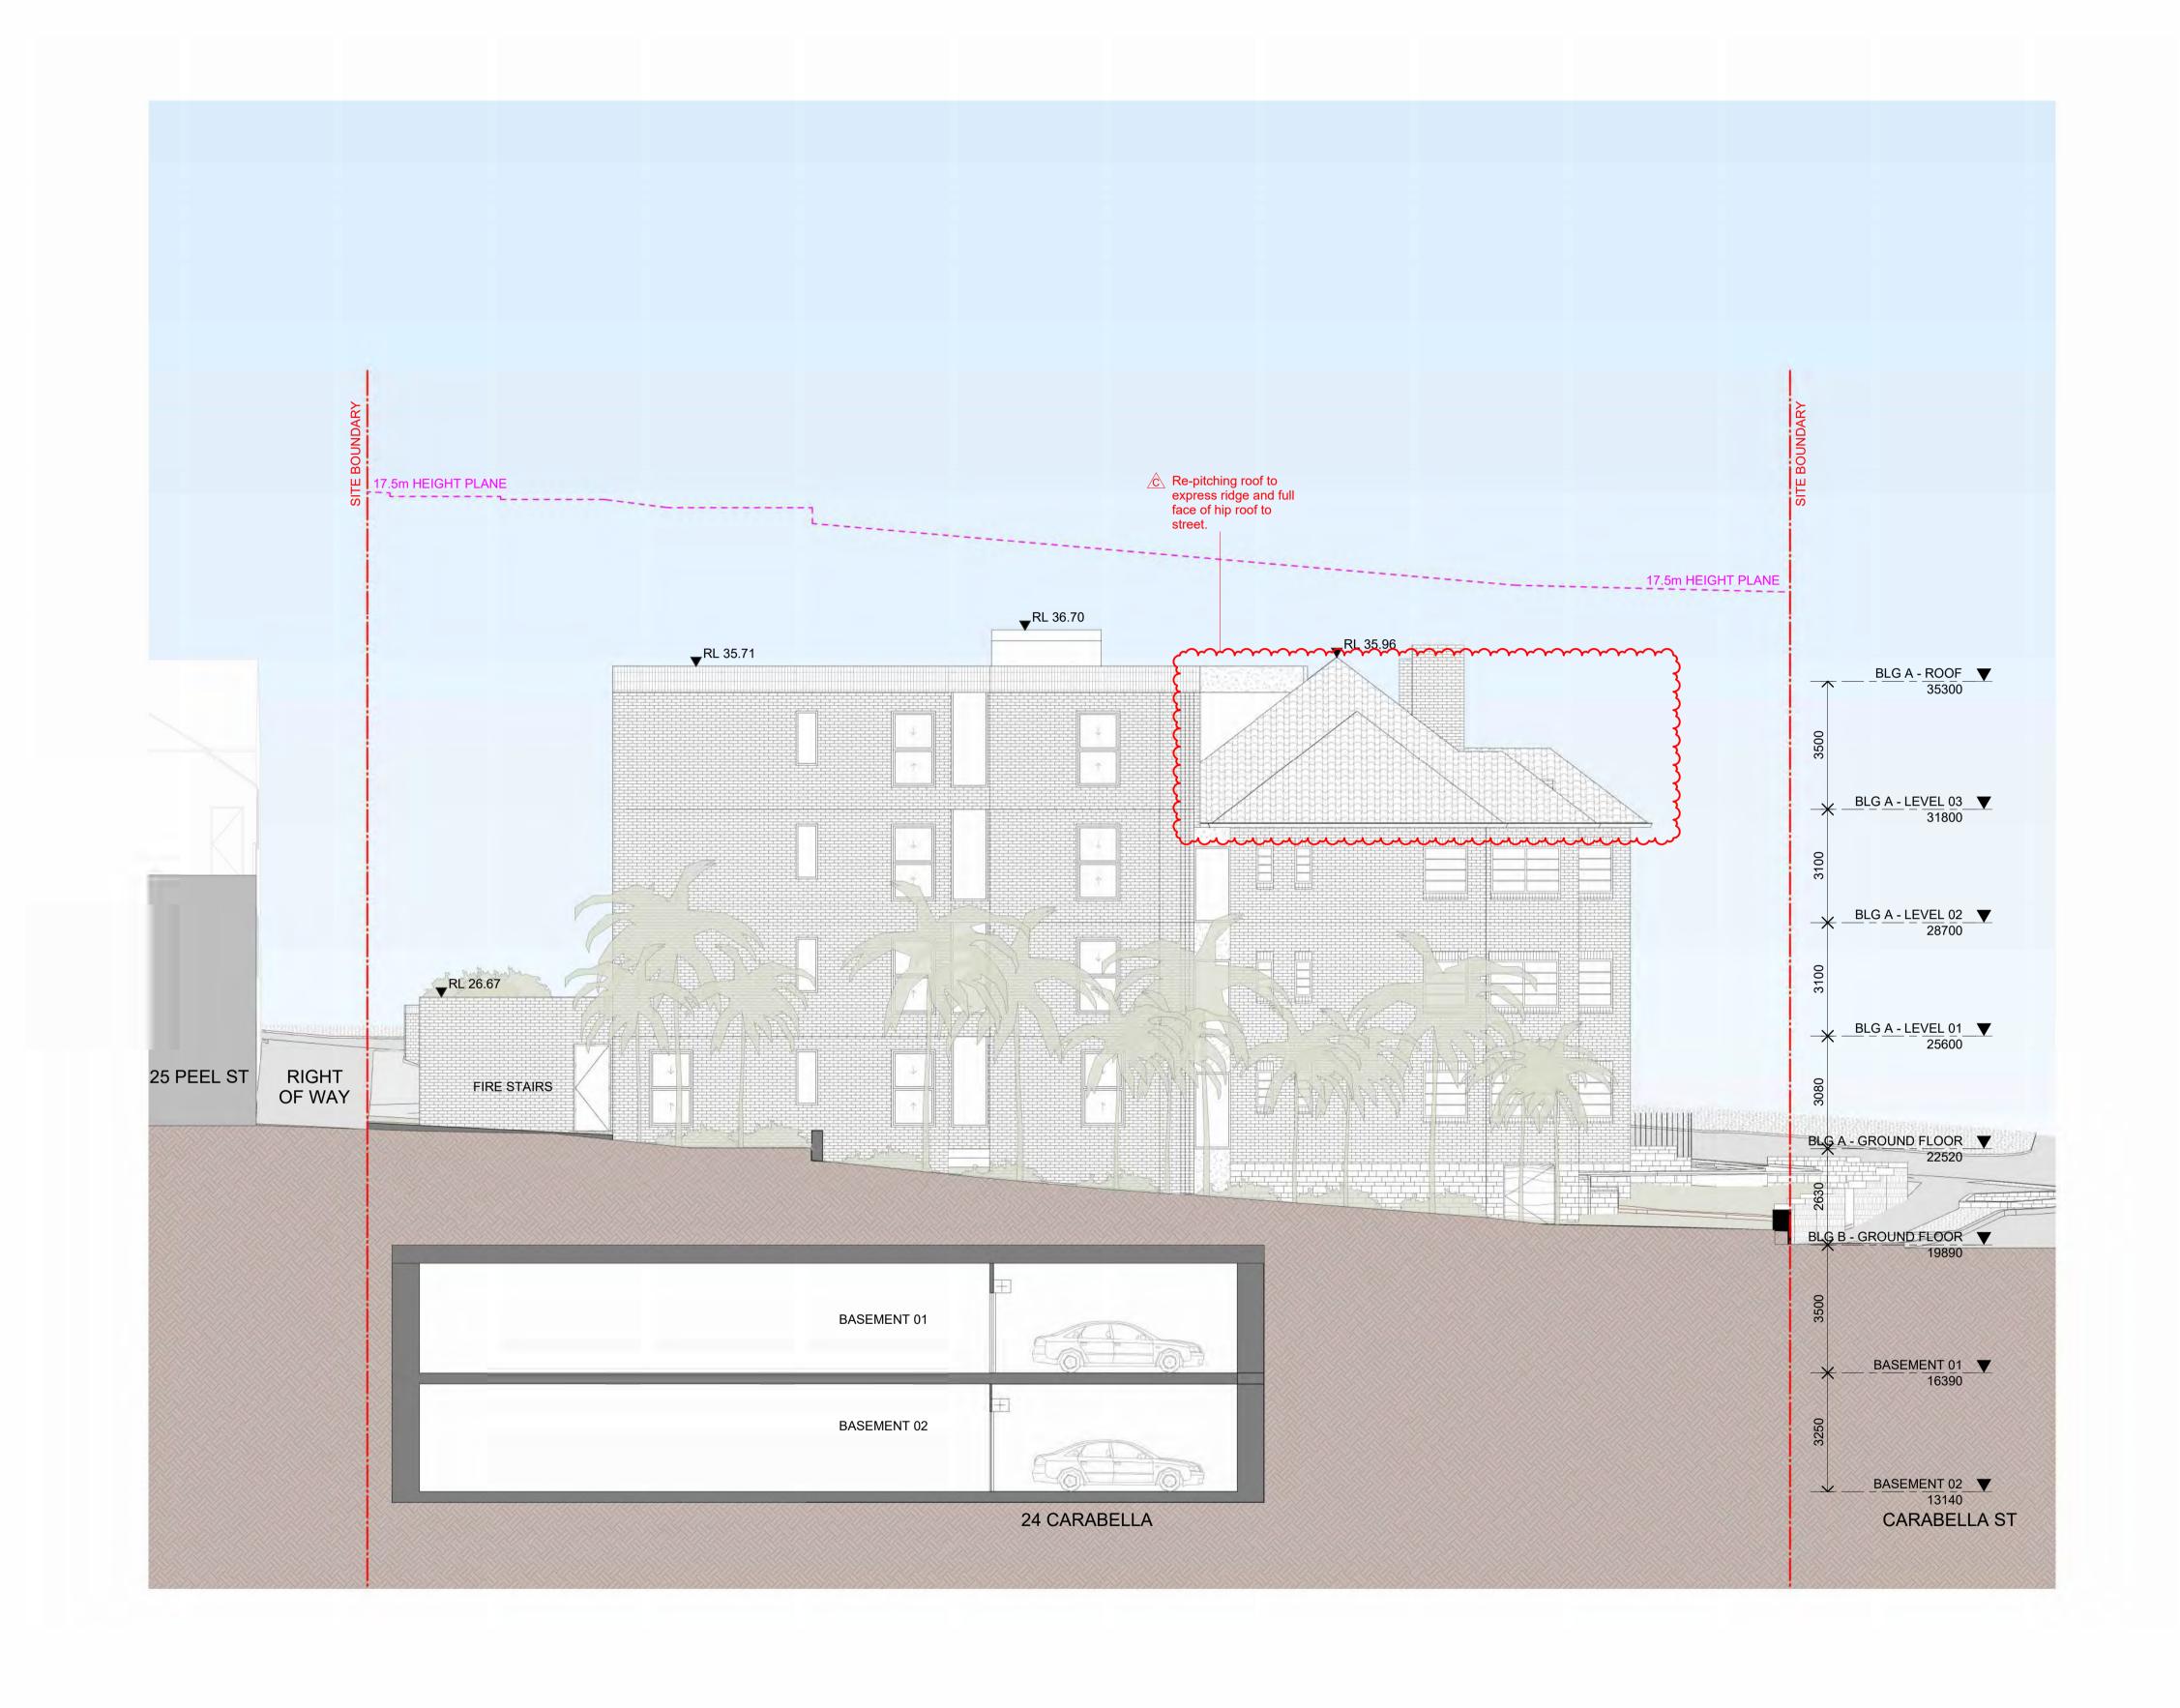


In accepting and utilising this document the recipient agrees that SJB Architecture (NSW) Pty. Ltd. ACN 081 094 724 T/A SJB Architects, retain all common law, statutory law and other rights including copyright and intellectual property rights. The recipient agrees not to use this document for any purpose other than its intended use; to waive all claims against SJB Architects resulting from unauthorised changes; or to reuse the document on other projects without prior written consent from SJB Architects. Under no circumstances shall transfer of this document be deemed a sale. SJB Architects makes no warranties of fitness for any purpose. The Builder/Contractor shall verify job dimensions prior to any work commencing. Use figured dimensions only. Do not scale drawings.

PRELIMINARY

0 1 2 5m 1:100 @A1

Nominated Architects: Adam Haddow-7188 | John Pradel-7004

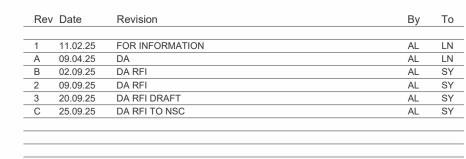







CARABELLA
22-24 Carabella St, Kirribilli NSW 2061
CAMMERAYGAL PEOPLE / EORA NATION
Drawing Name
BUILDING SECTION F

Date	Scale	Sheet Size
25.09.25	1 : 100	A1
Drawn	Chk.	Job No
AL	WG	7058
Drawing No.		Revision
DA-1506		/ C



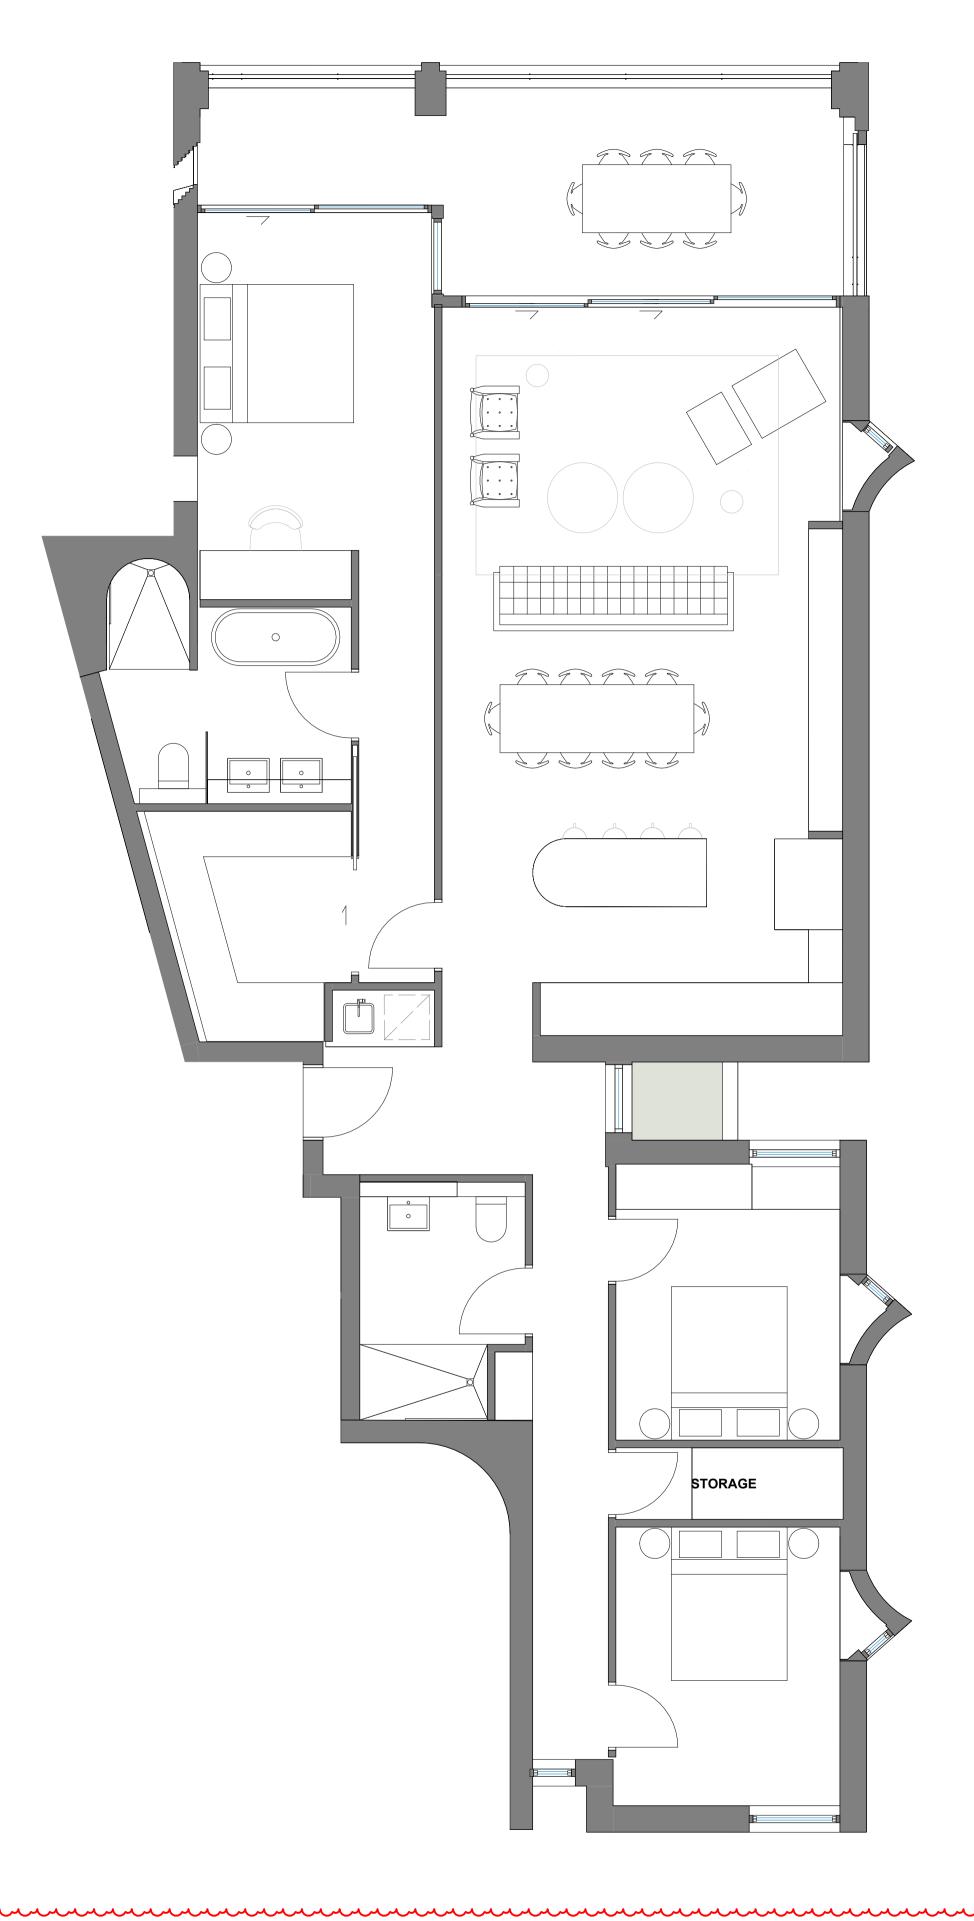

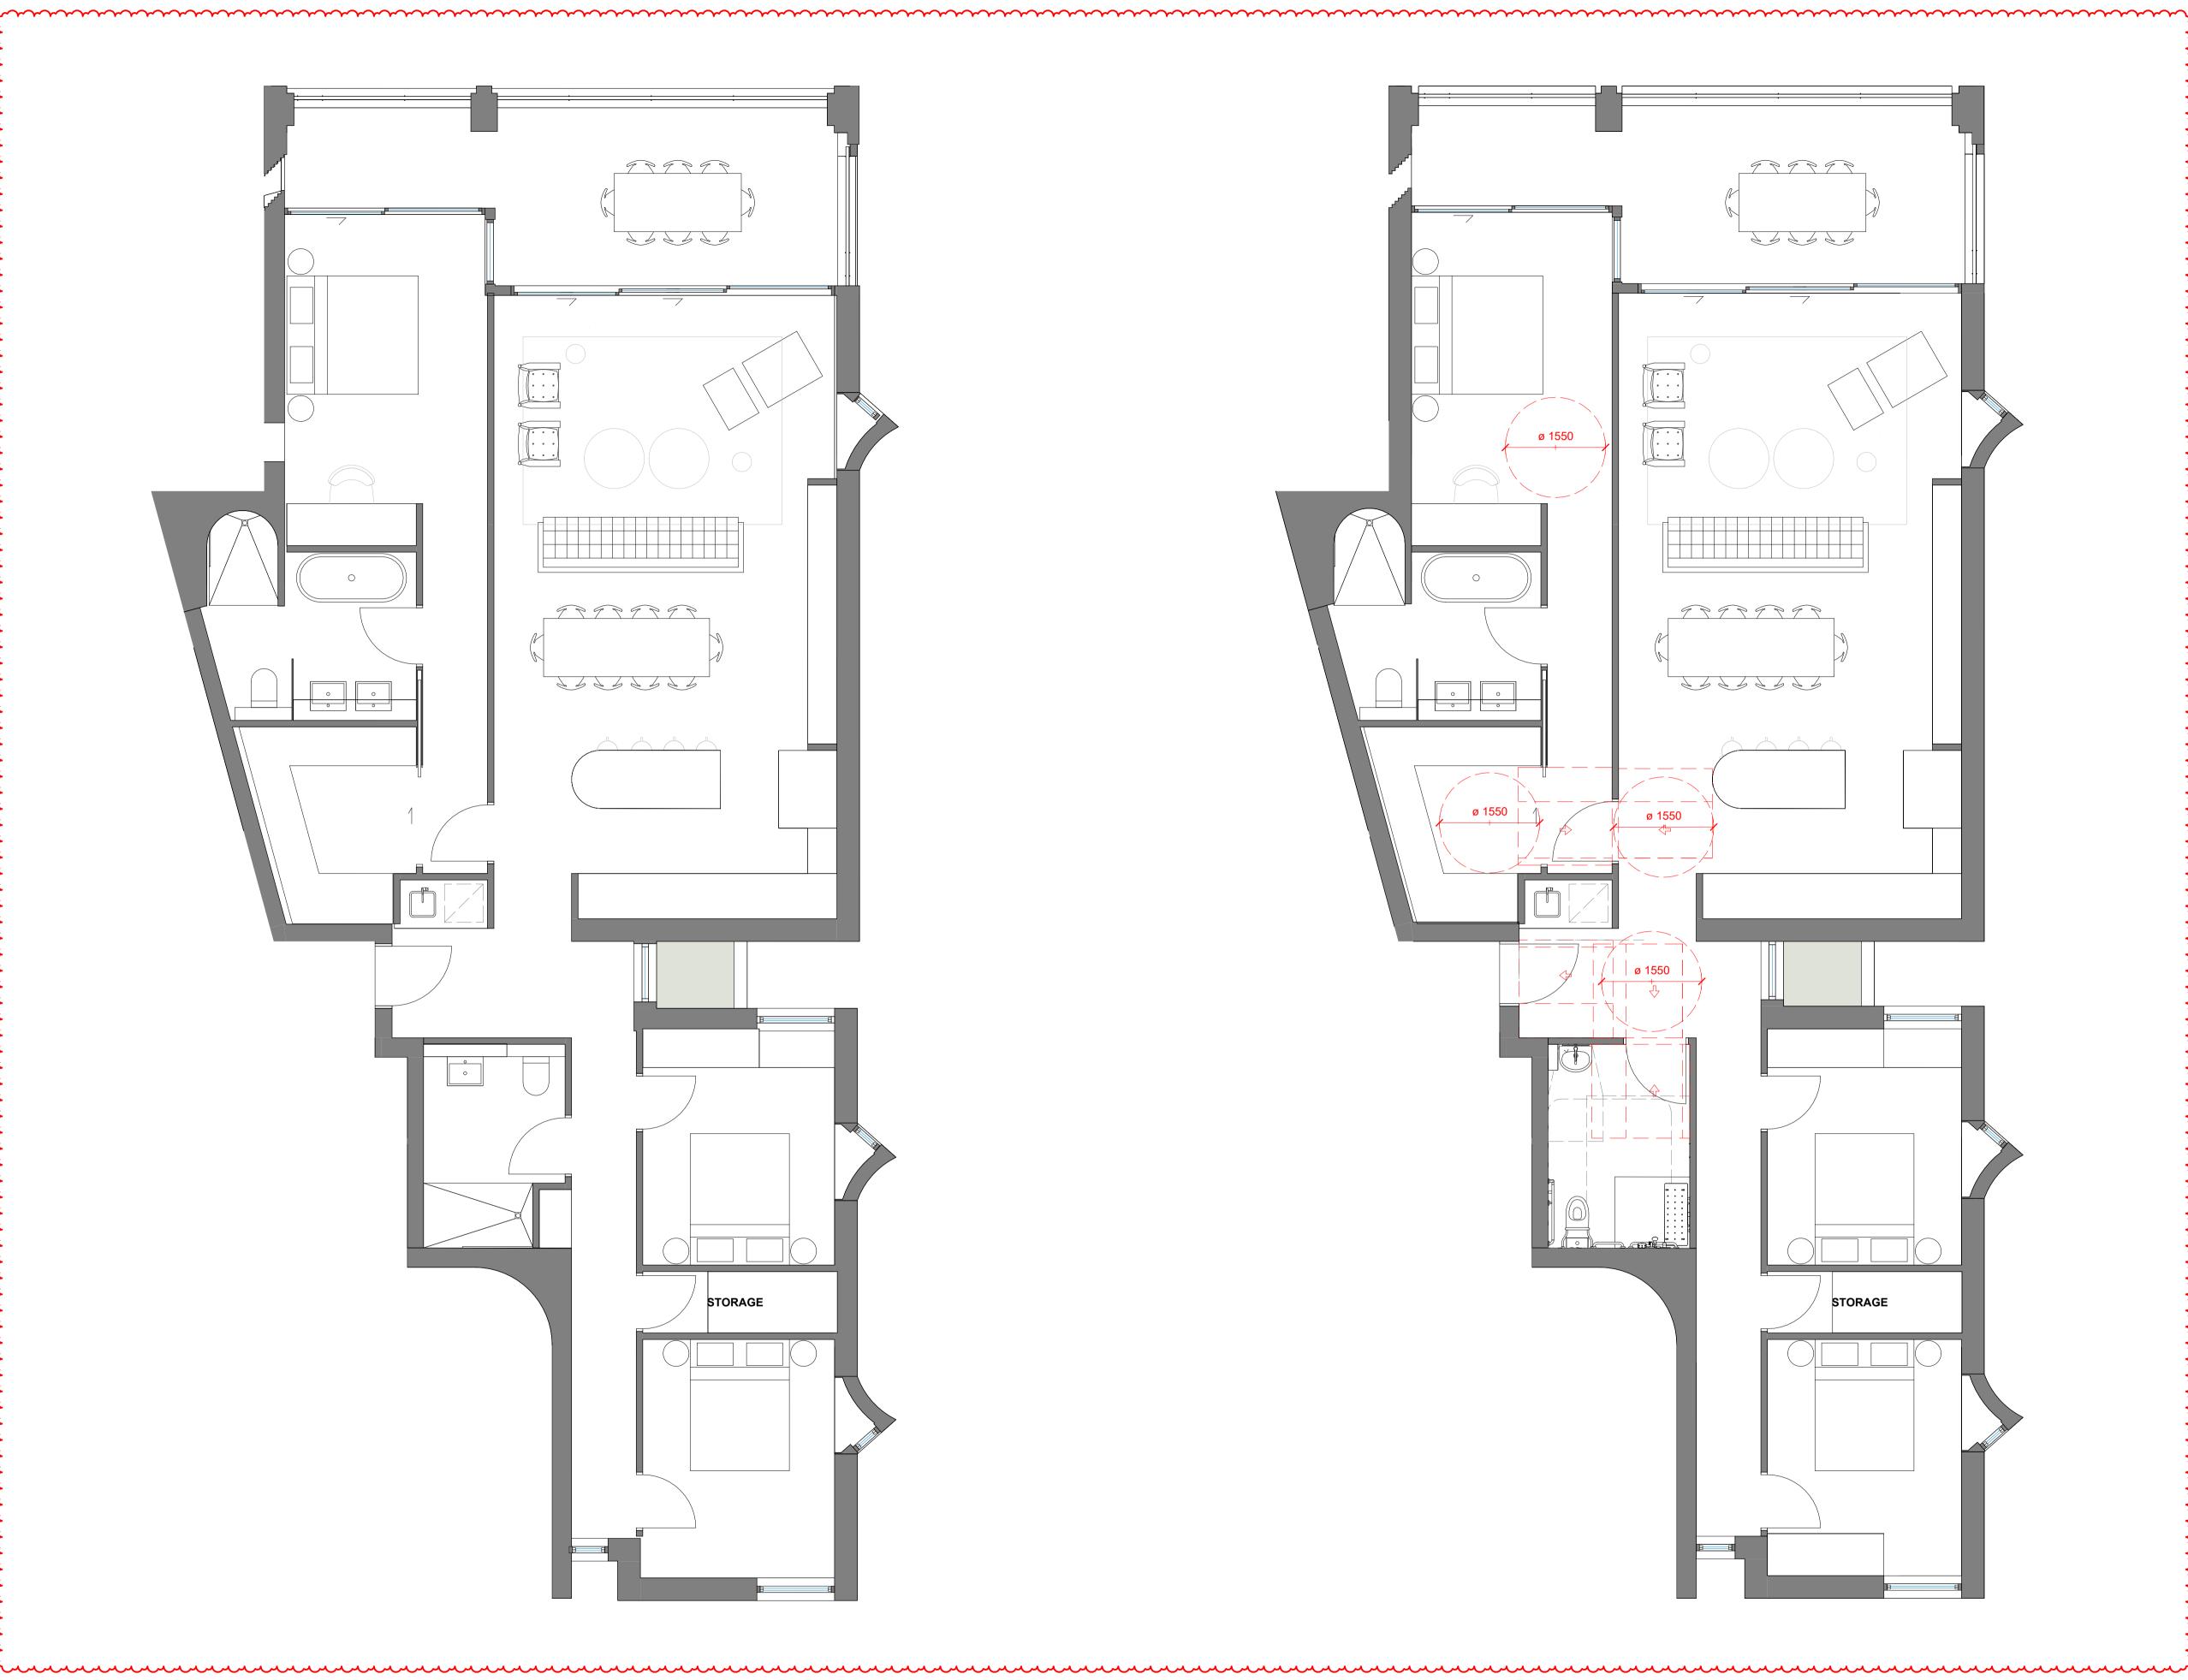


Adaptable layouts shown.

2 APT-D LEVEL 01 TYP 02 PRE-ADAPTION SCALE 1:50

In accepting and utilising this document the recipient agrees that SJB Architecture (NSW) Pty. Ltd. ACN 081 094 724 T/A SJB Architects, retain all common law, statutory law and other rights including copyright and intellectual property rights. The recipient agrees not to use this document for any purpose other than its intended use; to waive all claims against SJB Architects resulting from unauthorised changes; or to reuse the document on other projects without prior written consent from SJB Architects. Under no circumstances shall transfer of this document be deemed a sale. SJB Architects makes no warranties of fitness for any purpose. The Builder/Contractor shall verify job dimensions prior to any work commencing. Use figured dimensions only. Do not scale drawings.

1:100 @A1 **PRELIMINARY** Nominated Architects: Adam Haddow-7188 | John Pradel-7004

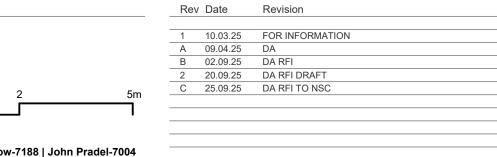



PROPERTY


CARABELLA 22-24 Carabella St, Kirribilli NSW 2061 CAMMERAYGAL PEOPLE / EORA NATION ADAPTABLE APARTMENT PLAN B1.02

Date	Scale	Sheet Size	
25.09.25	1 : 50	A1	
Drawn	Chk.	Job No. S	JB Ard
AL	WG		evel 2, 49 urry Hills
Drawing No.		Revision _T	61 2 039

DA-4051


ills NSW 2010

NOT FOR CONSTRUCTION

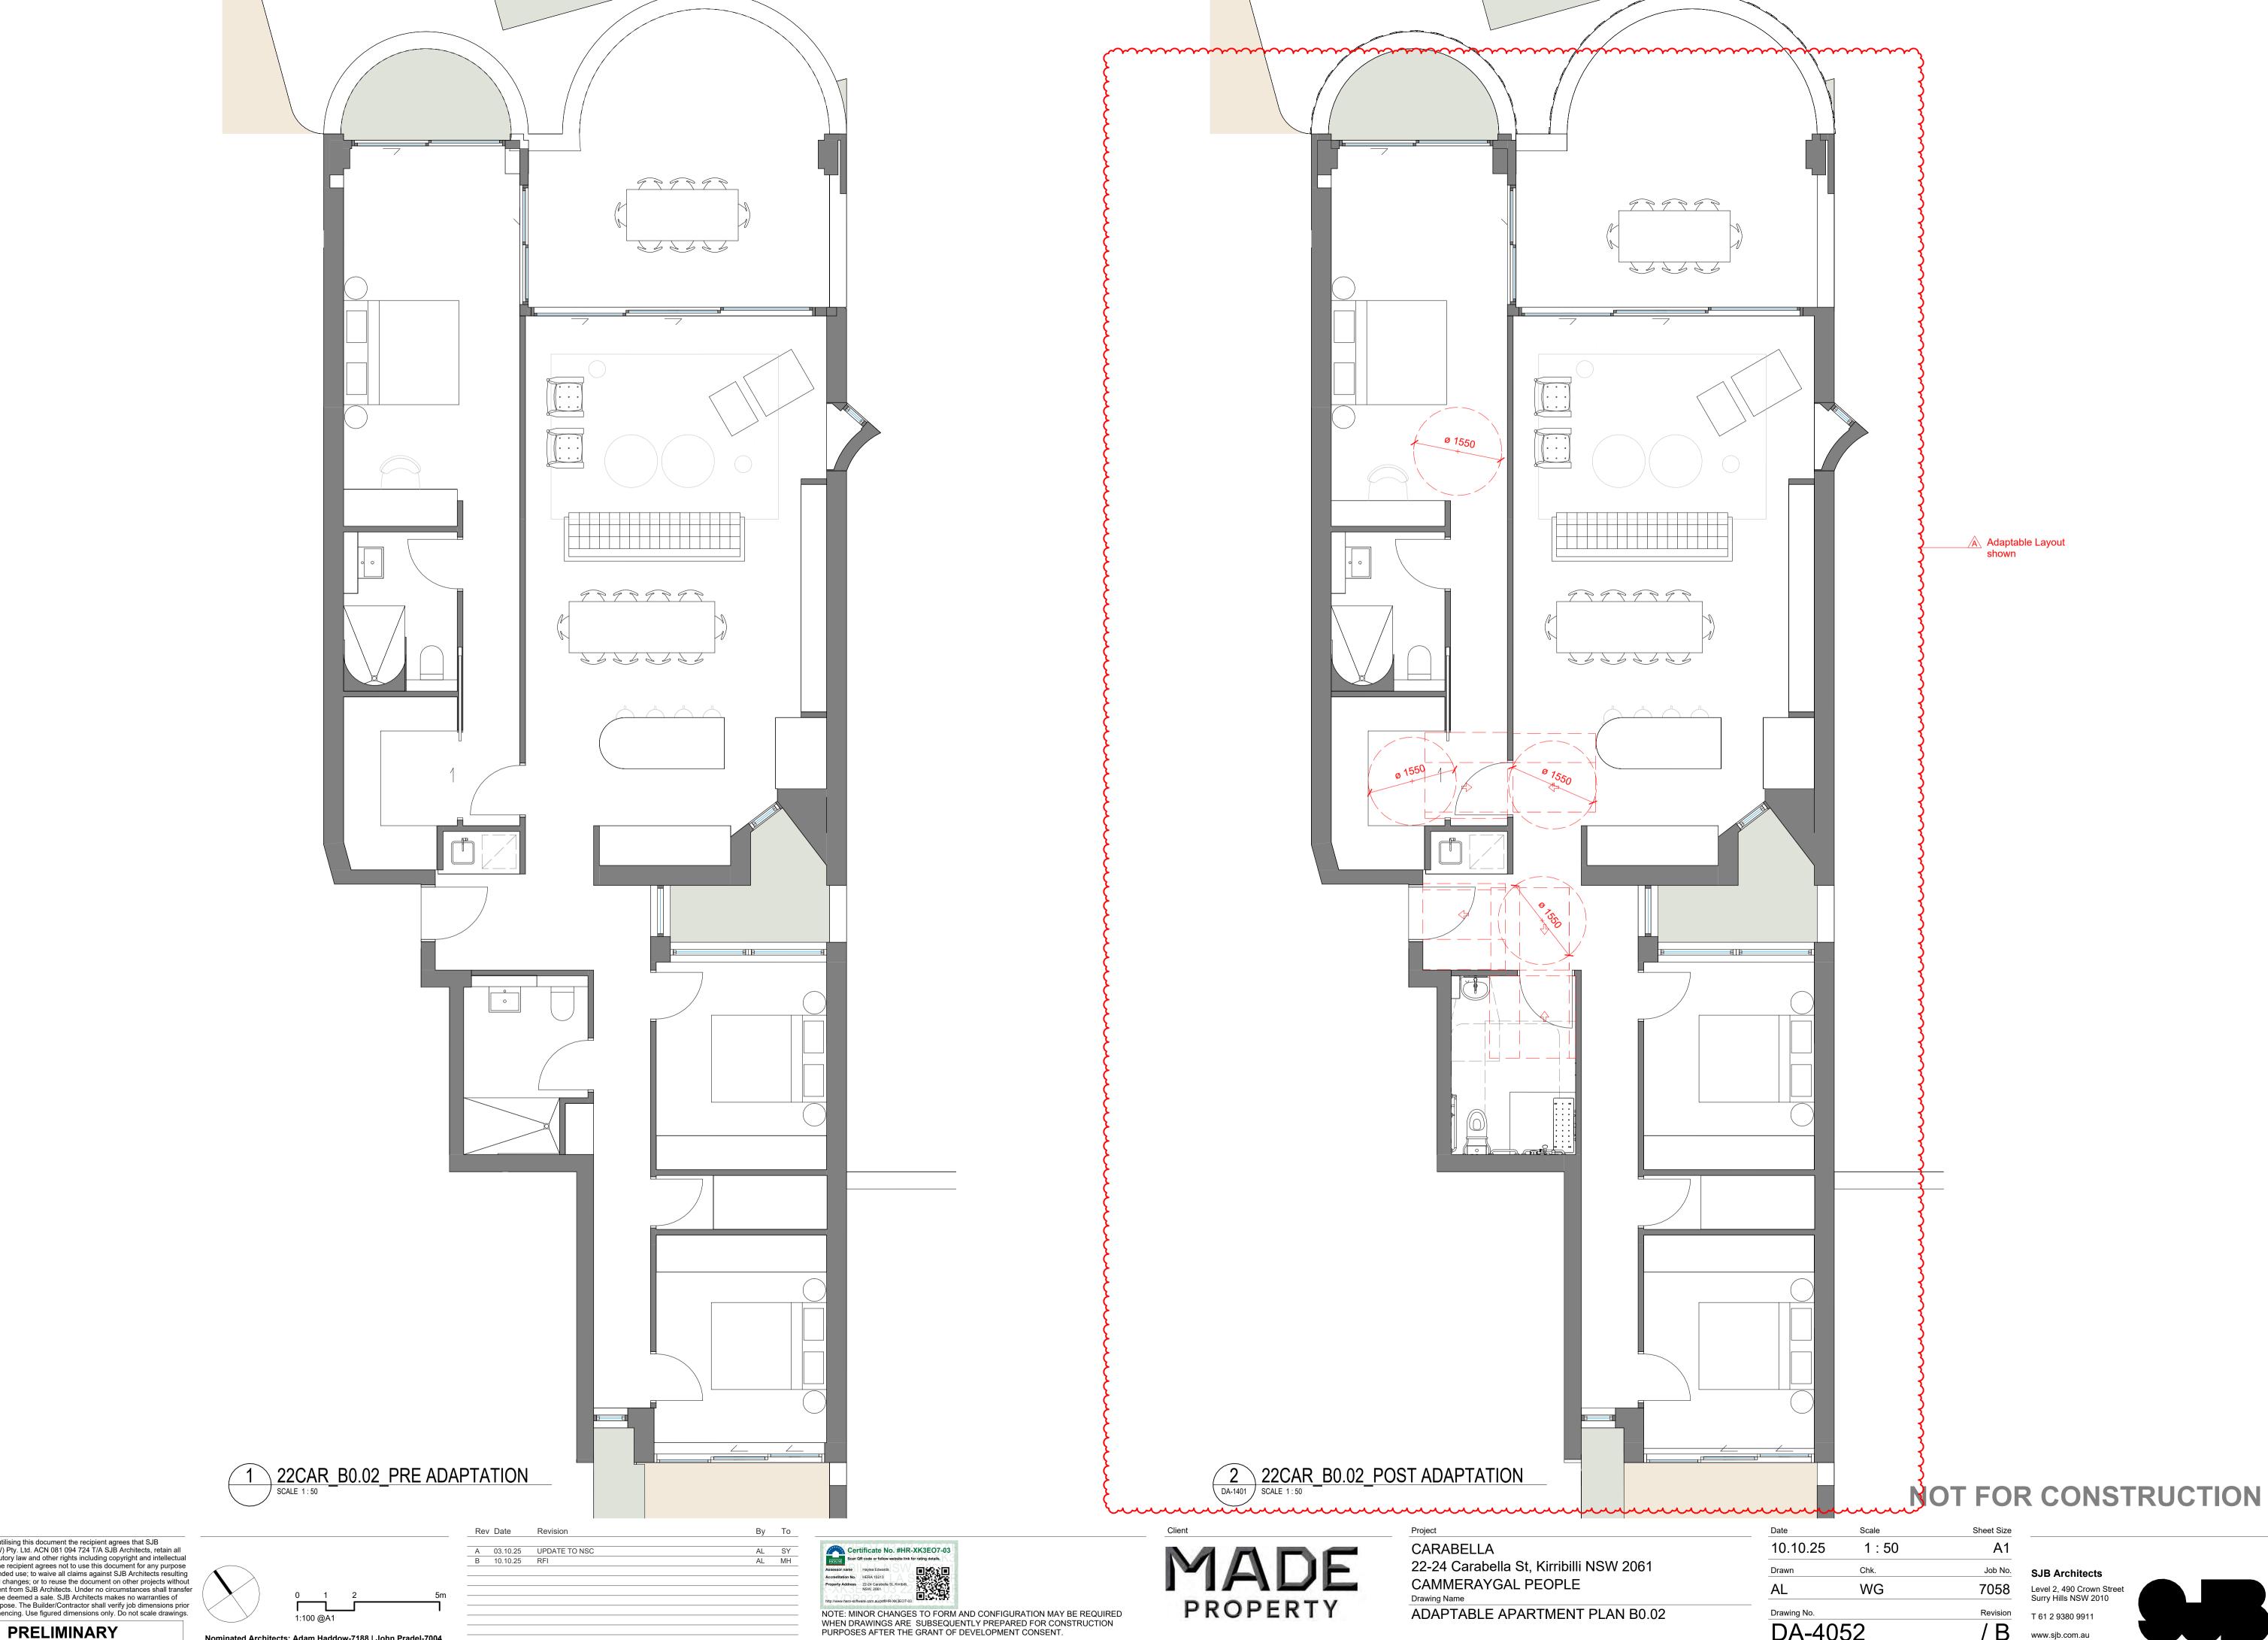

In accepting and utilising this document the recipient agrees that SJB Architecture (NSW) Pty. Ltd. ACN 081 094 724 T/A SJB Architects, retain all common law, statutory law and other rights including copyright and intellectual property rights. The recipient agrees not to use this document for any purpose other than its intended use; to waive all claims against SJB Architects resulting from unauthorised changes; or to reuse the document on other projects without prior written consent from SJB Architects. Under no circumstances shall transfer of this document be deemed a sale. SJB Architects makes no warranties of fitness for any purpose. The Builder/Contractor shall verify job dimensions prior to any work commencing. Use figured dimensions only. Do not scale drawings.

Nominated Architects: Adam Haddow-7188 | John Pradel-7004

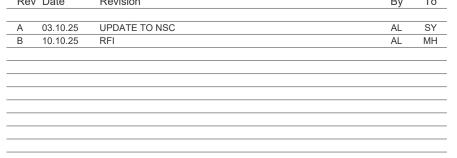



Date	Scale	Sheet Size
10.10.25	1 : 50	A1
Drawn	Chk.	Job No.
AL	WG	7058
Drawing No.		Revision
DA-4052		/ B

www.sjb.com.au