NORTH SYDNEY COUNCIL REPORTS



#### SUPPLEMENTARY REPORT OF ANNELIZE KAALSEN (AK PLANNING) DATED 18 FEBRUARY 2022

SUBJECT:	LPP01: 21 KING GEORGE STREET, LAVENDER
	BAY
APPLICATION NO.	DA 216/20
AUTHOR:	ANNELIZE KAALSEN (AK PLANNING)
DATE:	22 FEBRUARY 2022

	Attachments:
1. Amended Architectural Plans, Basement plan & existing	ground plane
2. Additional	View Analysis
3. Previous Assessment Report (LPPO	2 01.12.2021)

#### 1. Purpose of the Addendum

The purpose of this Addendum Report is to provide consideration for the additional information submitted by the applicant in response to the deferral by the North Sydney Local Planning Panel (NSLPP) on 1 December 2021 "for further information and analysis on height, view loss and setbacks to Bay View Street. Concerns were raised by the Panel about the height of the proposed dwelling and whether compliance has been achieved with Clause 4.3 in NSLEP 2013".

#### 2. Background

On 1 December 2021, DA216/21 (LPP02) the NSLPP deferred the application seeking additional information particularly with respect to building height and view loss.

The Panel minutes are as follows:-

"The Council Officer's Report, Recommendation and Conditions are noted by the Panel. The Panel considered that the compliance with the maximum height standard was not clearly expressed and raised concerns in relation to view impacts arising from the dwelling, particularly arising from the north-eastern corner of the additions.

The Panel resolved to defer the application for additional information to address the following:

1. **Revised building height compliance diagrams,** building elevations and sections based on an accurately determined existing ground line. The Panel noted the subfloor level of the existing dwelling may result in a non-compliance with the 8.5m maximum height standard which has not been adequately addressed and is not supported by an updated Clause 4.6 written request for variation.

2.	Amended plans to incorporate the amendments recommended by the consultant
	planner in Condition C1 of the report. Those amendments being:

- a) The fixed metal blade structures located on the northern and eastern elevations of the proposed first floor terrace is to be deleted.
- b) The proposed fixed metal / solid balustrade on the northern and eastern elevations of the proposed first floor terrace, is to be deleted from the proposal and replaced with a glass balustrade.
- c) The north-eastern corner of the proposed first floor terrace is to remain clear of any structures / BBQ facilities and cabinetry. The area measuring 1.5m from the NE corner along the northern elevation.
- 3. **Further consideration** should be given to the possibility of increased views that will be available if the building was setback in accordance with the DCP at the corner of King George Street and Bay View Street
- 4. **Examine** the opportunity to reduce the size of the basement.
- 5. **A revised view impact analysis** is required which accurately projects a compliant building height line and accurately depicts the impacts from the surrounding neighbouring properties.

<u>Panel Reason</u>: The matter was deferred for further information and analysis on height, view loss and setbacks to Bay View Street. Concerns were raised by the Panel about the height of the proposed dwelling and whether compliance has been achieved with Clause 4.3 in NSLEP 2013

On 22 December 2021 amended plans were submitted in response to the panel's decision. Details of the amendments are included below. Additional supporting information was provided on 14 January 2022 in the form of updated shadow diagrams.

#### 3. Notification

On 27 January 2022 Council notified the amended plans in accordance with the requirements of Council's Community Participation Plan. The notification processes provided a period for further submissions to be made between 1 February and 15 February 2022. Issues raised in the submissions received in response to this notification period are summarised below.

#### 4. Amended Proposal

In response to the deferral by the NSLPP the application, amended plans have been submitted incorporating the following changes:

- The metal blade structures on the northern and eastern elevations of the first-floor terrace have been deleted; and
- the roof over the first floor terrace now allows for a 300mm "kick-up" to remove the need for a down pipe in the north-eastern corner.

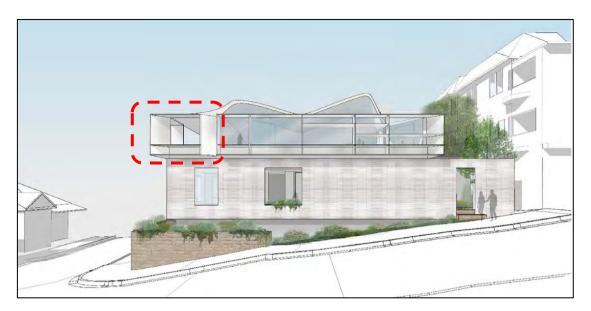


Figure 1: Original King George Street photomontage

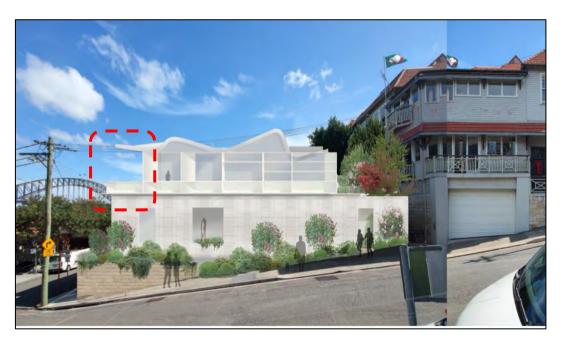


Figure 2: Amended King George Street photomontage

#### 5. Consideration

#### **Building Height compliance**

#### Clause 4.3 of NSLEP 2013 Heights of Building

Concern was raised regarding the accuracy of the height of the proposed building relative to the existing ground line. It was submitted by residents that the footpath level (especially along King George Street) should be used to determine the existing ground level.

The maximum permissible building height for the subject site is 8.5m pursuant to Clause 4.3(2) in NSLEP 2013. Building height is defined under Clause 1.4 of the NSLEP 2013 as follows:

#### **building height** (or **height of building**) means—

- (a) in relation to the height of a building in metres—the vertical distance from ground level (existing) to the highest point of the building, or
- (b) in relation to the RL of a building—the vertical distance from the Australian Height Datum to the highest point of the building, including plant and lift overruns, but excluding communication devices, antennae, satellite dishes, masts, flagpoles, chimneys, flues and the like.

Ground level (existing) is defined in the LEP as follows:

ground level (existing) means the existing level of a site at any point.

In order to determine the height of the proposed development it is essential to nominate an **existing** ground level in order to measure building height and not natural ground level. When dealing with development sites with existing structures, the NSW Land & Environment Court (the Court) has clarified the approaches to adopt when analysing existing levels.

In **Betta v Council of the City of Sydney** the Court found that "the level of the footpath at the boundary bears a relationship to the context and the overall topography that includes the site and remains relevant once the existing building is demolished". As such in this Court judgement the footpath level was used to determine the existing ground because the existing building occupied the whole of the site and accordingly there was no ground adjoining or under the building, from which the existing ground level could be determined by a survey plan. The LEC decision in **Bettar v Council of the City of Sydney [2014] NSWLEC 1070** relied upon the footpath level and an extrapolation method for determining the existing ground level.

Unlike *Bettar v Council of City of Sydney*, the subject site has existing ground/earth surrounding the dwelling along the northern; southern and western sides. In addition, the site has an existing basement and sub-floor level under part of the existing dwelling with existing ground levels.

The existing ground levels measured along the western end of the existing dwelling is RL19.63; RL19.89 and RL19.83 respectively. The applicant undertook additional spot level surveys under the existing dwelling demonstrating an existing subfloor level of RL18.71 falling to RL18.47 and an existing basement at RL17.56 – refer to **Figure 3.** These RL's were used to extrapolate the existing ground level below the existing building – refer to existing ground plane at **Figure 4.** This is in accordance with standard practise and considered appropriate for determining maximum building height.

#### SUPPLEMENTARY DATED 18 FEBRUARY 2022



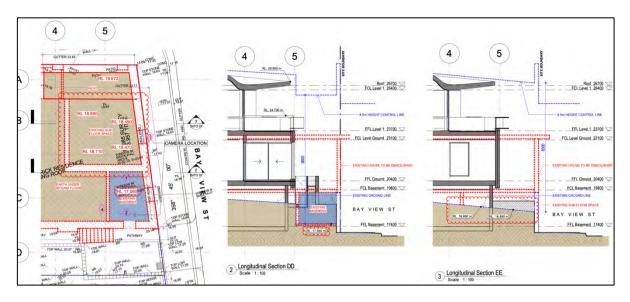


Figure 3: Basement level and additional sections plan

Concern was raised within the submissions, that the proposal relies on the existing patio level (RL19.67) in order to achieve building height compliance. However long section EE demonstrates that even if an RL of 18.69 were to be applied within the north-eastern most corner, consistent with the adjoining subfloor level, the proposal would still comply with the maximum building height.

In addition, no part of the proposed development including the amended "kick-up" roof form over the first floor terrace protrudes over or forward the existing basement.

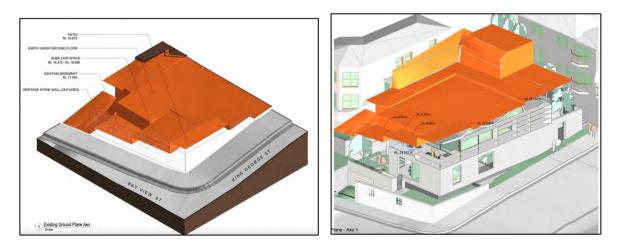


Figure 4: Existing ground plane

Figure : 8.5m height plane

The proposal results in a maximum building height of 8.3m, which is compliant with Clause 4.3 o the NSLEP 2013 – see **Figure 5 and Figure 6.** 

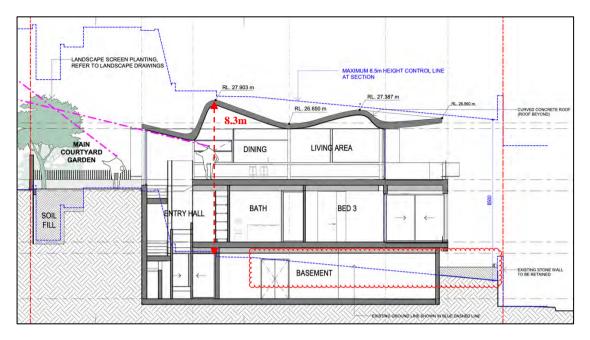


Figure 6: Section AA

#### Amendments as recommended by Condition C1

The intention of Condition C1 is to retain more of the existing views in its entirety without structures unduly interfering with the view line / corridor. The amended plans have deleted the fixed metal blade structures located on the northern and eastern elevations of the proposed first floor, however the fixed metal / solid balustrade on the northern and eastern elevations remain in place.

In addition, the amended plans did not shift the proposed BBQ facility away from the northeastern corner which was-required to allow for a less obstructed view corridor.

The applicant submitted that the recommended Conditions C1(b) and (c) would render the terrace unusable with no significant material gain in the extent of views to be retained from the units within No. 21 Waiwera Street.

Additional view analysis was submitted and a summary of the impact on views from No. 21 Waiwera Street as a result of the proposed solid balustrade and BBQ facilities is provided below:-

Unit	Comment
Unit 9	The iconic landmarks sit above the proposed development. The balustrade and BBQ does not affect this view line.
Unit 10	The iconic landmarks sit largely above proposed development with the solid balustrade and BBQ obstructing the roof of No 37 Bay View Street and not the iconic views.
Unit 14	The proposed first floor level removes the view of the Sydney Opera House from the living room window, noting that any two storey development on the site will impact on the view from this window. As such protecting the view from the balcony becomes even more important. Removing the solid balustrade and shifting the BBQ over will retain more of the Sydney Opera House – refer to <b>Figure 7</b>

Unit 17 The proposed balustrade and BBQ is located to the west of the Opera House and impacts the view of the Sydney Harbour Bridge – refer to **Figure 8**. The applicant submitted that this impact is insignificant in the context of the larger views that are to be retained including the iconic Sydney Harbour Bridge arch. However by removing the solid balustrade and shifting the BBQ over more of the Sydney Harbour Bridge will be retained especially from the right hand window.


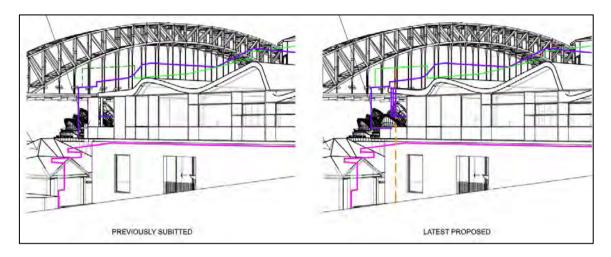


Figure 7: Unit 14 Previous view from balcony

Now proposed

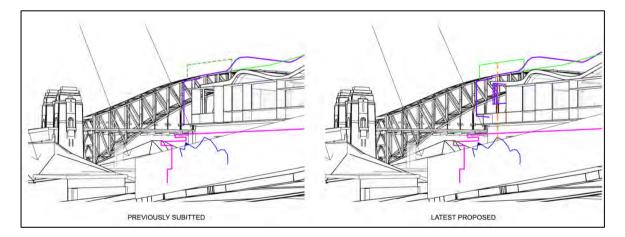

#### Figure 8: Unit 17 Previous view from left hand window

Now proposed

Of concern is not only the solidness of the balustrade but also the nature being a box to match the northern elevation which creates massing within the view corridors. This box balustrade also sits forward of the front setback alignment – refer to Section 4.3 below.

In conclusion, the original recommendation to allow for a glass balustrade in lieu of a solid balustrade and locating the BBQ further away from the north-eastern corner remains.

#### Views available if building was setback in accordance with the DCP

Pursuant to P1 of Section 1.4.6 of NSDCP 2013, the primary street setback is to match the alignment of the primary facades of buildings on adjoining properties. However, P1 further states that when a varied setback occurs (as is the case along Bay View Street due to the angled street boundary), the average of the setbacks of those primary facades is to be used, resulting in an average setback of 4.15m. Even when applying a matched street alignment to the adjoining measured perpendicular to the street boundary, a setback of 4m is evident.

The proposed ground floor is setback 2.1m whilst the box balustrade to the first floor terrace is setback 1.6m and the façade of the first floor is setback 5.5m from Bay View Street.

The applicant submitted that the proposal "matches" the general alignment of the primary façade established by Nos. 18; 20 and 38 Bay View Street – refer to **Figure 9** below, and therefore complies. Notwithstanding, the additional view analysis allowed for a 4.1m primary street setback to Bay View Street in order to demonstrate the impact on views afforded to No. 21 Waiwera Road.



Figure 9: Applicants interpretation of "matched" street alignment Red dotted line demonstrating a perpendicular "matched" approach

It is acknowledged that a compliant ground floor setback would not significantly increase iconic views, noting that, the only additional views that would be available to surrounding development would be views of No. 37 Bay View Street, with the exception of Unit 17, which would retain more of the Sydney Harbour Bridge due to the upward angled view.

The ground floor and solid box balustrade of the first floor terrace encroach the 4.1m setback within the northern eastern corner of the site. This element of the proposal also sits within the iconic view line. The solid balustrade allows for more structures or massing within the setback and will impact on views afforded to the units within No. 21 Waiwera Street. Accordingly, removing the solidness of the non-complying bulky balustrade and structures within the north-eastern most part of the terrace, will allow the terrace to visually fade within the view corridor and free up more of the iconic views.

#### Opportunity to reduce the size of the basement

The applicant submitted that the turning circles would not work if the basement was any smaller, with cars required to utilise the full extent of the basements to enter and exit the site in a forward direction – refer to **Figure 10**.

This statement is acknowledged but it does not account for the size of the "drainage void" spaces needed to ensure a dry basement and large plant room. Notwithstanding Council's engineers raised no concern with the extent of the basement as proposed and the assessment (subject to conditions of consent) as per the original assessment report remains.

Moreover, the proposed basement sits within the envelope above with no impact on the site's ability to achieve site cover or landscape area controls and is considered appropriate in the context.

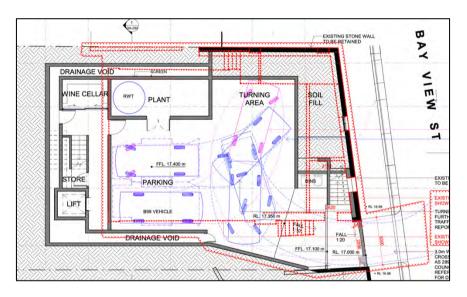


Figure 10: Basement with turning circles

#### **Revised view analysis**

The applicant submitted additional view analysis demonstrating the effect of Condition C1(a) as well as having a complying front setback to Bay View Street – refer to points 4.2 and 4.3 above.

As demonstrated in point 4.1 above the proposal complies with the building height and accurately reflects the existing ground plane as well as the 8.5m height plane, and no revised view analysis is required in this regard.

#### 1. Submissions received on additional information

The owners of adjoining properties and the Lavender Bay Precinct were notified with respect to the additional information received between **27 January 2022 and 10 February 2022.** The notification has attracted **eleven (11)** submissions including one from the Lavender Bay Precinct Committee. The submissions are available online via Council's online DA tracking.

Concerns raised are the same as addressed within the original assessment report. The **new** planning issues raised in the submissions are:-

- Garage location off Bay View Street resulting in dangerous traffic conditions
- The applicant did not address the recommendations made by the NSLPP

With regard to the proposed basement and vehicular entry, it is noted that the proposal seeks approval for only two carparking spaces (not four as noted) and it does not include a car stacker. Councils engineers had no concern with the location of the proposed basement entry off Bay View Street relative to the intersection with King George Street, subject to standard conditions of consent. The application includes turning circles demonstrating safe maneuverability to allow vehicles to enter and leave the site in a forward direction.

The NSLPP has access to all the submissions as well as the additional information submitted by the applicant.

This addendum report allows for a review / assessment of the information submitted by the applicant in response to the NSLPP recommendation. In this regard, the applicant may choose not to respond to certain aspects of the recommendation, however in this case the applicant as evident by the GYDE letter dated 22 December 2021, has had regard for all the recommendations made by the Panel.

#### 2. Conclusion and recommendation

The applicant has demonstrated the accuracy of the existing ground level plane which was used to determine the 8.5m height plane, with the development application complying with Clause 4.3 in NSLEP 2013.

The development application was amended by deleting the metal blade structures on the northern and eastern elevations of the first-floor terrace, whilst the roof over now allows for a 300mm "kick-up" to remove the need for a down pipe in the north-eastern terrace corner. The solid box or blade balustrade were not removed as recommended by Condition C1(b) and the BBQ were not shifted over, away from the north-eastern corner as per Condition C1(c).

In this regard the applicant submitted that the removal of the solid balustrade and BBQ structure, would render the terrace unusable with no significant material gain in the extent of views to be retained from the units within No. 21 Waiwera Street.

The additional view loss diagrams, which includes consideration for a complying front / primary street setback, demonstrates that the ground floor setback / massing does not impact on iconic views. However, the first floor solid balustrade and BBQ structure, introduces massing within the view corridor. Its removal will afford more "clean" views of the Sydney Opera House and the Sydney Harbour Bridge and as such the recommendation to remove these remain as per the original assessment report.

#### **RECOMMENDATION:**

1. That the Panel note this supplementary report and determine the application in accordance with the previous recommendation for approval subject to changes to conditions described below.

Drawing	Rev	Title	Drawn By	Dated
Number				
DA091	А	Demolition Plan	Saville Isaacs	09/06/21
DA098	А	Site Analysis Plan	Saville Isaacs	09/06/21
DA102	С	Plan Basement	Saville Isaacs	14/09/21
DA103	С	Plan Ground Floor	Saville Isaacs	14/09/21
DA104	С	Plan First Floor	Saville Isaacs	14/09/21
DA105	С	Roof Plan	Saville Isaacs	14/09/21
DA201	В	Elevation North	Saville Isaacs	14/09/21
DA202	В	Elevation East	Saville Isaacs	14/09/21
DA203	В	Elevation South	Saville Isaacs	14/09/21
DA204	В	Elevation West	Saville Isaacs	14/09/21
DA205	А	Elevation south boundary	Saville Isaacs	14/09/21
DA251	С	Sections	Saville Isaacs	14/09/21
DA252	В	Sections	Saville Isaacs	14/09/21
DA253	А	Sections	Saville Isaacs	14/09/21
DA111	А	Area Plan	Saville Isaacs	09/06/21
DA355	В	External Finishes – View A	Saville Isaacs	21/09/21
DA356	В	External Finishes – View B	Saville Isaacs	21/09/21
L100	E	Landscape concept plan	Spirit Level	12/05/21
L102	Е	Landscape planting plan	Spirit Level	12/05/21

2. That Condition No. A1 be amended to reflect the amended plans as follows:-

3. That Condition No C2 be amended to reflect the amended plans as follows:-

#### **Design Amendments**

- C1. Prior to the issue of any construction certificate the following design amendments are required to the plans forming part of Condition A1 of this consent:
  - a) The proposed fixed metal / solid balustrade on the northern and eastern elevations of the proposed first floor terrace, is to be deleted from the proposal and replaced with a glass balustrade.
  - b) The north-eastern corner of the proposed first floor terrace is to remain clear of any structures / BBQ facilities and cabinetry. The area measuring 1.5m from the NE corner along the northern elevation.

Architectural plans satisfying the requirements of this condition must be submitted to the Council for assessment and approval, prior to the issue of any Construction Certificate.

(Reason: To ensure view sharing is maintained)

#### Signed

Annelize Kaalsen INDEPENDENT CONSULTANT PLANNER

Endorsed by:

David Hoy TEAM LEADER ASSESSMENTS

Endorsed by

Stephen Beattie MANAGER DEVELOPMENT SERVICES



22 February 2022

Ken Gouldthrop General Manager North Sydney Council PO Box 12 NORTH SYDNEY NSW 2059 council@northsydney.nsw.gov.au

Attn: Kim Rothe (Senior Assessment Officer – Planning)

Dear Kim,

#### **RESPONSE TO REASONS FOR DEFERRAL – DEVELOPMENT APPLICATION NO. 126/21**

#### 1. INTRODUCTION

This letter has been prepared by Gyde Consulting (Gyde) in relation to Development Application (DA) No. 126/21. DA No. 126/21 was referred to the North Sydney Local Planning Panel (NSLPP) on Wednesday 1 December 2021. The Council's assessment report recommended that the application be approved subject to conditions. However, the NSLPP at this meeting resolved to defer the matter for additional information to address the following:

1. Revised building height compliance diagrams, building elevations and sections based on an accurately determined existing ground line. The Panel noted the sub-floor level of the existing dwelling may result in a non-compliance with the 8.5m maximum height standard which has not been adequately addressed and is not supported by an updated Clause 4.6 written request for variation.

2. Amended plans to incorporate the amendments recommended by the consultant planner in Condition C1 of the report. Those amendments being:

a. The fixed metal blade structures located on the northern and eastern elevations of the proposed first floor terrace is to be deleted.

b. The proposed fixed metal / solid balustrade on the northern and eastern elevations of the proposed first floor terrace, is to be deleted from the proposal and replaced with a glass balustrade.

c. The north-eastern corner of the proposed first floor terrace is to remain clear of any structures / BBQ facilities and cabinetry. The area measuring 1.5m from the NE corner along the northern elevation.

3. Further consideration should be given to the possibility of increased views that will be available if the building was setback in accordance with the DCP at the corner of King George Street and Bay View Street.

4. Examine the opportunity to reduce the size of the basement.

5. A revised view impact analysis is required which accurately projects a compliant building height line and accurately depicts the impacts from the surrounding neighbouring properties.

This letter has been prepared to address the items identified above and is supported by additional information, including amended and additional architectural plans and updated view analysis prepared by Architecture Saville Isaacs.



#### 2. PROPOSED AMENDMENTS

Amendments have been made to the architectural plans in response to the NSLPP's reasons for deferral, including:

- Deletion of the metal blade structures on the northern and eastern elevations of the first-floor terrace; and
- "Kicking-up" of the roof by 301 millimetres above the first-floor terrace to remove the need for a down pipe in the terrace's corner.

Refer to the amended architectural plans prepared by Architecture Saville Isaacs for further details of these amendments.

#### 3. RESPONSE TO THE REASONS FOR DEFERRAL

#### 3.1. Building Height

The first item of additional information that was requested by the NSLPP in their deferral of DA No. 126/21 included:

1. Revised building height compliance diagrams, building elevations and sections based on an accurately determined existing ground line. The Panel noted the sub-floor level of the existing dwelling may result in a non-compliance with the 8.5m maximum height standard which has not been adequately addressed and is not supported by an updated Clause 4.6 written request for variation.

The building height of the proposed development and the accompanying elevations, sections and height plane diagrams are based on an accurately determined existing ground line as shown by the additional information provided. The basement plan, elevations and images that are included on Drawing Nos. INFO 01 and INFO 02, show that located behind the heritage-listed sandstone wall on the Bay View Street frontage is a basement and sub-floor space. However, these do not extend past the existing basement wall that is located to their west as shown in the black line in Figure 1.

Subsequently, the basement plan, sections and images show that the joists of the ground floor of the existing dwelling house are raised above earth/soil, which demonstrates the natural ground level (existing). At the existing wall that separates the basement and sub-floor space from the earth under the existing dwelling house, the earth has a Reduced Level (RL) of 18.870 (approx.), which sits over 1-metre higher than the RL of the footpath at the corner of King George and Bay View Streets However, it should also be noted that the existing natural ground level of the existing patio, which sits closest to the footpath at the corner of Bay View Street and King Georg Street sits even higher at RL 19.650. The levels increase west across the site consistent with the natural topography of the site and surrounds, which slopes upwards along King George Street.

As the site's existing ground levels are known, the existing natural ground level has been determined by taking the lowest level directly and vertically beneath the highest part of the proposed development. This particular method is the typical method that is used to calculate existing natural ground level. Furthermore, this means that the extrapolation method for determining existing natural ground level, which

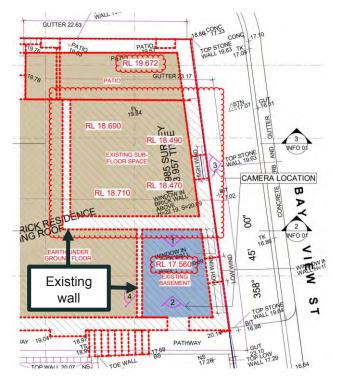


Figure 1: Basement levels plan extract



involves extrapolating the grounds levels found on the footpath (i.e., outside the site) across the entire site, is not required to be utilized for this proposed development and would be less accurate in this case.

The proposed development has been designed to sit entirely above the earth to the west of the existing basement wall and does not protrude into the existing basement or sub-floor space that sits between the heritage-listed wall on the boundary and the existing basement wall. Additional longitudinal sections have been prepared to demonstrate this and are included on Drawing No. INFO 01. These sections form part of the amended architectural plan package and are extracted at Figure 2 and Figure 3 overleaf. It is noted that upon further inspection of the existing basement and the measurement of its levels, the existing natural ground level within the basement has been confirmed to be higher than previously shown on the plans. The existing ground line has been updated on the accompanying documentation to accurately reflect this. However, this does not affect the proposed development as it does not sit above any part of that existing basement.

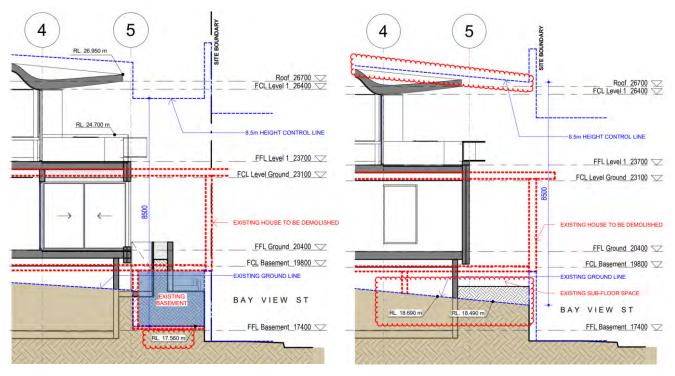


Figure 2: Longitudinal Section DD extract

Figure 3: Longitudinal Section EE extract

Noting that existing natural ground level has been accurately depicted on the plans as demonstrated in this section, it can be confirmed that the proposed development complies with the 8.5-metre height limit for the site, as demonstrated by the updated height plane diagrams (Drawing Nos. DA-352 and DA-353) that are extracted below.





Figure 4: Max. 8.5m Height Plane Diagram 1 extract

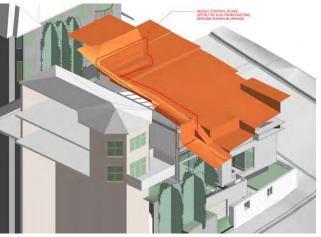


Figure 5: Max. 8.5m Height Plane Diagram 2 extract

Therefore, a written request under Clause 4.6 is not required and has not been prepared as part of this detailed response; however, the proposed development is consistent with the objectives of this development standard as follows:

Table 1: Assessment against the objectives of the height of buildings development standard

OBJECTIVES	PROPOSED DEVELOPMENT
(a) to promote development that conforms to and reflects natural landforms, by stepping development on sloping land to follow the natural gradient,	The proposed development has been designed to specifically relate to the existing topography of the site and its two street frontages, as demonstrated within the architectural plans provided. In addition to the vehicular access being proposed at the lowest point of the site to minimise the extent of excavation, the main bulk of the proposed development is situated closest to the corner of Bay View and King George Streets, with the building stepped away from the south-eastern corner and western portions of the site. This respects the existing elevated western yard on the site, as well as the relationship to the immediately adjacent properties, and allows for the proposed development to "nestle" into the existing excavated lower section of the site. These is demonstrated in the photomontages extracted below.
	Figure 6: Proposed photomontage – King George Street

#### ATTACHMENT TO LPP01 - 2/03/22



OBJECTIVES	PROPOSED DEVELOPMENT
	<image/>
(b) to promote the retention and, if appropriate, sharing of existing views,	A detailed view analysis has previously been prepared by Architectural Saville Isaacs and submitted to Council for assessment, which focuses specifically on No. 21 Waiwera Street. This view analysis has been updated and accompanies this response in relation to the NSLPP's resolution. Noting that the proposed development is compliant with the height of buildings development standard, any view loss resulting from the proposed development is consistent with what is to be expected of a two-storey development. Nonetheless, the fixed metal blade structures have been removed from the first-floor terrace to improve the extent of existing views that are maintained by the proposed development. Refer to the updated view analysis for further details. A view sharing assessment was also prepared by Richard Lamb & Associates and submitted as part of the original DA,
	which assessed the effect of the proposed development on existing views of No. 38 Bay View and No. 19 King George Streets. This assessment concluded that the proposed development is reasonable and supported on view sharing grounds. Since this view sharing assessment was originally prepared, it is noted that the overall building height of the proposed development has been reduced by 0.6 metres, therefore minimising any view loss from these adjacent properties. Whilst the view sharing assessment has not been updated, the view analysis diagrams prepared by Architecture Saville Isaacs that formed the basis of assessment, was updated to reflect the decrease in height. These diagrams are included as part of the accompanying analysis.
(c) to maintain solar access to existing dwellings, public reserves and streets, and to promote solar access for future development,	Detailed shadow diagrams have previously been prepared by Architecture Saville Isaacs and submitted to Council for assessment. These diagrams demonstrate that the shadows cast by the proposed development at mid-winter are

OBJECTIVES	PROPOSED DEVELOPMENT
	consistent with that expected by a two-storey development, noting such development is permitted with consent on the site.
	Specifically, these diagrams show that between 10am to 12pm the shadow cast by the proposed development does not preclude a significant proportion of the primary private open space located at the rear of No. 38 Bay View Street from receiving direct solar access during mid-winter. The shadow diagrams also show that between 11am and 3pm, the north-facing windows of No. 38 Bay View Street's dining and informal living areas receive direct solar access at mid-winter. These shadow diagrams also show in relation to the other adjacent property at No. 19 King George Street, any additional shadow cast by the proposed development is because of the boundary fence and proposed new planting, with the built form falling short of the common boundary, and therefore no windows on its eastern elevation will be affected. The shadows cast by the proposed development do not reach the opposite side of Bay View Street until 2pm at mid-winter.
	Updated shadow diagrams accompany this response, which take into account the proposed amendments to the plans; however, any increase in the shadows that are cast is minimal. Additional shadow diagrams highlighting the shadows cast specifically by the proposed amendments are also being prepared and will be submitted as soon as possible.
(d) to maintain privacy for residents of existing dwellings and to promote privacy for residents of new buildings,	The proposed development has been designed to maintain the visual privacy of residents living at the adjacent properties.
	In relation the property at No. 38 Bay View Street, the southern elevation does not include any first-floor windows, and windows at the ground floor of the proposed development will not be visible behind the boundary fence. Screen planting is also proposed along most of this boundary, and a compliant side setback has been provided.
	The proposed development will also not result in any adverse visual privacy impacts to the adjacent No. 19 King George Street, being significantly setback from this common boundary, sitting below the ground floor finished floor level of the adjacent residential development both as existing and approved, retaining the existing hedging along this boundary and providing additional screen planting to a height of 5-6 metres.
(e) to ensure compatibility between development, particularly at zone boundaries,	The site is not located at the boundary of two or more zones. Nonetheless, the proposed development has been designed

#### ATTACHMENT TO LPP01 - 2/03/22



OBJECTIVES	PROPOSED DEVELOPMENT
	to be compatible with development on surrounding properties, although it is noted compatibility does not mean "same". The site sits between the more recently constructed and contemporary developments that sit within Bay View Street and the period housing within King George Street. However, the different types of development have common design features that are reflected in the proposed development. This includes siting a two-storey built form above a basement garage that sits behind a sandstone wall and takes advantage of the northerly aspect and existing views. The neutral and earthy colour tones have also been chosen to reflect the existing streetscape within this locality.
(f) to encourage an appropriate scale and density of development that is in accordance with, and promotes the character of, an area,	<text></text>
(g) to maintain a built form of mainly 1 or 2 storeys in Zone R2 Low Density Residential, Zone R3 Medium Density Residential and Zone E4 Environmental Living.	The proposed development is for a two-storey dwelling house located in the R3 Medium Density Residential zone, surrounded by predominately other two-storey dwelling



OBJECTIVES	PROPOSED DEVELOPMENT
	houses. Like most other dwelling houses within this locality, the proposed development sits above a basement garage. Nonetheless, the proposed development does sit significantly lower than the residential development on the adjacent properties as shown in photomontages at Figure 8 and Figure 9.

Overall, the proposed development complies with the height limit and is consistent with the objectives of the standard.

#### 3.2. Design Amendments

The second item of additional information that was requested by the NSLPP in their deferral of DA No. 126/21 included:

2. Amended plans to incorporate the amendments recommended by the consultant planner in Condition C1 of the report. Those amendments being:

a. The fixed metal blade structures located on the northern and eastern elevations of the proposed first floor terrace is to be deleted.

*b.* The proposed fixed metal / solid balustrade on the northern and eastern elevations of the proposed first floor terrace, is to be deleted from the proposal and replaced with a glass balustrade.


c. The north-eastern corner of the proposed first floor terrace is to remain clear of any structures / BBQ facilities and cabinetry. The area measuring 1.5m from the NE corner along the northern elevation.

The proposed development has been amended to comply with part (a) of the requested design amendments. The positive impact of this amendment on existing views from No. 21 Waiwera Street is evident in the updated view analysis, particularly in relation Unit 14 of this residential flat building as is demonstrated within the figures below. These figures show that more existing views of the Sydney Opera House will be retained as a result of this amendment. To understand the view analysis provided below the colours that are shown on the diagrams represent:

- Green 8.5-metre height control plane;
- Pink existing development on the site;
- Blue outline of Opera House (when hidden); and
- Purple outline of previous non-compliant scheme.

Additionally, the red boxes annotated by Gyde on the view analysis diagrams represent the first-floor terrace balustrade.



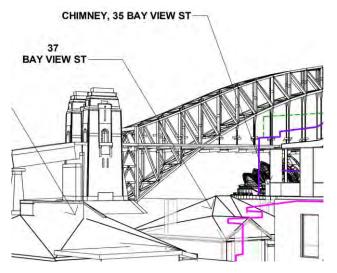

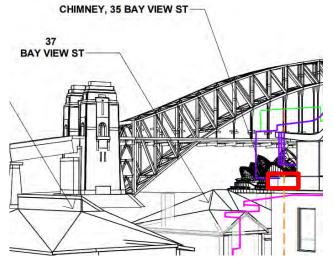


Figure 10: Previous view from Unit 14/ 21 Waiwera Street

Figure 11: Proposed view from Unit 14/ 21 Waiwera Street

The updated view analysis also shows that by deleting the fixed metal blade structures from the first-floor terrace, more existing views of the Sydney Harbour Bridge from Unit 14 and Unit 17 of No. 21 Waiwera Street are to be retained.

The proposed development has <u>not</u> been amended to incorporate items (b) and (c) of the requested design amendments. This is because such amendments would render the north-western corner of the terrace unusable for no significant material gain in the extent of existing views to be retained from the units in No. 21 Waiwera Street. An assessment of the view loss from keeping the balustrade and barbeque as proposed is provided below. It is noted that whilst item (b) requires the entire solid balustrade to be deleted and replaced with glass, the proposed barbeque along the northern elevation of the terrace is only required to be reduced in size by 1.5 metres. Therefore, views through the balustrade would only be approximately half the width of the terrace if glassed, which would be negligible in the overall context of the existing views to be retained from surrounding development.

#### Unit 9/ 21 Waiwera Street

Figure 12 and Figure 13 demonstrate views available from Unit 9 of No. 21 Waiwera Street as a result of the proposed development. These figures show that the proposed development does not impact on existing views of the Sydney Harbour Bridge and Sydney Opera House accessible from the balcony and internally within the unit, noting that during the spring and summer months that these existing views are filtered through surrounding trees. These landmarks sit above the proposed development in the view and are not affected by the balustrade or barbeque. Subsequently, in not adopting items (b) and (c) of the design amendments requested by the NSLPP, the proposed development does not result in any significant view loss impacts from Unit 9 of No. 21 Waiwera Street.





Figure 12: Proposed view from Unit 9/ 21 Waiwera Street



Figure 13: Proposed view from Unit 9/ 21 Waiwera Street

#### Unit 10/ 21 Waiwera Street

Figure 14 and Figure 15 demonstrate views accessible from Unit 10 of No. 21 Waiwera Street because of the proposed development, being through the double doors to the balcony (Figure 11) and the east window (Figure 12) of this unit. Noting that the solid balustrade and barbeque for the full width of the terrace are outlined in red, these figures demonstrate that this portion of the first-floor terrace sits in front of the roof of No. 37 Bay View Street. Subsequently, in not adopting items (b) and (c) of the design amendments requested by the NSLPP, the proposed development does not result in any significant view loss impacts from Unit 10 of No. 21 Waiwera Street.

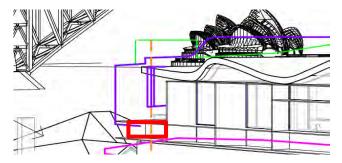


Figure 14: Proposed view from Unit 10/ 21 Waiwera Street

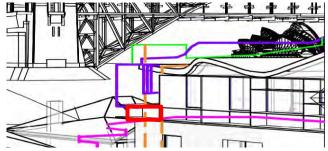


Figure 15: Proposed view from Unit 10/ 21 Waiwera Street

#### Unit 14/ 21 Waiwera Street

Figure 11 and Figure 16 demonstrate views available from Unit 14 of No. 21 Waiwera Street as a result of the proposed development.

From the unit's left-side balcony the proposed development will not impact on views of Sydney Harbour Bridge. This includes the solid balustrade and barbeque for the full width of the terrace as are outlined in red on Figure 11. There are some minor view loss impacts to the Sydney Opera House from the balustrade and barbeque. However, these impacts are insignificant in the context of the larger views that are maintained from this opening, with the proposed amendments allowing for more of the iconic "sails" of the Sydney Opera House to be retained.

From the right-hand window the proposed development does not impact on existing views of the Sydney Harbour Bridge, with the first-floor terrace (including the balustrade and barbeque) sitting completely below its base (see Figure 16). Within the existing view the Sydney Opera House is located to the right of the proposed terrace, and therefore the proposed balustrade and barbeque do not adversely impact on existing views from this right-hand



opening. It should also be noted that any loss of views of the Sydney Opera House is the result of a compliant development and are those reasonably expected of a two-storey development being located on this corner site.

Subsequently, in not adopting items (b) and (c) of the design amendments requested by the NSLPP, the proposed development does not result in any significant view loss impacts from Unit 14 of No. 21 Waiwera Street.

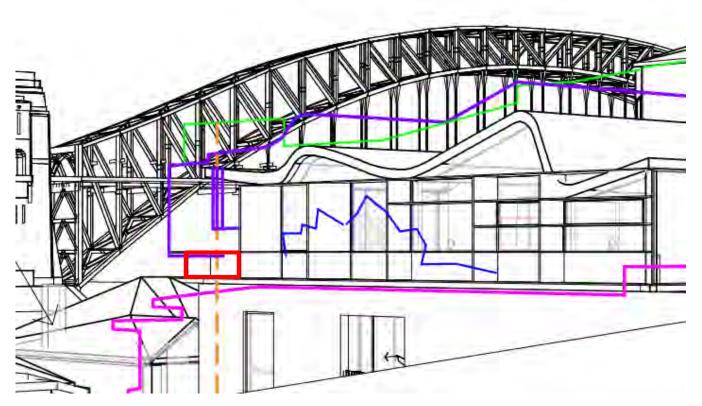
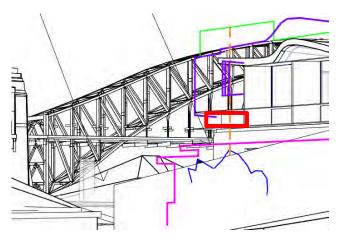


Figure 16: Proposed view through right-hand south-east facing window of Unit 14/21 Waiwera Street

#### Unit 17/ 21 Waiwera Street

Figure 17 and Figure 18 demonstrate views available from Unit 17 of No. 21 Waiwera Street as a result of the proposed development. Noting that the solid balustrade and barbeque for the full width of the terrace are outlined in red, these figures show that this portion of the first-floor terrace sits above and/ or to the west of the Sydney Opera House, and therefore the Sydney Opera House is not relevant in assessing potential view loss impacts. Furthermore, the existing dwelling house on the site currently blocks views of the Sydney Opera House from this unit. The balustrade and barbeque of the first-floor terrace do impact on some views of the Sydney Harbour Bridge, but this impact is insignificant in the context of the larger views that are to be retained by the proposed development, noting that the iconic arch of the Sydney Harbour Bridge will still be visible from Unit 17. Subsequently, in not adopting items (b) and (c) of the design amendments requested by the NSLPP, the proposed development does not result in any significant view loss impacts from Unit 17 of No. 21 Waiwera Street.





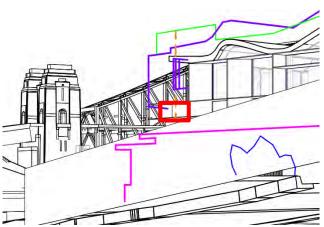


Figure 17: Proposed view from Unit 17/ 21 Waiwera Street

Figure 18: Proposed view from Unit 17/ 21 Waiwera Street

#### 38 Bay View Street and 19 King George Street

The proposed balustrade and barbeque are not visible from Nos. 38 Bay View Street and 19 King George Street, and therefore their retention will not significantly impact on existing views available from these adjacent dwelling houses. The "kicking-up" of the roof to enable the deletion of the down-pipe at the corner of the first-floor terrace will also not impact on an existing views from these immediately adjacent properties as shown in the view analysis.

#### 3.3. Setbacks

The third item of additional information that was requested by the NSLPP in their deferral of DA No. 126/21 included:

3. Further consideration should be given to the possibility of increased views that will be available if the building was setback in accordance with the DCP at the corner of King George Street and Bay View Street.

As detailed within the Councill assessment report that was previously prepared by the independent assessment planner, Part 1.4.6 of the *North Sydney Development Control Plan 2013* (NSDCP 2013) was interpretated to require a 4.15-metre front boundary setback to the site's Bay View Street frontage for the proposed development. As detailed in the response to the request for additional information prepared by Gyde and dated 15 October 2021, the project team's interpretation of this provision is different to that of the independent assessment planner, and for this reason the proposed development's minimum setback of 2.1 metres is considered to be compliant. Nonetheless, the view analysis has been updated to consider the increased views a 4.1-metre setback would provide. The 4.1-metre setback to Bay View Street is indicated on the view analysis diagrams by the orange dotted line.

The main building line of the first-floor of the proposed development is setback over 5 metres from Bay View Street. Whilst the terrace located at the first floor does encroach into the 4.1-metre setback considered to be required, the deletion of the fixed metal blade structures along its northern and eastern elevations as per item 2, is such the view analysis diagrams already demonstrate the maximum views available from achieving this setback.

Setting back the ground floor of the proposed development by 4.1 metres would also not significantly increase views, noting the existing development on the site is built to both boundaries at the corner of Bay View and King Street, as shown by the pink line on the view analysis. The proposed development already improves views by setting back the ground floor by a minimum 2.1 metres, allowing for the creation of a view corridor across the site as demonstrated within the view analysis diagrams, and the provision of landscaping along both street frontages to improve public amenity. If the proposed development were to be further setback at the ground floor to achieve the 4.1 metres, the only additional views that would be available to surrounding development would be views of No. 37 Bay View Street.



It is also noted that the proposed development has a compliant setback of 7.21 metres adjacent No. 38 Bay View Street, and therefore the views demonstrated within the view analysis diagrams are consistent with a compliant development.

Nonetheless, the proposed development is consistent with the objectives of Part 1.4.6 of the NSDCP 2013 as follows:

Table 2: Assessment of Bay View Street setback against Part 1.4.6 of the NSDCP 2013

OBJECTIVE	COMMNENT
O1 To reinforce the characteristic pattern of setbacks and building orientation within the street.	As detailed within Section 5 of Gyde's response to the request for additional information dated 15 October 2021, the proposed development matches the general alignment of the primary façade of the adjacent property at No. 38 Bay View Street, as well as those properties located further south. This is demonstrated within the context plan extract provided below. The general alignment of Nos. 18, 20 and 38 Bay View Street follows a consistent straight line rather than a distance. Nonetheless, it should be noted that proposed development's setback to Bayview Street varies from a minimum of 2.1 metres to a maximum of 7.21 metres. This represents an average setback of 4.63 metres to Bay View Street, which is consistent with the minimum setback to the primary façade of the adjacent property at No. 38 Bay View Street.
O2 To control the bulk and scale of buildings.	The proposed development's setback to Bay View Street does not preclude the proposed development from complying with the relevant controls pertaining to building height, site coverage, landscaped area and un-built upon area, which seek to manage the bulk and scale of development in this locality. Moreover, the proposed development sits below the surrounding development on King George Street and the western side of Bay View Street as shown in Figure 8 and Figure 9, so the proposed bulk and scale is considered acceptable given the relationship to the surrounding



OBJECTIVE	COMMNENT
	buildings. The proposed setbacks also allow for the provision of landscaping along both street frontages to improve public amenity. This is a significant improvement on the existing development, which does not provide any streetscape landscaping.
O3 To provide separation between buildings.	Noting the proposed development's Bay View Street setback varies from 2.1 metres to 7.21 metres and averages 4.63 metres, it is considered to provide adequate separation to the existing development located opposite the site on Bay View Street.
O4 To preserve the amenity of existing dwellings and provide amenity to new dwellings in terms of shadowing, privacy, views, ventilation and solar access.	The proposed development's front setback to Bay View Street does not significantly impact on the amenity of residents within surrounding development as demonstrated within this response and the amended and additional information.
	Specifically, the shadow diagrams show that the proposed development does not cast shadows on the development on the eastern side of Bay View Street at mid-winter until 3pm, will not result in any adverse visual privacy impacts to No. 39 Bay View Street directly opposite the site as only its garage, pedestrian entry and front fence are visible from the street, and will not result in significant view loss impacts as is demonstrated within this section of the response to the deferral.

#### 3.4. Basement

The fourth item of additional information that was requested by the NSLPP in their deferral of DA No. 126/21 included:

#### 4. Examine the opportunity to reduce the size of the basement.

The basement of the proposed development is designed to allow for cars to enter and exit the site in a forward direction, with the size of the basement directly linked to the turning circles required to allow for this to occur. It should be noted that the preservation of the full extent of the heritage-listed wall increased the special requirements for turning cars within the site and therefore the basement size. However, the basement still sits completely under the building above, expect for the access driveway. The turning circles for each of the two (2) car parking spaces within the basement are shown on Drawing No.DA-102. An extract of the basement plan showing the turning circles for each car has been included at Figure 20 below for reference. These diagrams demonstrate that the turning circles would not work if that basement was any smaller, with cars required to utilise the full extent of the basement that is proposed to enter and exit the site in a forward direction.

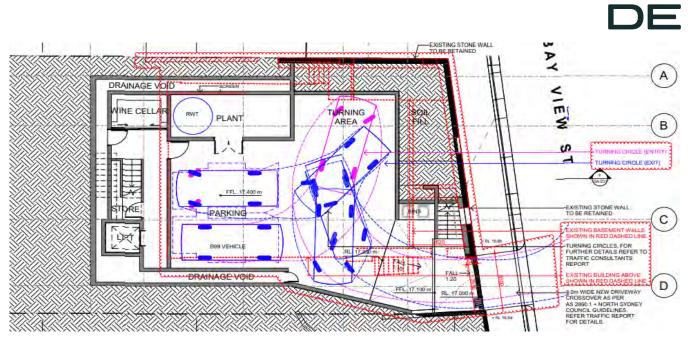


Figure 20: Basement plan extract

It is also noted that the basement does not preclude the proposed development from complying with the following controls:

- Building height;
- Site coverage;
- Landscaped area; and
- Un-built upon area.

For the reasons identified above no changes have been made to the size of the basement as part of this response.

#### 3.5. View Analysis

The fifth item of additional information that was requested by the NSLPP in their deferral of DA No. 126/21 included:

5. A revised view impact analysis is required which accurately projects a compliant building height line and accurately depicts the impacts from the surrounding neighbouring properties.

The view analysis is not required to be updated in response to this item as discussed in detail in Section 3.1. However, an updated view analysis has been provided that reflects the proposed amendments to the development. An assessment of impacts based on this view analysis has been undertaken in Section 3.2, which concludes that the proposed development results in acceptable view loss impacts on surrounding development.

#### 4. CONCLUSION

Based on these amendments that have been made to the architectural plans and the additional supporting information, the proposed development addresses the reasons for deferral within the NSLPP's resolution of 1 December 2021.

Yours sincerely

Tina Christy (Associate Director)

Page 27

## 21 KING GEORGE STREET, NORTH SYDNEY

100mm



0mm

Date Rev Issue	1	CLIENT		,	PROJECT	' TITLE		
13.12.2021 F Issue for DA		MB	,	1	21 King George St	Cover Sheet		
22.02.14 G Issue for DA			· //	1	LAVENDER BAY, NSW 2060	JOB No.	DRAWING No.	REV.
16.02.2022 H Issue for DA				150.	LOT 7 DP 520996	2024	DA-000	H
The Architect shall not be liable for any loss or claims whatsoever arising from or in respect of any errors existing or resulting from data howsoever transferred from the computer system of the Architect to systems of the Client or other Consultants. The recipient of the data shall be responsible for checking accuracy and completeness of data received. Any use of the electronic data in part or whole shall be at the user's risk. The CAD files and their contents are solely representations of the project	NSW Nominated Architects: S. ISAACS #7929 P: 02 - 9086 9000 ABN: 79 124 014 759 F: 02 - 9086 9001	ARCHITECTURE SAVILLE ISAACS PTY LTD	l l		PROJECT DATE ISSUED DATE SCALE @ A3: JAN 08 16.02.2022	STATUS DA ISSUE		

### DRAWING LIST

No.	Sheet Name	Date	Revision
DA-000	Cover Sheet	16.02.2022	
DA-000	Demolition Plan	29.10.2021	hinghin
DA-097	Site Context Plan	09.06.2021	A
DA-097	Site Analysis Plan	09.06.2021	A .
DA-102	Plan Basement	13.12.2021	D
DA-103	Plan_Ground Floor	13.12.2021	hundren
DA-104	Plan First Floor	13.12.2021	D
DA-105	 Roof Plan	16.02.2022	E
DA-201	Elevation North	13.12.2021	С
DA-202	Elevation East	13.12.2021	С
DA-203	Elevation South	13.12.2021	С
DA-205	Elevation South Boundry	14.09.2021	A
DA-251	Sections	16.02.2022	E
DA-252	Sections	14.09.2021	meren
DA-253	Sections	14.09.2021	A
DA-301	Shadows_Winter 9am-10am	10.01.2022	E
DA-302	Shadows Winter 11am-12pm	10.01.2022	E
DA-303	Shadows Winter 1pm-2pm	10.01.2022	E
DA-304	Shadows Winter 3pm	10.01.2022	E
DA-305	Shadows_Equinox 9am / 12pm	10.01.2022	E
DA-306	Shadows Equinox 3pm	10.01.2022	E
DA-310	Shadows_Impact_9am-10am	10.01.2022	D
DA-311	Shadows_Impact_11am-12pm	10.01.2022	D
DA-312	Shadows_Impact_1pm-2pm	10.01.2022	D
DA-313	Shadows_Impact_3pm	10.01.2022	С
DA-352	Max. 8.5m Height Plane Diagram 1	16.02.2022	С
DA-353	Max. 8.5m Height Plane Diagram 2	16.02.2022	С





Date Rev Issue 09.06.2021 A Issue for DA		 2 L	roj 1   .A\ .01
The Architect shall not be liable for any loss or claims whatsoever arising from or in respect of any errors existing or resulting from data howsoever transferred from the computer system of the Architect to systems of the Client or other Consultants. The recipient of the data shall be responsible for checking accuracy and completeness of data received. Any use of the electronic data in part or whole shall be at the user's risk. The CAD files and their contents are solely representations of the project	NSW Nominated Architects: S. ISAACS #7929         P: 02 - 9086 9000         ARCHITECTURE         SAVILLE         ISAACS         PTY LTD           ABN: 79         124         014         759         F: 02 - 9086 9001         23a         KING GEORGE STREET, MaMAHONS POINT, NSW 2060		roj AN


100mm

200mm

5 5			TITLE Site Conte	ext Plan	
VENDER BAY, NSW 2060 T 7 DP 520996			JOB №. 2024	DRAWING №. <b>DA-097</b>	REV. A
JECT DATE	ISSUED DATE 09.06.2021	SCALE @ A3: 1:300	STATUS DA ISSUE		

100m


200m

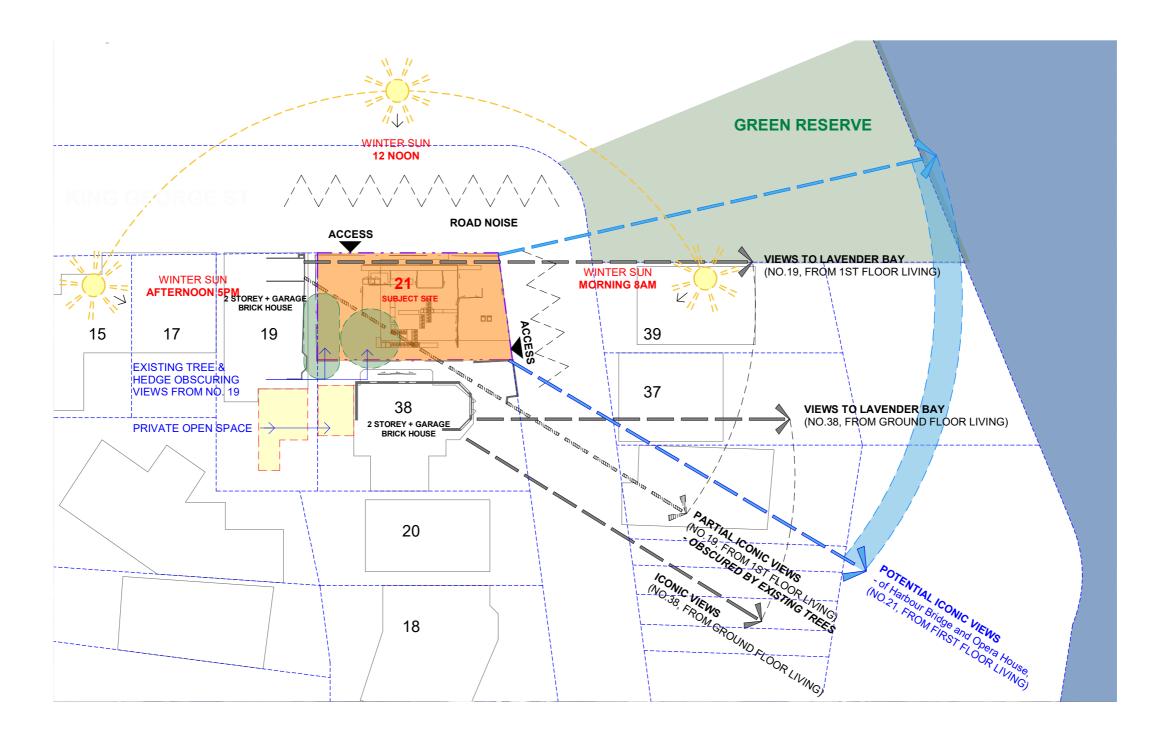


1 Site Analysis - DA Scale 1:500




<sup>JECT</sup> King George St VENDER BAY, NSW 2060 T 7 DP 520996			TITLE Site Analy	vsis Plan	
			JOB No.	DRAWING No.	REV.
			2024	DA-098	Α
JECT DATE 1 08	ISSUED DATE 09.06.2021	SCALE @ A3: 1 : 500	STATUS DA ISSUE		

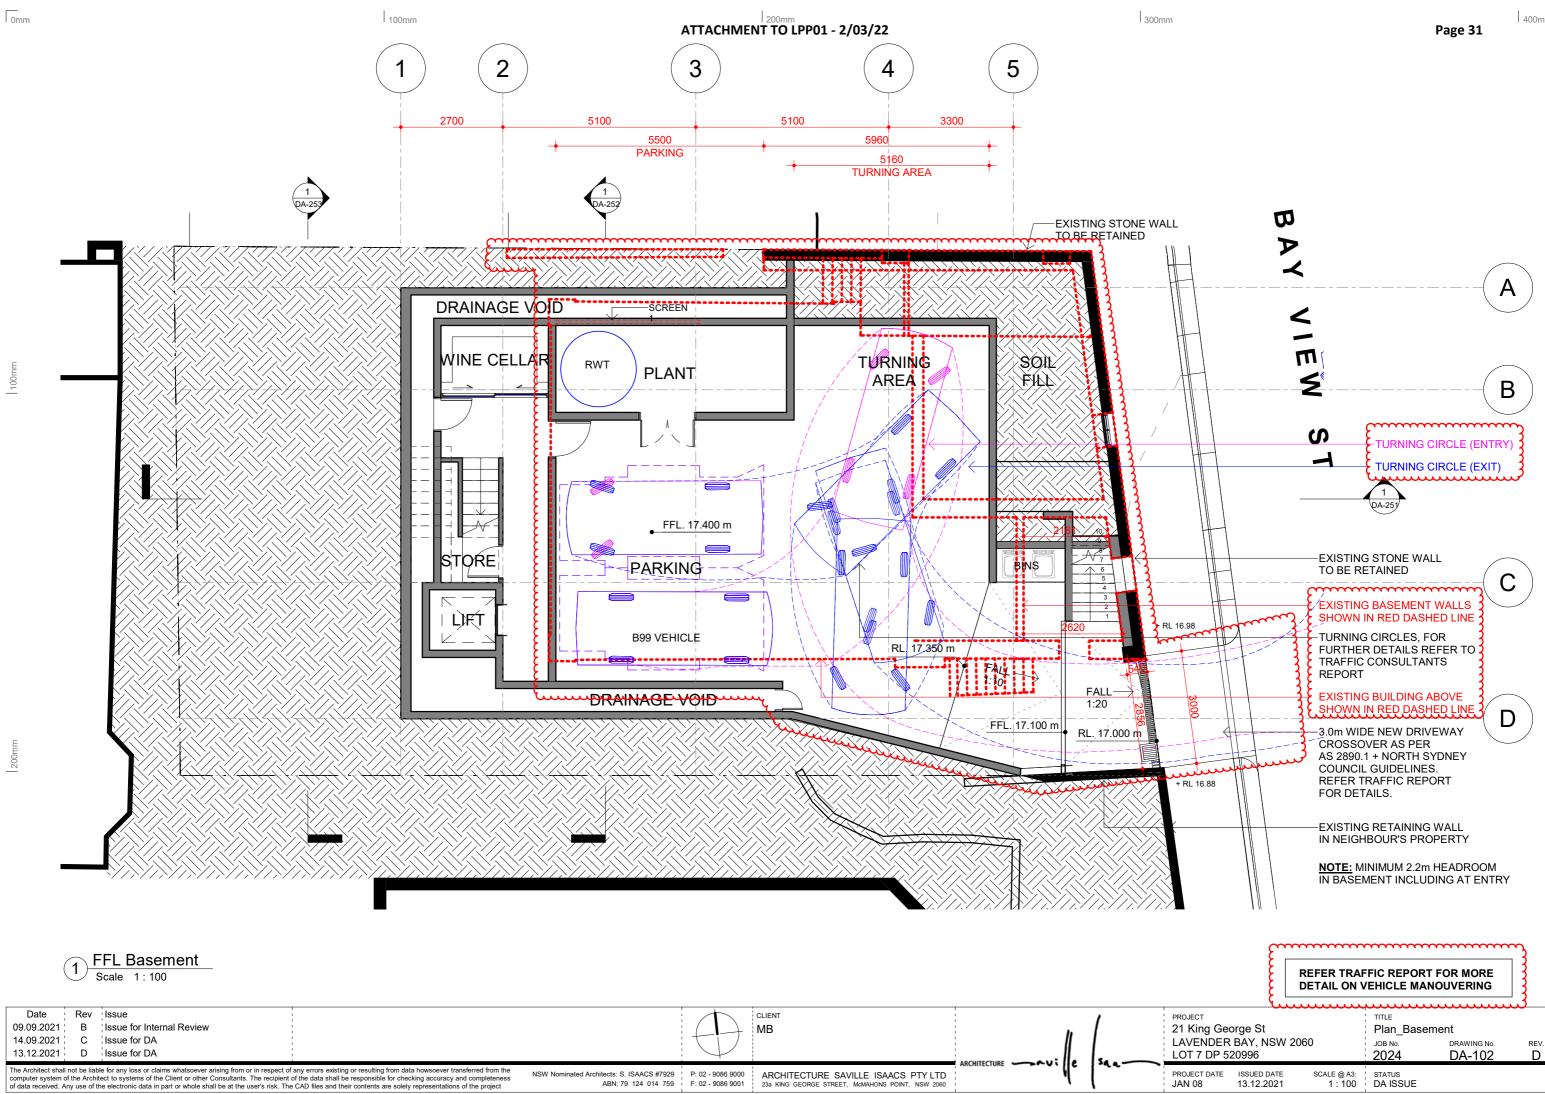

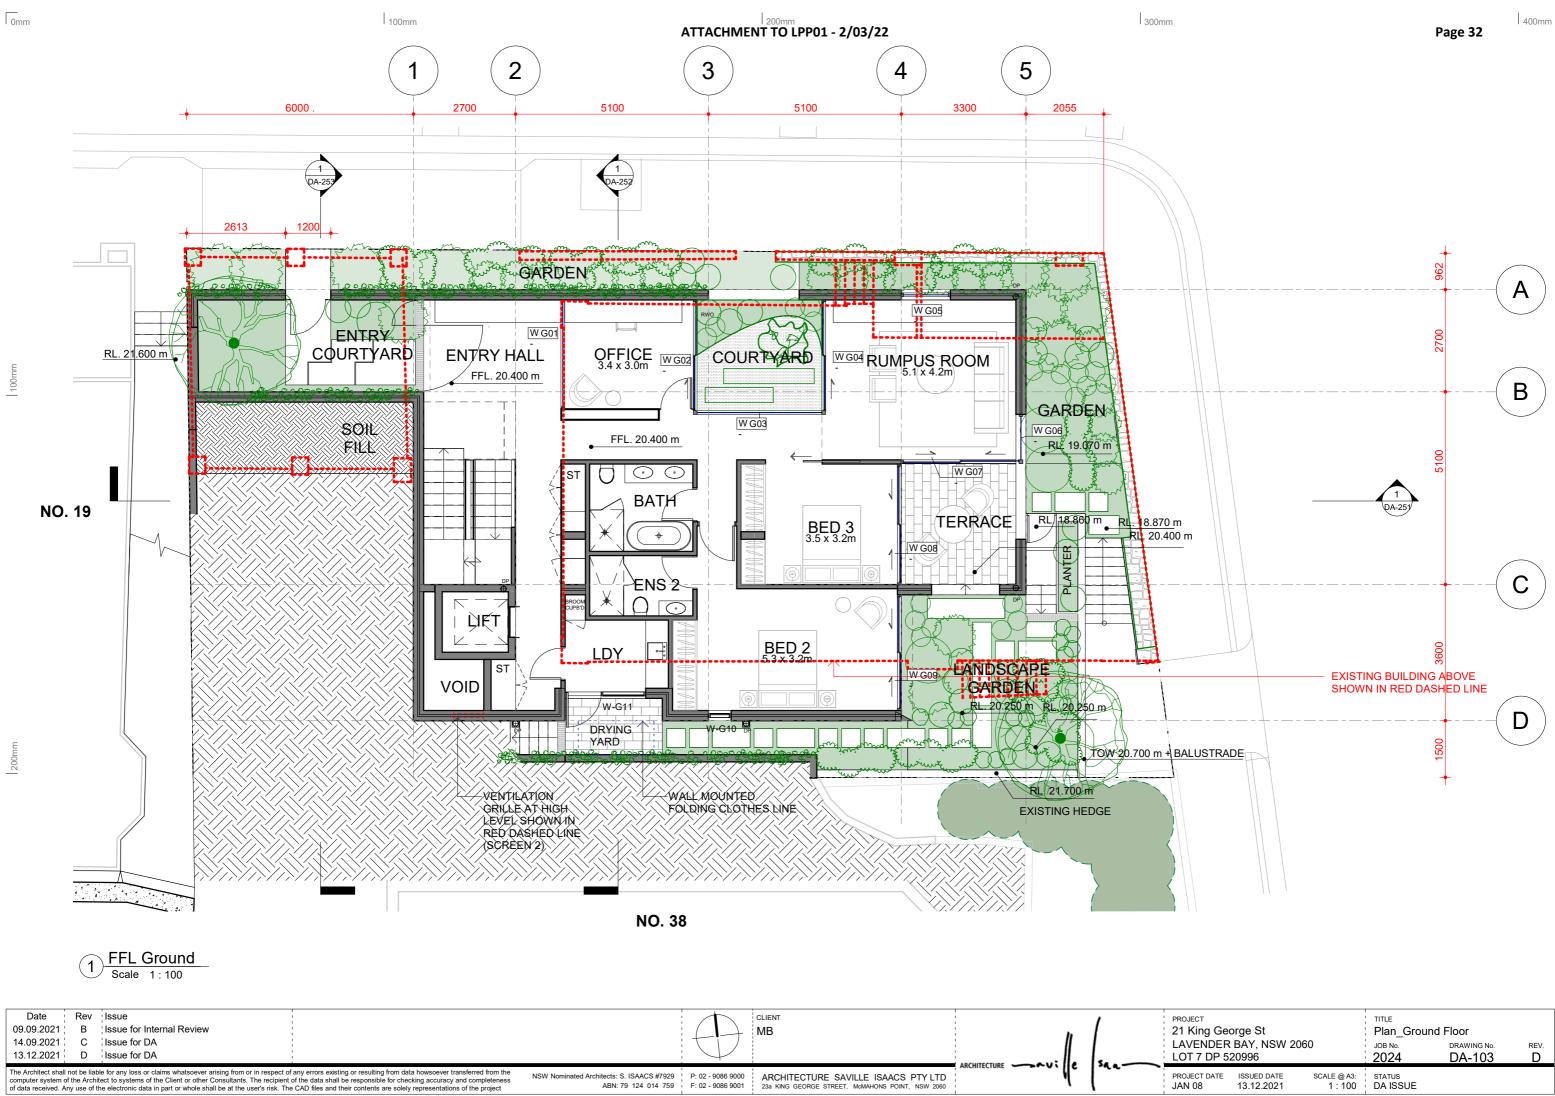

<sup>⊫ECT</sup> King George St VENDER BAY, NSW 2060 T 7 DP 520996			TITLE Plan_Grou	und Floor	
			JOB №. 2024	DRAWING No.	REV. D
JECT DATE	ISSUED DATE 13.12.2021	SCALE @ A3: 1 : 100	STATUS DA ISSUE		

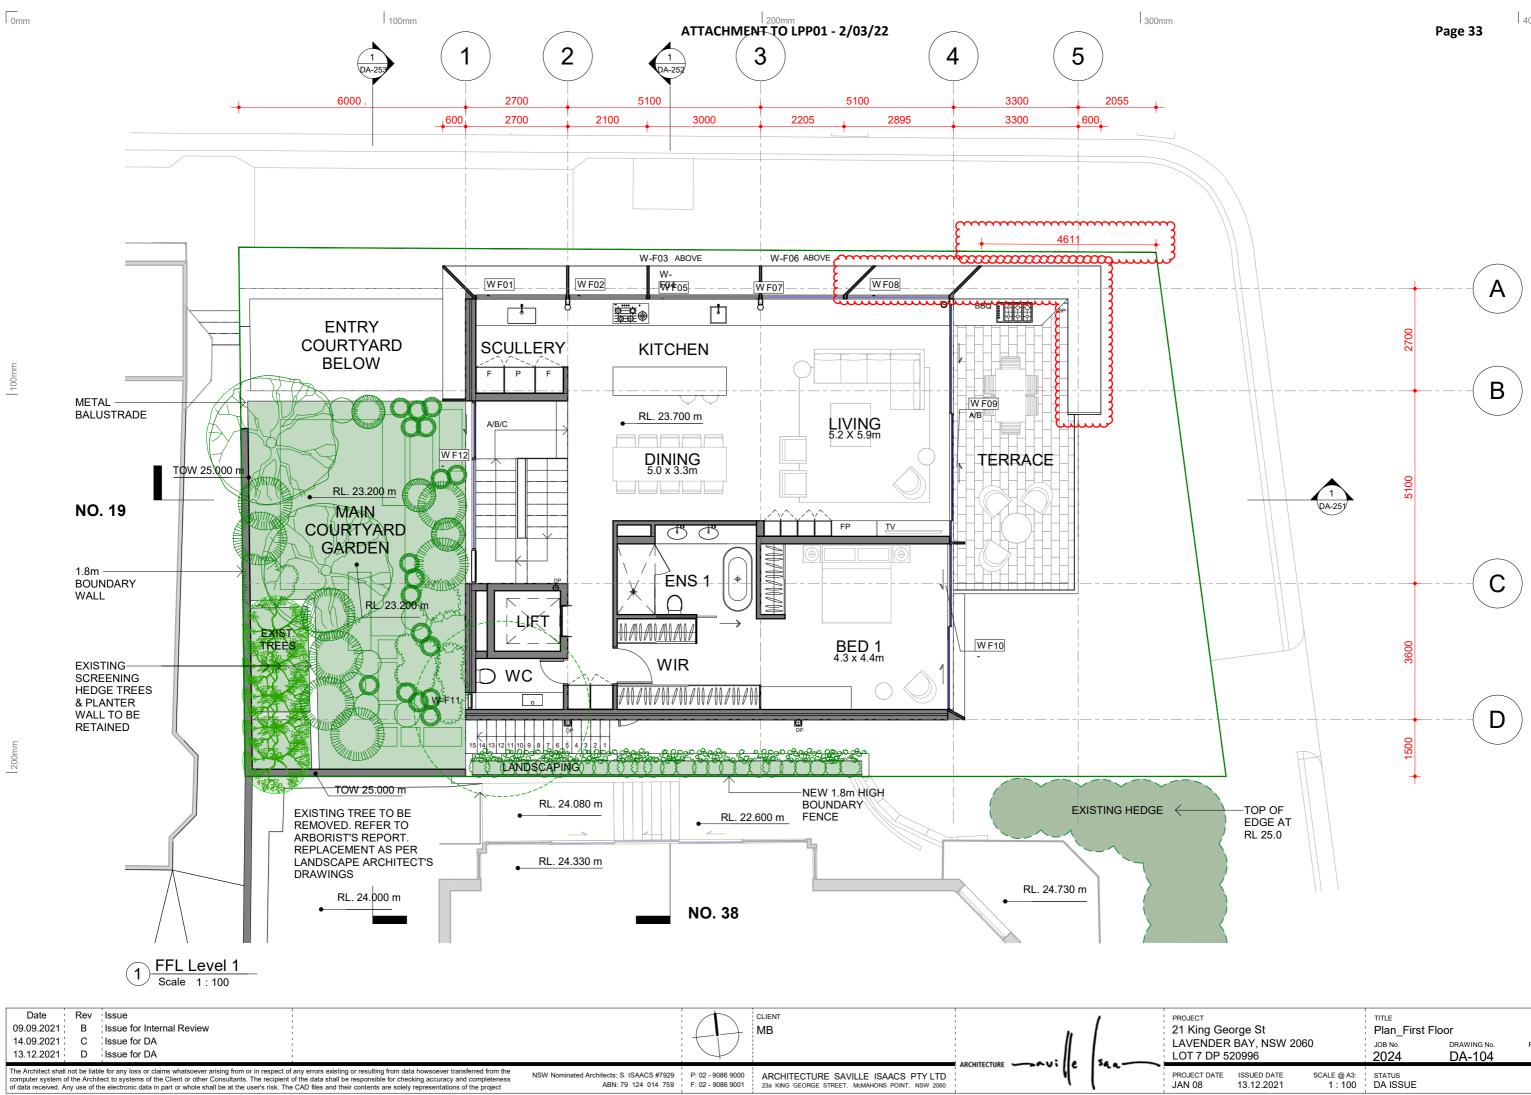


100r

200n

<sup>JECT</sup> King George St VENDER BAY, NSW 2060 T 7 DP 520996			TITLE Plan_First JOB №. 2024	Floor DRAWING No. DA-104	REV. D
JECT DATE 1 08	ISSUED DATE 13.12.2021	SCALE @ A3: 1 : 100	STATUS DA ISSUE		


400mm

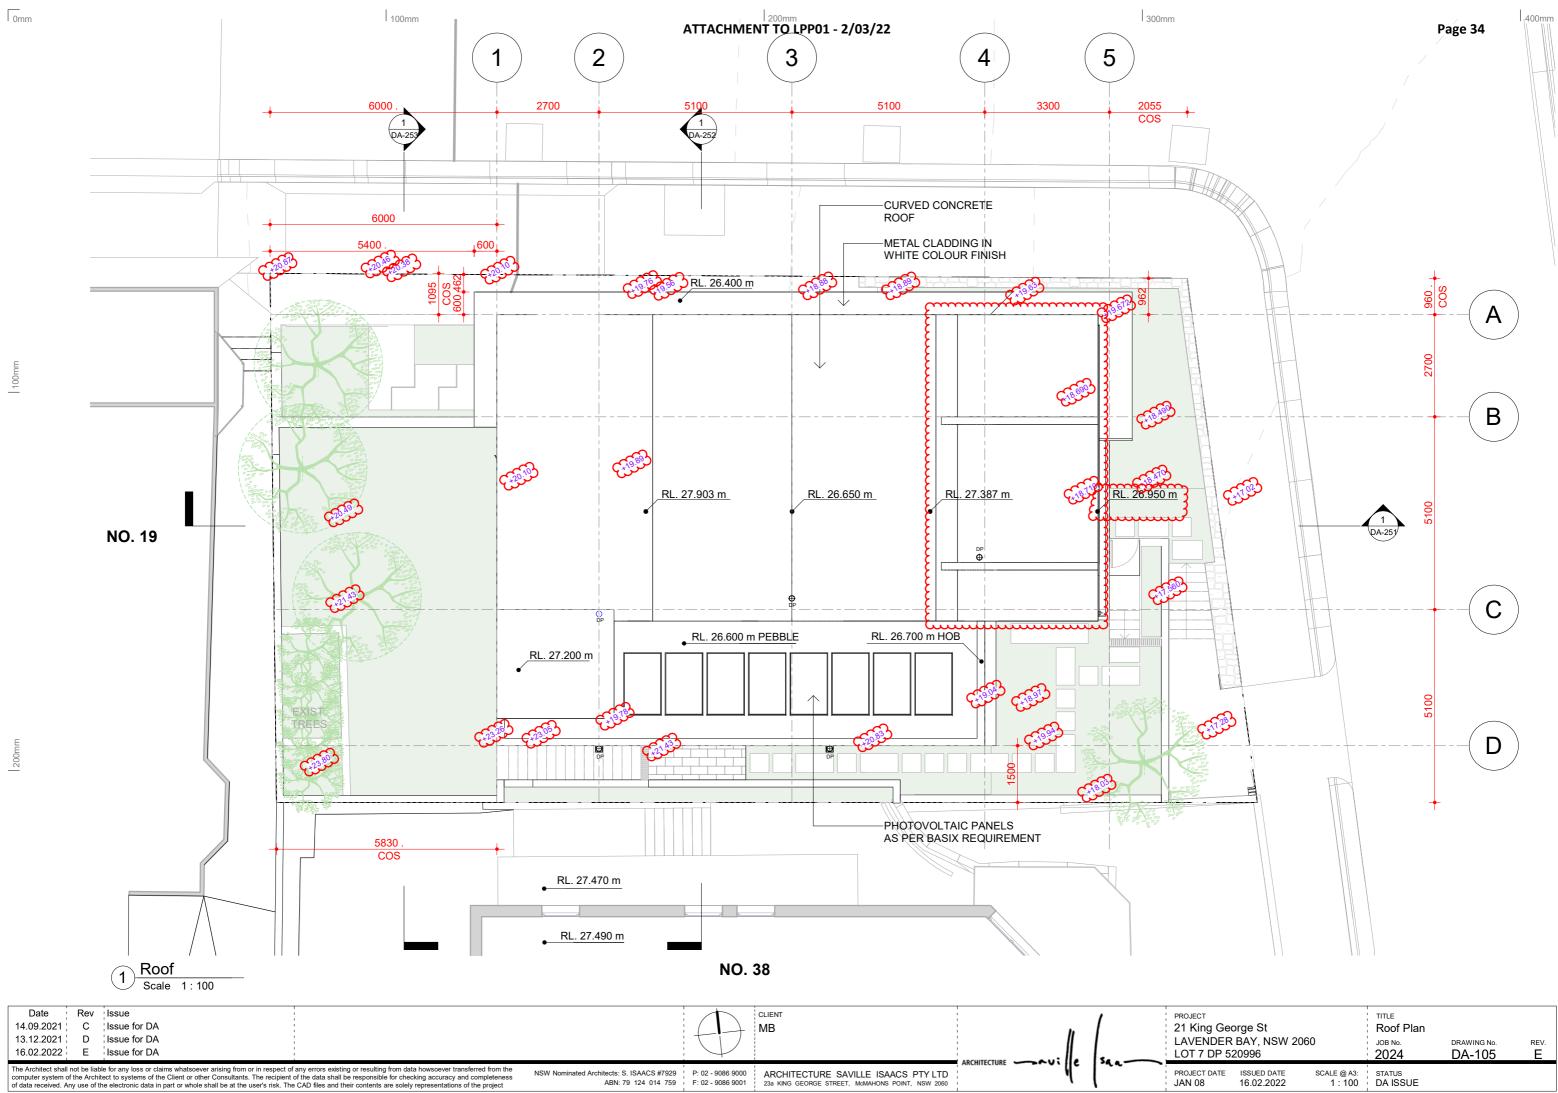

100n

200

JECT TITLE King George St Roof Plan VENDER BAY, NSW 2060 JOB № DRAWING № REV					
<b>o o</b>			1		
T 7 DP 520996 2024 DA-105 E	VENDER BAY, NSW 2060		JOB No.	DRAWING No.	REV.
JECT DATE ISSUED DATE SCALE @ A3: STATUS N 08 16.02.2022 1 : 100 DA ISSUE					

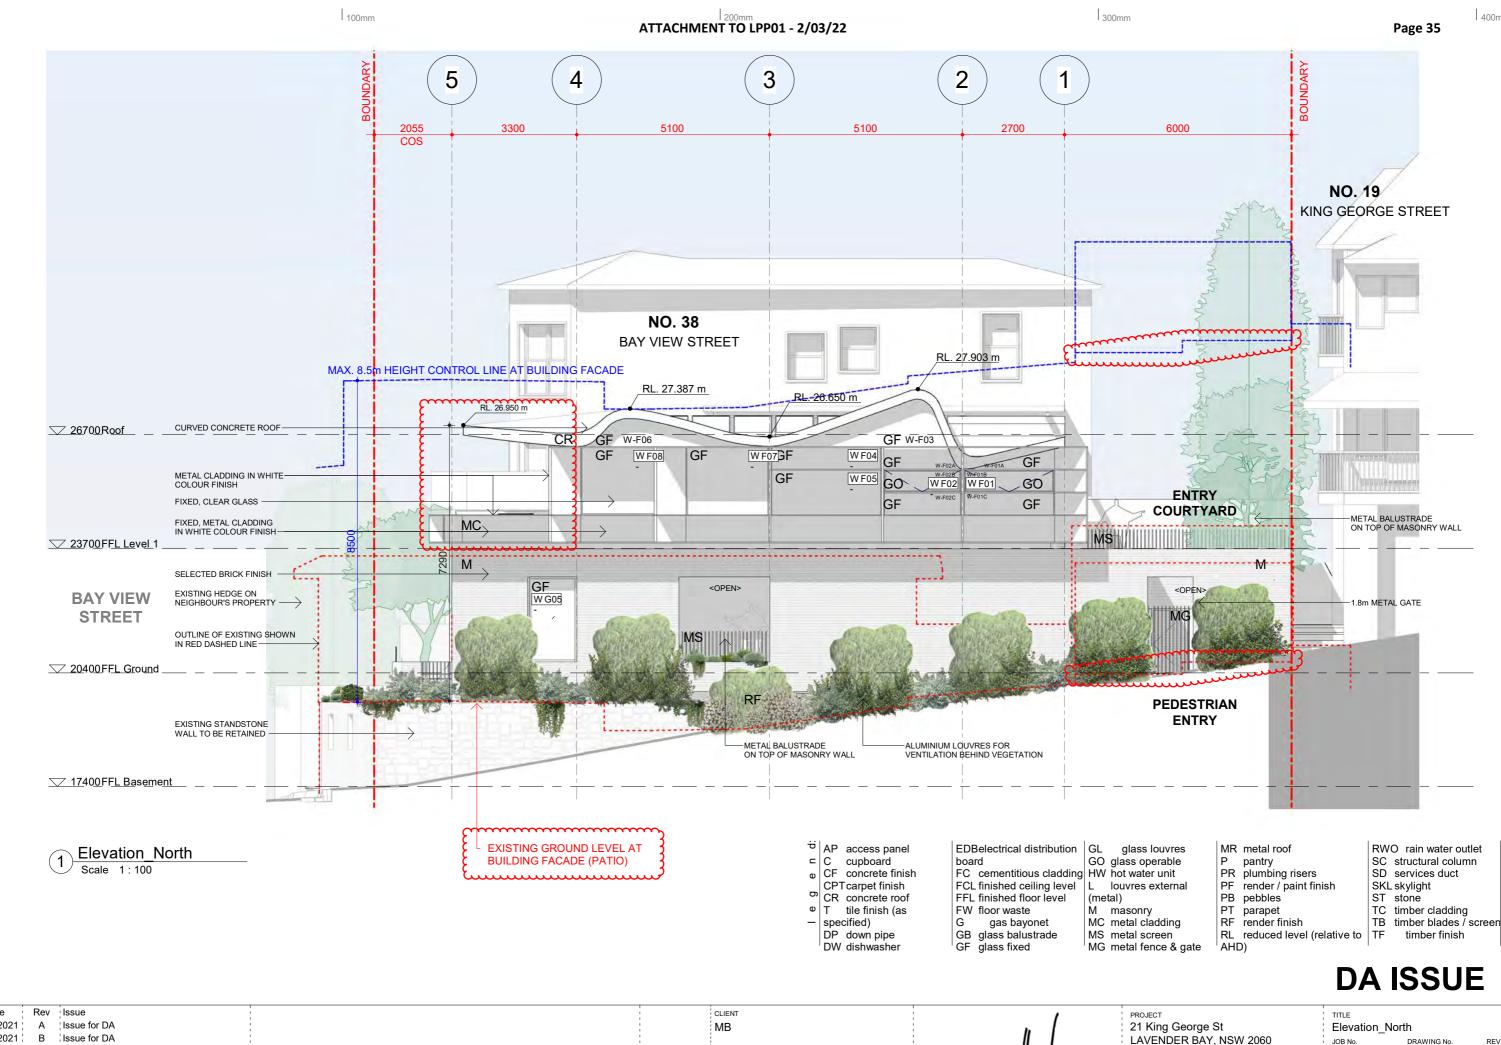

	Date 09.06.2021 14.09.2021 13.12.2021		Issue Issue for DA Issue for DA Issue for DA			client MB		PROJECT 21 King Ge LAVENDEF LOT 7 DP 5	R BAY, NS
c	computer system of	the Archit	itect to systems of the Client or other Consultants. The recipient	f any errors existing or resulting from data howsoever transferred from the of the data shall be responsible for checking accuracy and completeness e CAD files and their contents are solely representations of the project	NSW Nominated Architects: S. ISAACS #7929 ABN: 79 124 014 759	ARCHITECTURE SAVILLE ISAACS PTY LTD 23a KING GEORGE STREET, MeMAHONS POINT, NSW 2060		PROJECT DATE JAN 08	ISSUED D/ 13.12.20

200n

0mm

DA-201

С

2024


STATUS DA ISSUE

SCALE @ A3: 1:100

ISSUED DATE 13.12.2021

100m

200m

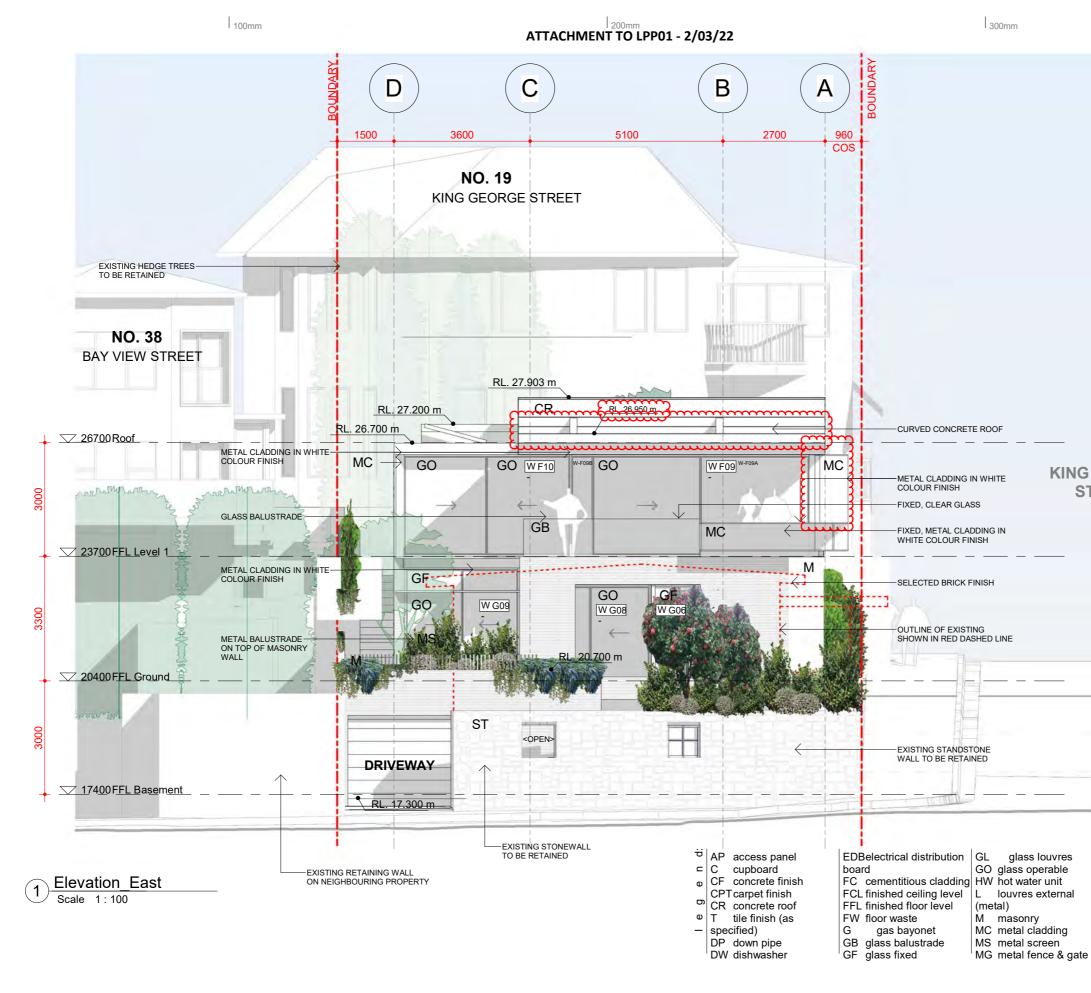

Date	Rev	v Issue				CLIENT		1	PROJE
09.06.202	1¦ A	Issue for DA				MB		1	21 Ki
14.09.202		Issue for DA	1		1		: //	1	LAVE
13.12.202	1 C	Issue for DA						1	LOT
computer syster	m of the Ar	chitect to systems of the Client or other Consultants. The recipient	f any errors existing or resulting from data howsoever transferred from the of the data shall be responsible for checking accuracy and completeness e CAD files and their contents are solely representations of the project	NSW Nominated Architects: S. ISAACS #7929 ABN: 79 124 014 759	1				PROJEC

Page 36

400mm

	EORGE
	REET
es louvres operable ater unit es external nry	MR metal roof P pantry PR plumbing risers PF render / paint finish PB pebbles PT parapet


D	SC SD SKL ST TC	O rain water outlet structural column services duct skylight stone timber cladding timber blades / screen timber finish	

# **DA ISSUE**

King George St         Elevation_East           /ENDER BAY, NSW 2060         JOB NO.         DRAWING NO.         REV.					
T 7 DP 520996         2024         DA-202         C           ect date         issued date         scale @ A3:         status	<sup>⊫ECT</sup> King George St /ENDER BAY, NSW 2060 Г 7 DP 520996		1		
					REV.

RL reduced level (relative to

AHD)

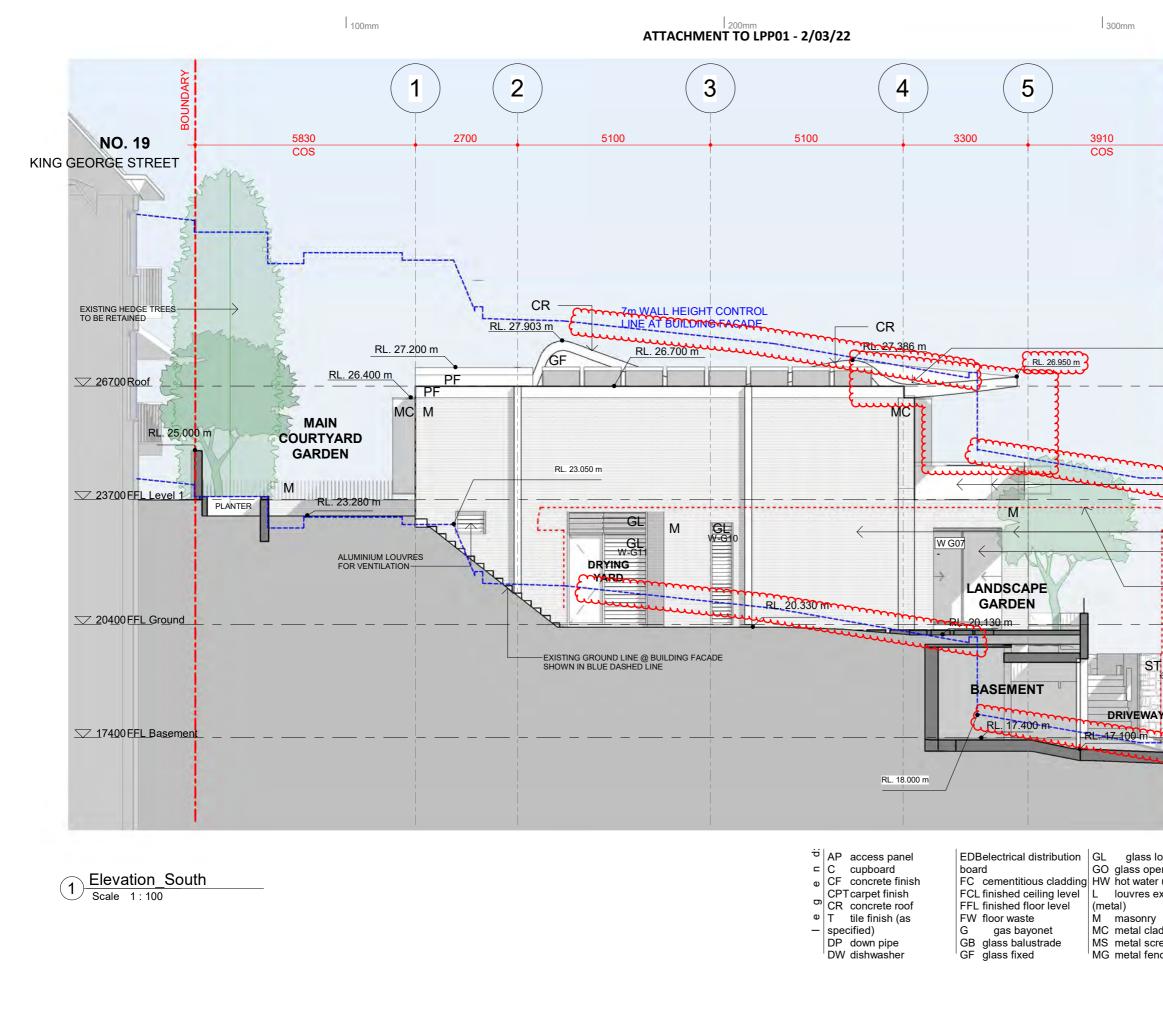


Γ	Date	Rev	Issue				CLIENT	1	,	PROJECT
	09.06.2021	А	Issue for DA			1	MB		1	21 King Geor
	14.09.2021	В	Issue for DA			1		: //	1	LAVENDER B
	13.12.2021	С	Issue for DA			1				LOT 7 DP 520
	computer system of	the Archi	e for any loss or claims whatsoever arising from or in respect of any errors existing or r ect to systems of the Client or other Consultants. The recipient of the data shall be res e electronic data in part or whole shall be at the user's risk. The CAD files and their co	ponsible for checking accuracy and completeness	NSW Nominated Architects: S. ISAACS #7929 ABN: 79 124 014 759	P: 02 - 9086 9000 F: 02 - 9086 9001	ARCHITECTURE SAVILLE ISAACS PTY LTD 23a KING GEORGE STREET, MCMAHONS POINT, NSW 2060		sa a	PROJECT DATE I JAN 08 1

200m

BOUNDARY	
CURVED CONCRETE ROOF (ROOF BEYOND)	
FRAMELESS GLASS BALUSTRADE	BAY VIEW STREET
EXISTING STANDSTONE WALL TO BE RETAINED	
louvres MR metal roof Perable P pantry Pr unit PR plumbing risers external PF render / paint fini PB pebbles / PT parapet adding RF render finish reen RL reduced level (re nce & gate AHD)	ST stone TC timber cladding TB timber blades / screen
ECT King George St /ENDER BAY, NSW 2060 7 DP 520996	TITLE Elevation_South JOB No. DRAWING No. REV. 2024 DA-203 C

SCALE @ A3: STATUS 1 : 100 DA ISSUE

ISSUED DATE 13.12.2021

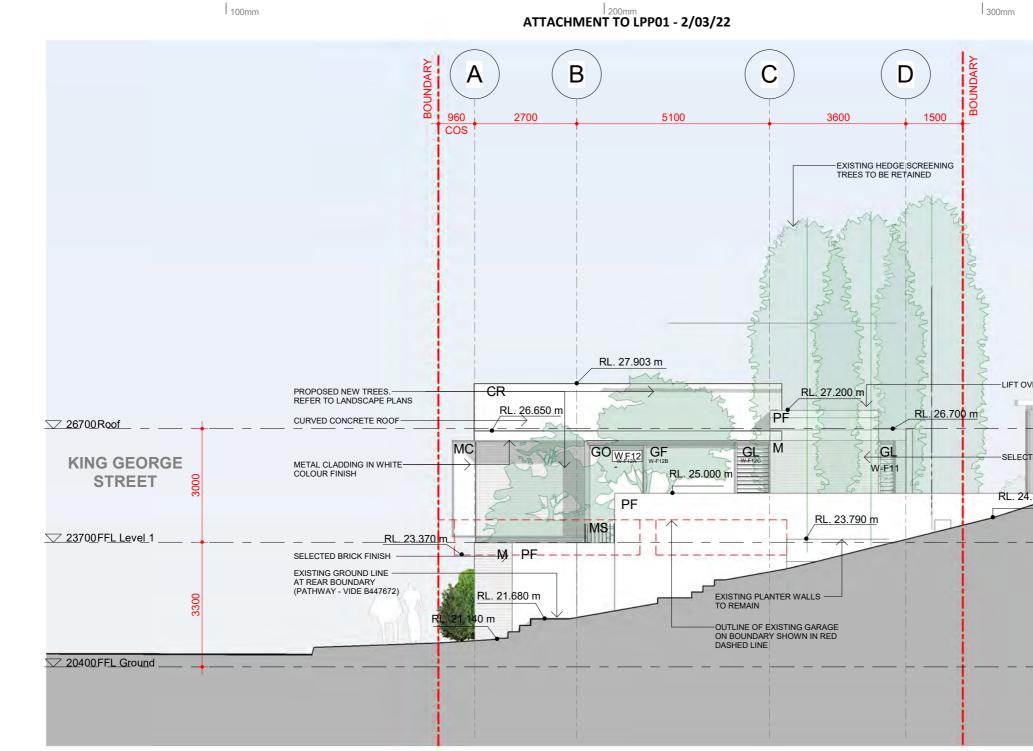


1 Elevation\_West Scale 1 : 100

	" [	PROJECT 21 King George	St Eleva	tion_West
			D	A ISSUE
<ul> <li>AP access panel</li> <li>C cupboard</li> <li>CF concrete finish</li> <li>CPT carpet finish</li> <li>CR concrete roof</li> <li>T tile finish (as</li> <li>specified)</li> <li>DP down pipe</li> <li>DW dishwasher</li> </ul>	EDBelectrical distribution board FC cementitious cladding FCL finished ceiling level FFL finished floor level FW floor waste G gas bayonet GB glass balustrade GF glass fixed	GL glass louvres GO glass operable HW hot water unit L louvres external (metal) M masonry MC metal cladding MS metal screen MG metal fence & gate	MR metal roof P pantry PR plumbing risers PF render / paint finish PB pebbles PT parapet RF render finish RL reduced level (relative to AHD)	RWO rain water outlet SC structural column SD services duct SKL skylight ST stone TC timber cladding TB timber blades / screen TF timber finish

	2021	А	Issue Issue for DA			client MB	1 1 1 1	" (	,	PROJECT 21 King George St		TITLE Elevation_W	/est	
14.09.	.2021	В	Issue for DA					.   <sub>s</sub>		LAVENDER BAY, NSW 2060 LOT 7 DP 520996		JOB №. 2024	drawing No. <b>DA-204</b>	rev. B
computer	system of	the Archit	ect to systems of the Client or other Consultants. The recipie	t of any errors existing or resulting from data howsoever transferred from the ent of the data shall be responsible for checking accuracy and completeness The CAD files and their contents are solely representations of the project	NSW Nominated Architects: S. ISAACS #7929 ABN: 79 124 014 759	ARCHITECTURE SAVILLE ISAACS PTY LTD 23a KING GEORGE STREET, McMAHONS POINT, NSW 2060		1 1	~~~	PROJECT DATE ISSUED DATE S JAN 08 14.09.2021	SCALE @ A3: 1 : 100	STATUS DA ISSUE		

Page 38

_	
	NO. 38 BAY VIEW STREET
ERRUN	
ED BRICK FI	NISH RL. 25.100 m
360 m	

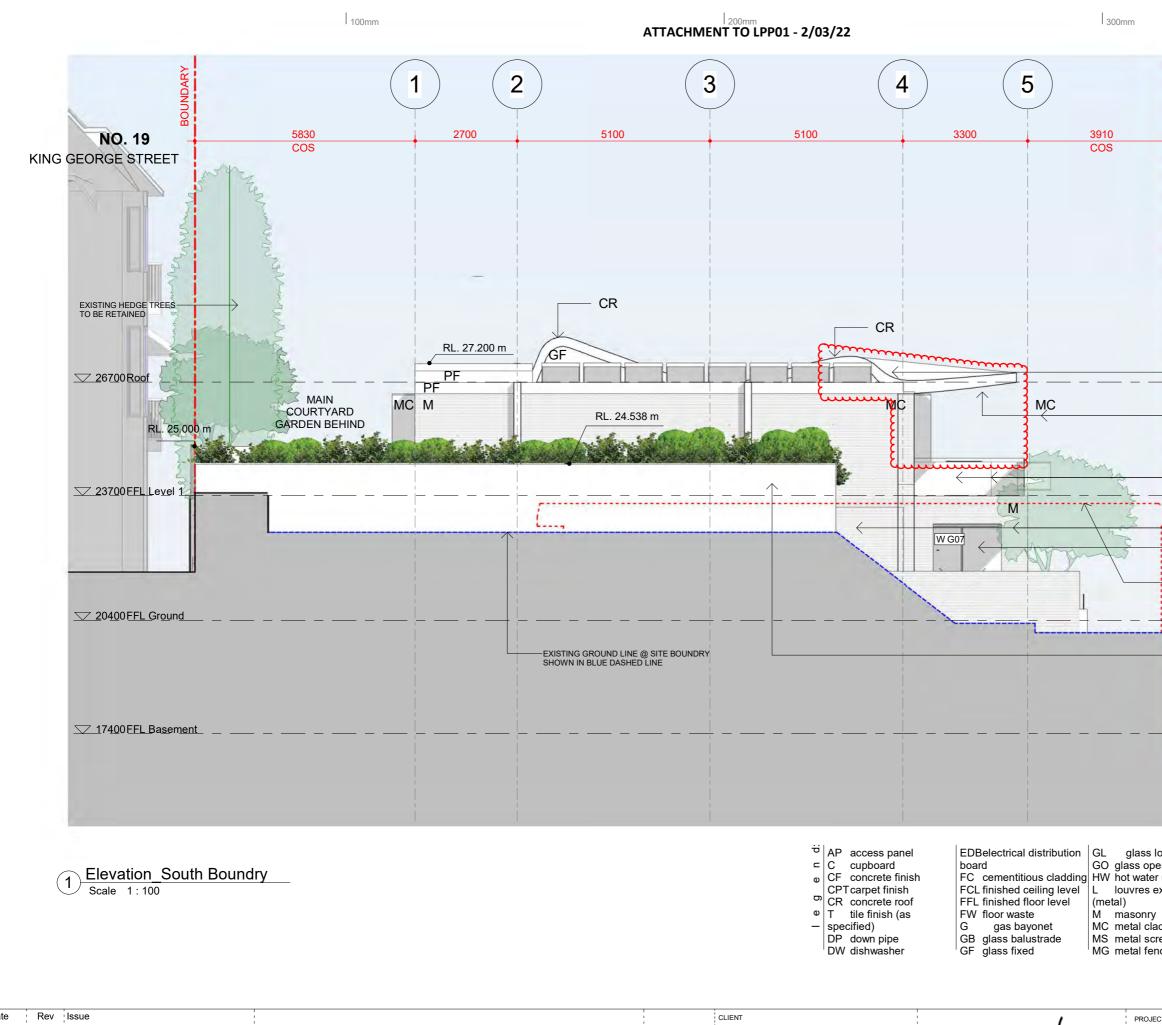

Date 14.09.2021 A Issue for DA MB 21 Ki LAVENDER BAY, NSW 2060 LOT 7 DP 520996 RCHITECTURE ~v; The Architect shall not be liable for any loss or claims whatsoever arising from or in respect of any errors existing or resulting from data howsoever transferred from the computer system of the Architect to systems of the Client or other Consultants. The recipient of the data shall be responsible for checking accuracy and completeness of data received. Any use of the electronic data in part or whole shall be at the user's risk. The CAD files and their contents are solely representations of the project NSW Nominated Architects: S. ISAACS #7929 P: 02 - 9086 9000 ABN: 79 124 014 759 F: 02 - 9086 9001 PROJECT DATE ARCHITECTURE SAVILLE ISAACS PTY LTD 23a KING GEORGE STREET, MCMAHONS POINT, NSW 2060 **JAN 08** 

200m

0mm

	X		
	BOUNDARY		
	28 -		
-	CURVED CONCRETE ROOF — (ROOF-BEYOND) — — —		
-	METAL CLADDING IN WHITE COLOUR FINISH		
	FRAMELESS GLASS BALUSTRADE		
-			
	SELECTED BRICK FINISH 		VIEW
$\leftarrow$	OUTLINE OF EXISTING BUILDING AT BOUNDARY	ST	REET
	SHOWN IN RED DASHED LINE		
	NEW 1.8m TALL FENCE ON		
	BOUNDRY		
_			
ouvi erab r uni	le P pantry	s	RWO rain water outlet SC structural column SD services duct
exter	rnal PF render / paint f PB pebbles	inish	SKL skylight ST stone
addir reen	· I · · · · · ·	relative to	TC timber cladding TB timber blades / screen TF timber finish
	& gate AHD)		
		D	<b>A ISSUE</b>
ст ing	George St	Elevati	on South Boundry

JOB No.

2024

SCALE @ A3: STATUS 1 : 100 DA ISSUE


ISSUED DATE 14.09.2021

DRAWING No.

DA-205


REV.

Α

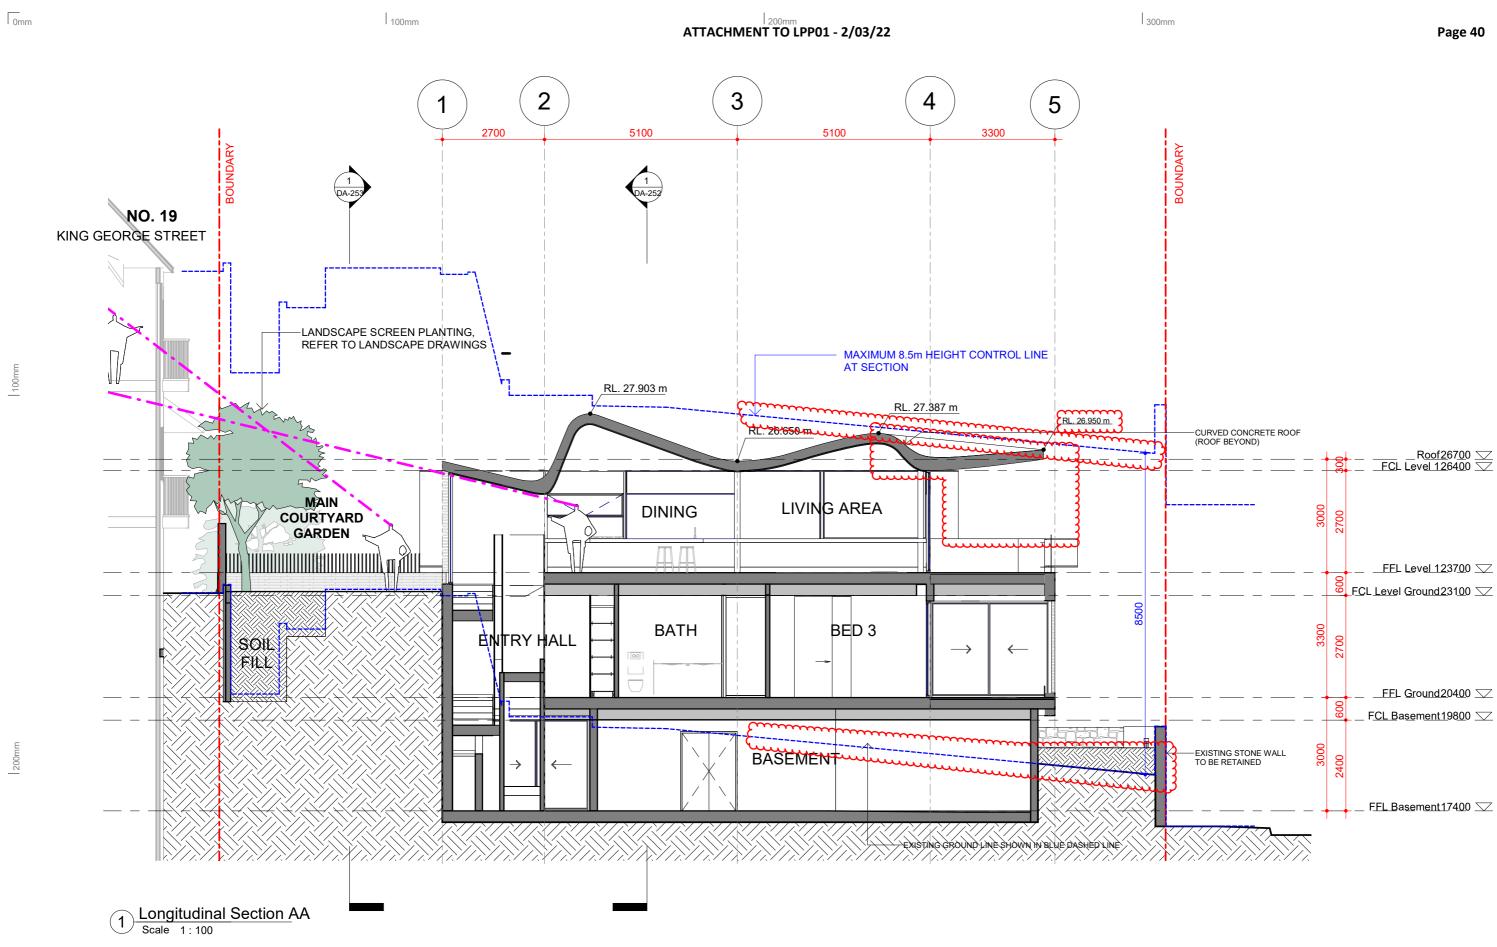

100n

Date	Re	v Issue			CLIENT	,	PROJECT	TITLE		
14.09.2021	С	Issue for DA			MB	1	21 King George St	Sections		
13.12.2021	D	Issue for DA		1			LAVENDER BAY, NSW 2060	JOB No.	DRAWING No.	REV.
16.02.2022	E	Issue for DA				 1.	LOT 7 DP 520996	2024	DA-251	E
computer system	of the Ar	rchitect to systems of the Client or other Consultants. The recipie	of any errors existing or resulting from data howsoever transferred from the nt of the data shall be responsible for checking accuracy and completeness he CAD files and their contents are solely representations of the project			sa a	PROJECT DATE ISSUED DATE SCALE @ A3: JAN 08 16.02.2022 1 : 100	STATUS DA ISSUE		

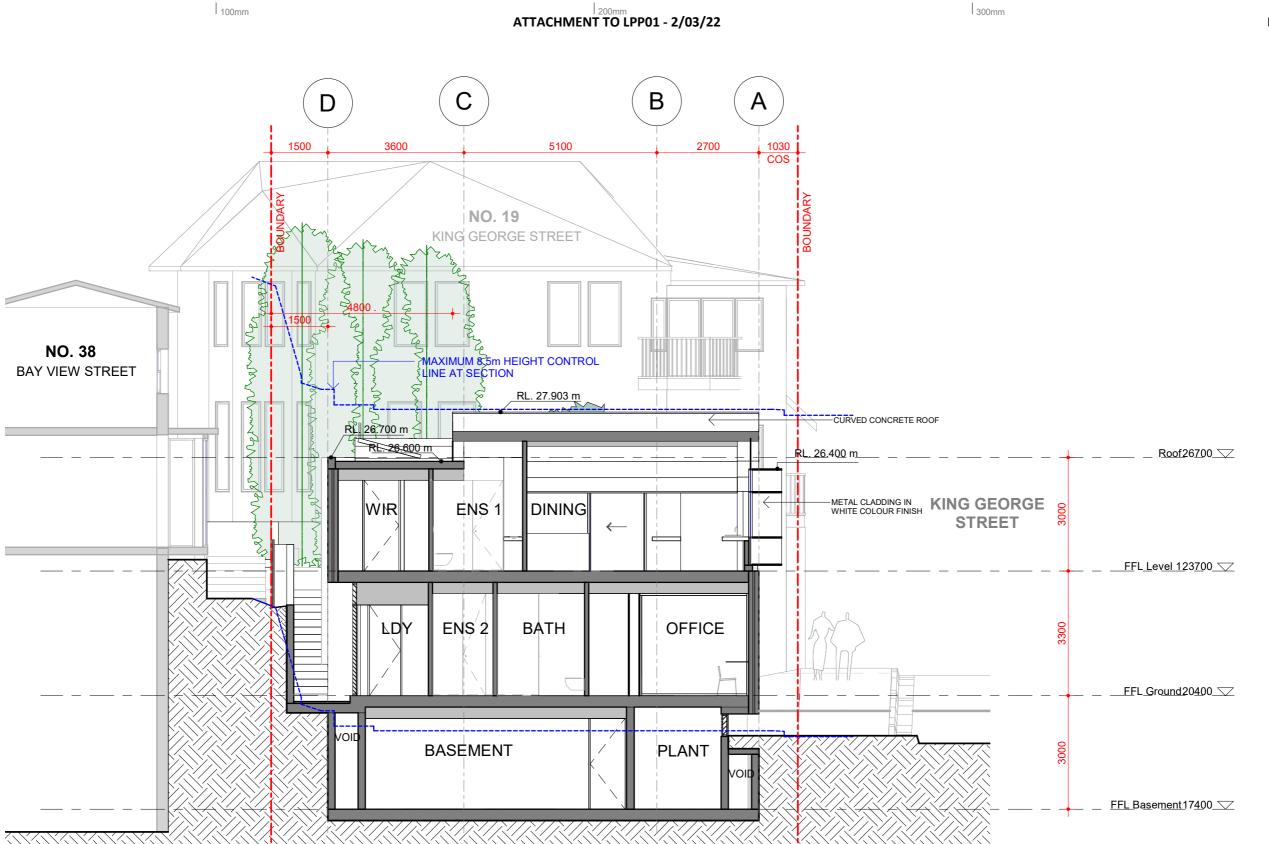


1 Cross Section BB Scale 1:100

Date Rev Issue			CLIENT		,	PROJECT			TITLE		
09.06.2021 A Issue for DA	1 1		MB		1	21 King Geo	orge St		Sections		
14.09.2021 B Issue for DA	1				1	LAVENDER	BAY, NSW 20	060	JOB No.	DRAWING No.	REV.
				 I. I		LOT 7 DP 5	20996		2024	DA-252	В
The Architect shall not be liable for any loss or claims whatsoever arising from or in respect of computer system of the Architect to systems of the Client or other Consultants. The recipient of data received. Any use of the electronic data in part or whole shall be at the user's risk. The	of the data shall be responsible for checking accuracy and completeness	NSW Nominated Architects: S. ISAACS #7929 ABN: 79 124 014 759		le	»aa —	PROJECT DATE	ISSUED DATE 14.09.2021	SCALE @ A3: 1 : 100	STATUS DA ISSUE		

200mm

100m

200

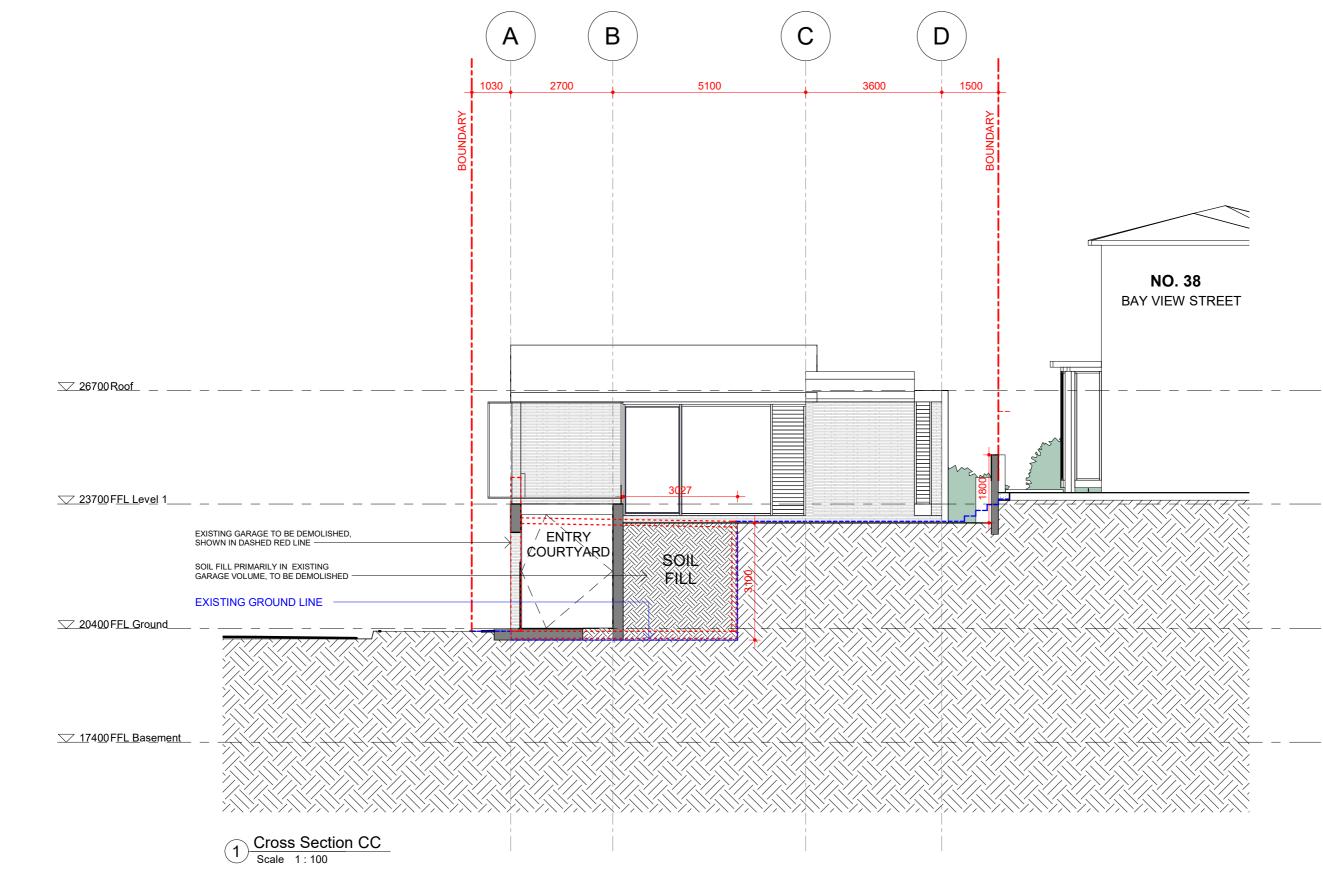




Page 42




JECT King George St	TITLE Sections		
VENDER BAY, NSW 2060 T 7 DP 520996	JOB №. 2024	DRAWING No. DA-253	rev. A
JECT DATE ISSUED DATE SCALE @ A3: 08 14.09.2021 1 : 100	STATUS DA ISSUE		

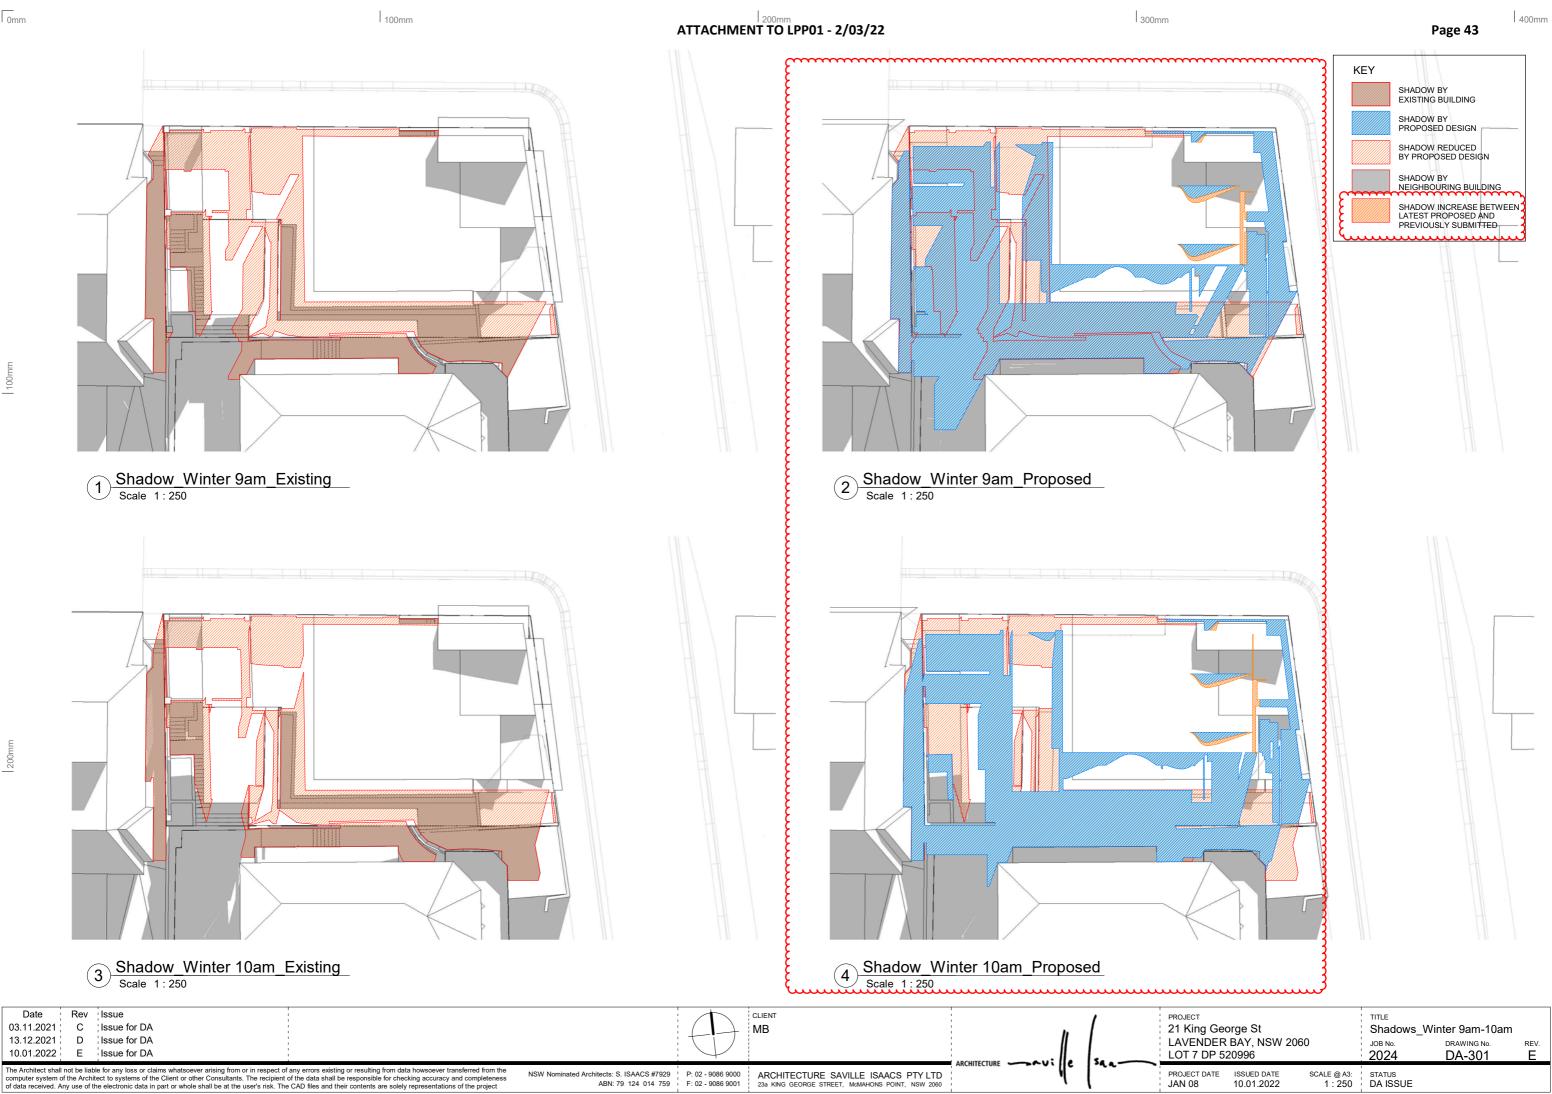

200m

		_
<sup>ECT</sup> King George St /ENDER BAY, NSW 2060 Г 7 DP 520996	TITLE           Shadows_Winter 9am-10am           JOB No.         DRAWING No.           2024         DA-301	
ECT DATE         ISSUED DATE         SCALE @ A3:           08         10.01.2022         1 : 250	STATUS DA ISSUE	

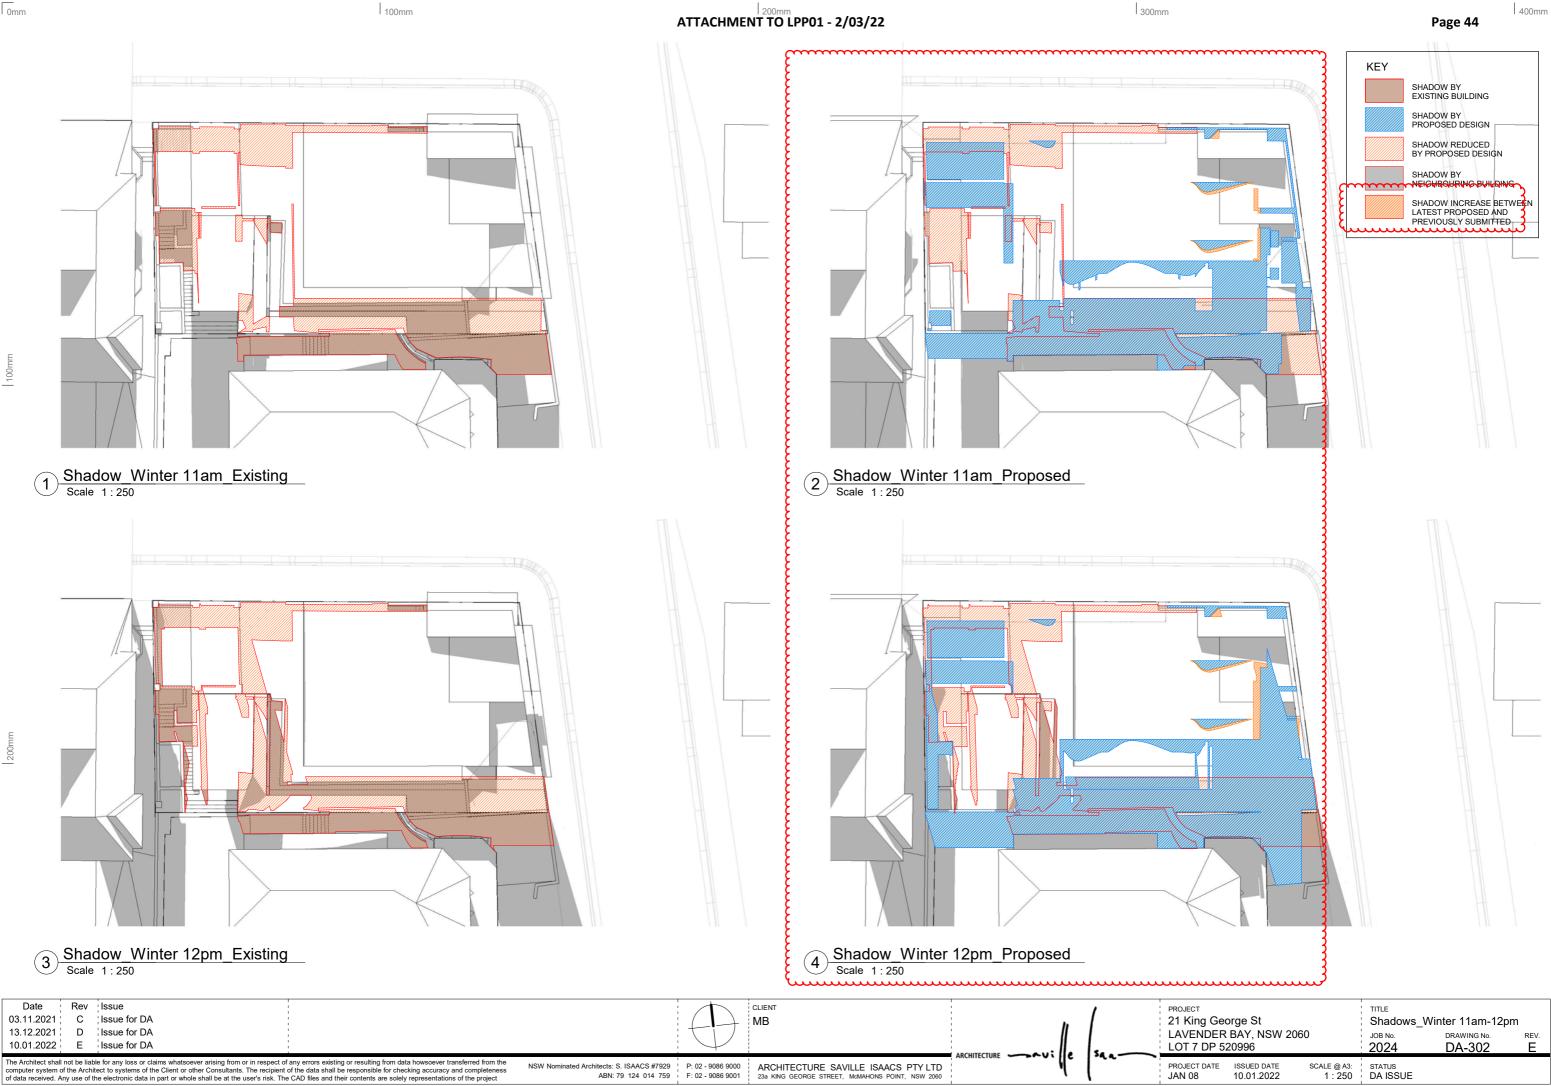


ARCHITECTURE SAVILLE ISAACS PTY LTD 23a KING GEORGE STREET, MCMAHONS POINT, NSW 2060

NSW Nominated Architects: S. ISAACS #7929 P: 02 - 9086 9000 ABN: 79 124 014 759 F: 02 - 9086 9001


100m

200m

	ागाट Shadows_Winter 11am-12pm
LAVENDER BAY, NSW 2060 LOT 7 DP 520996	JOB No. DRAWING No. REV. 2024 DA-302 E
PROJECT DATE         ISSUED DATE         SCALE @ A3:           JAN 08         10.01.2022         1 : 250	STATUS DA ISSUE

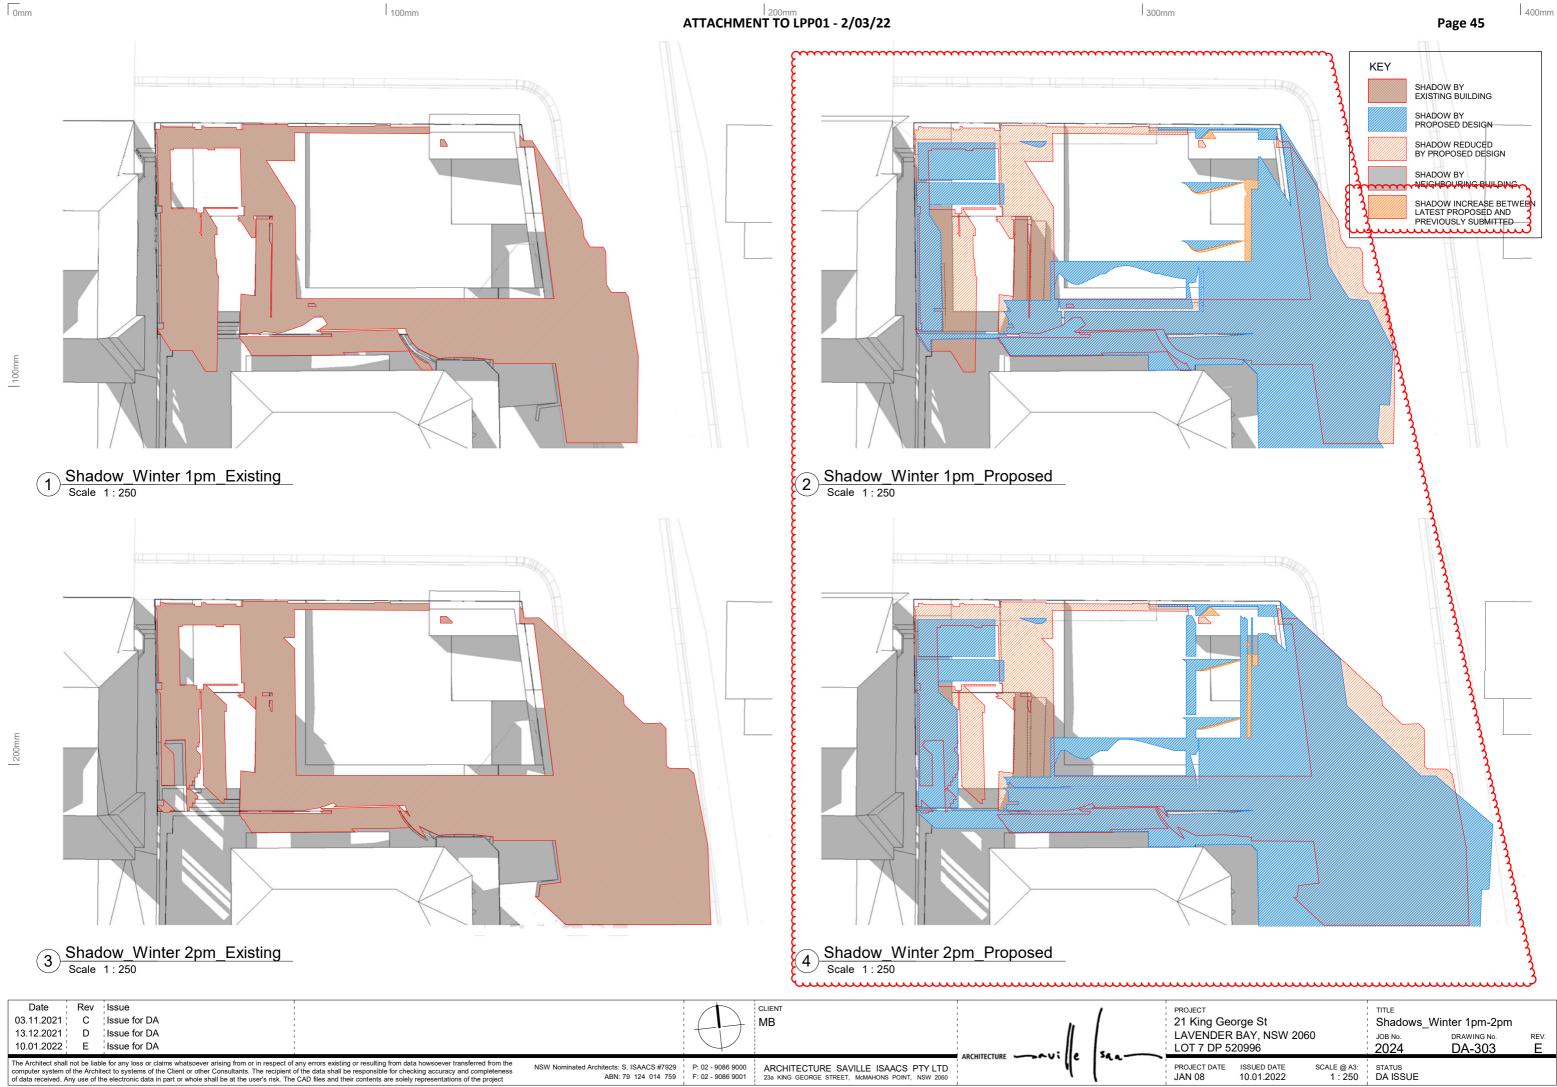

JECT King Geo √ENDER T 7 DP 52	BAY, NSW 2		TITLE Shadows_ JOB №. 2024	Winter 1pm-2pm DRAWING No. DA-303	rev. E
JECT DATE	ISSUED DATE 10.01.2022	SCALE @ A3: 1 : 250	STATUS DA ISSUE		

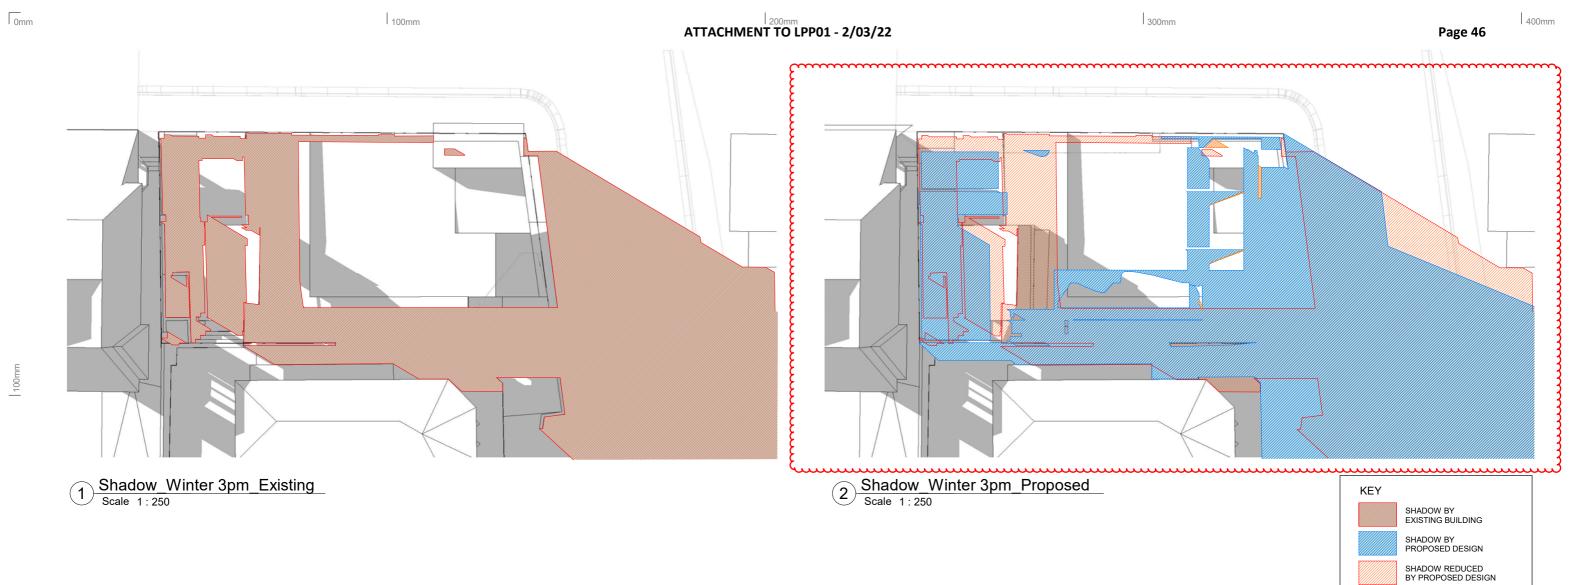


						1			
Date	Rev	Issue			$\wedge$	CLIENT		1	PROJE
03.11.2021	С	Issue for DA			$( \rightarrow )$	MB		1	21 K
13.12.2021	D	Issue for DA	1		$\left( \left( \right) \right)$	1	: //	1	LAV
10.01.2022	E	Issue for DA			$\checkmark$				LOT
								1344	
			of any errors existing or resulting from data howsoever transferred from the	NSW Nominated Architects: S. ISAACS #7929 P:	2: 02 - 9086 9000	ARCHITECTURE SAVILLE ISAACS PTY LTD	. N.		PROJE
			t of the data shall be responsible for checking accuracy and completeness he CAD files and their contents are solely representations of the project	ABN: 79 124 014 759 F	: 02 - 9086 9001	23a KING GEORGE STREET, McMAHONS POINT, NSW 2060	1		JAN (
of data received. A	Any use of	the electronic data in part of whole shall be at the user's risk. If	the CAD lifes and their contents are solery representations of the project				1	•	

PROJECT	TITLE				
21 King George St	Shadows_Winter 3pm				
LAVENDER BAY, NSW 2060	JOB No. DRAWING No. REV.				
LOT 7 DP 520996	2024 DA-304 E				
PROJECT DATE         ISSUED DATE         SCALE @ A3:           JAN 08         10.01.2022         1 : 250	STATUS DA ISSUE				


SHADOW BY NEIGHBOURING BUILDING

SHADOW INCREASE BETWEEN LATEST PROPOSED AND PREVIOUSLY SUBMITTED

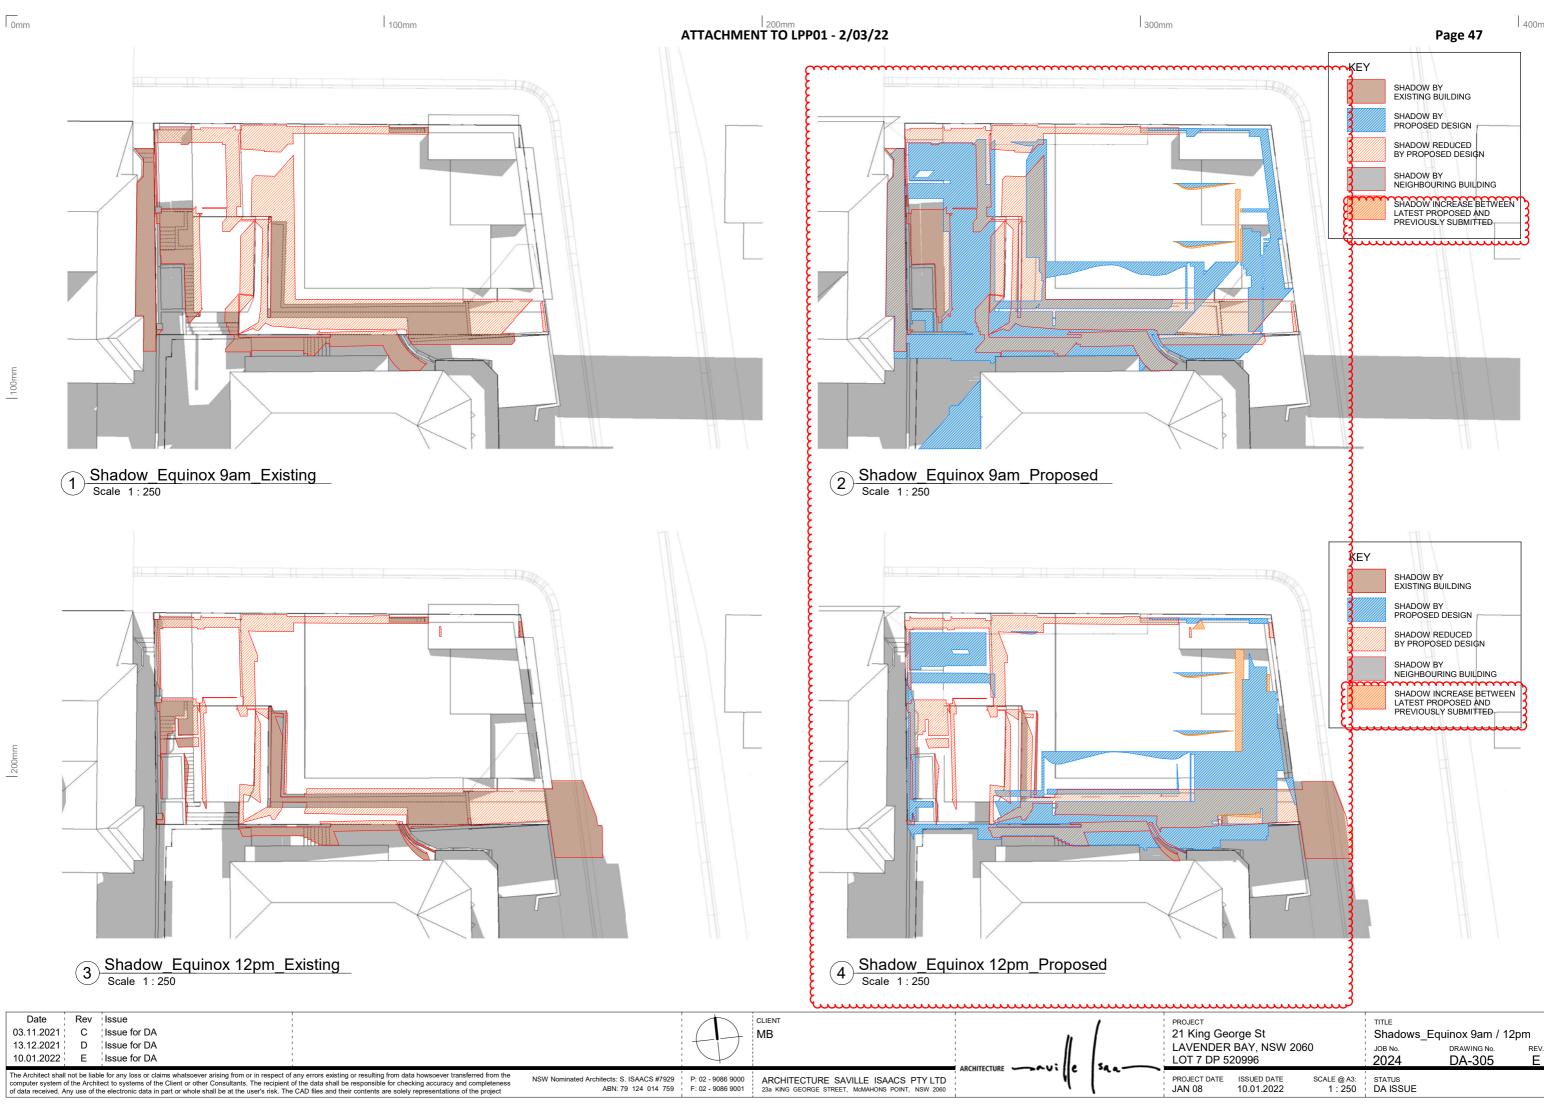

200mm


# ATTACHMENT TO LPP01 - 2/03/22

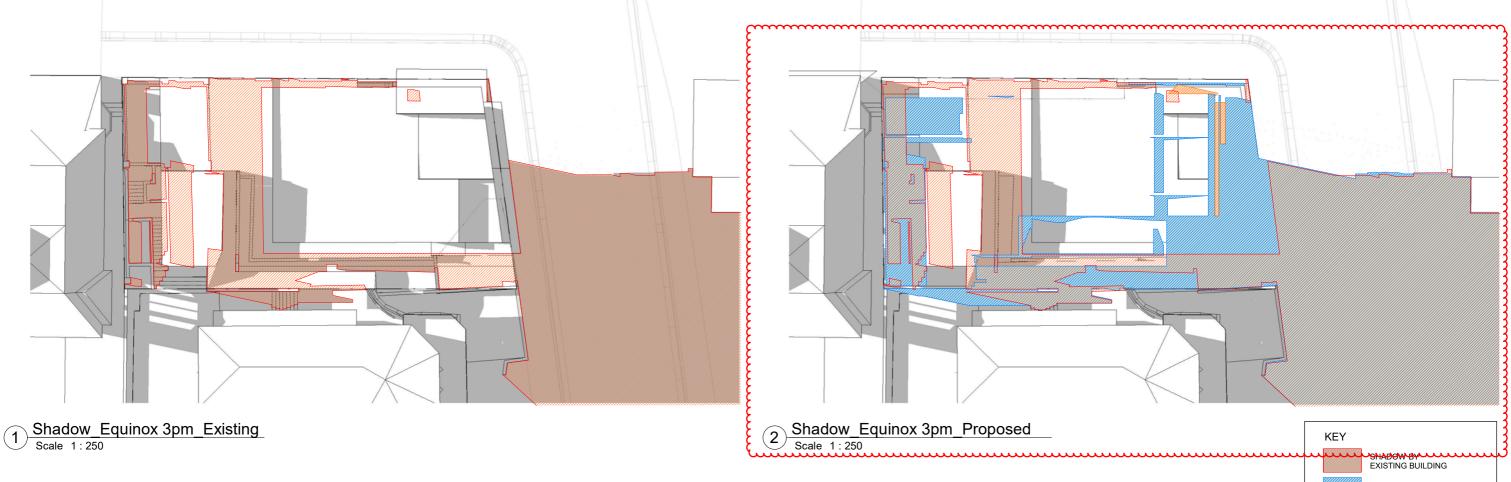

Date	Rev	Issue			$\wedge$	CLIENT	1	1	PRO.
03.11.2021	С	Issue for DA	1 1 1		( )	MB			21
13.12.2021	D	Issue for DA	1				. //		LA\
10.01.2022	E	Issue for DA			$\checkmark$				LO
computer system of	of the Arch	hitect to systems of the Client or other Consultants. The recipient	f any errors existing or resulting from data howsoever transferred from the of the data shall be responsible for checking accuracy and completeness e CAD files and their contents are solely representations of the project	NSW Nominated Architects: S. ISAACS #7929 ABN: 79 124 014 759		ARCHITECTURE SAVILLE ISAACS PTY LTD 23a KING GEORGE STREET, McMAHONS POINT, NSW 2060		*aa	PROJ JAN


u	SHADOW BY	•
	SHADOW BY PROPOSED DESIGN	
	SHADOW REDUCED BY PROPOSED DESIGN	
	SHADOW BY NEIGHBOURING BUILDING	
	SHADOW INCREASE BETWEEN LATEST PROPOSED AND PREVIOUSLY SUBMITTED	
1		1

<sub>јест</sub> King Geo	orge St		тт∟е Shadows_Equinox 3pm				
VENDER T 7 DP 52	BAY, NSW 20 20996	060	JOB №. 2024	DRAWING NO.	rev. E		
JECT DATE 1 08	ISSUED DATE 10.01.2022	SCALE @ A3: 1 : 250	STATUS DA ISSUE				

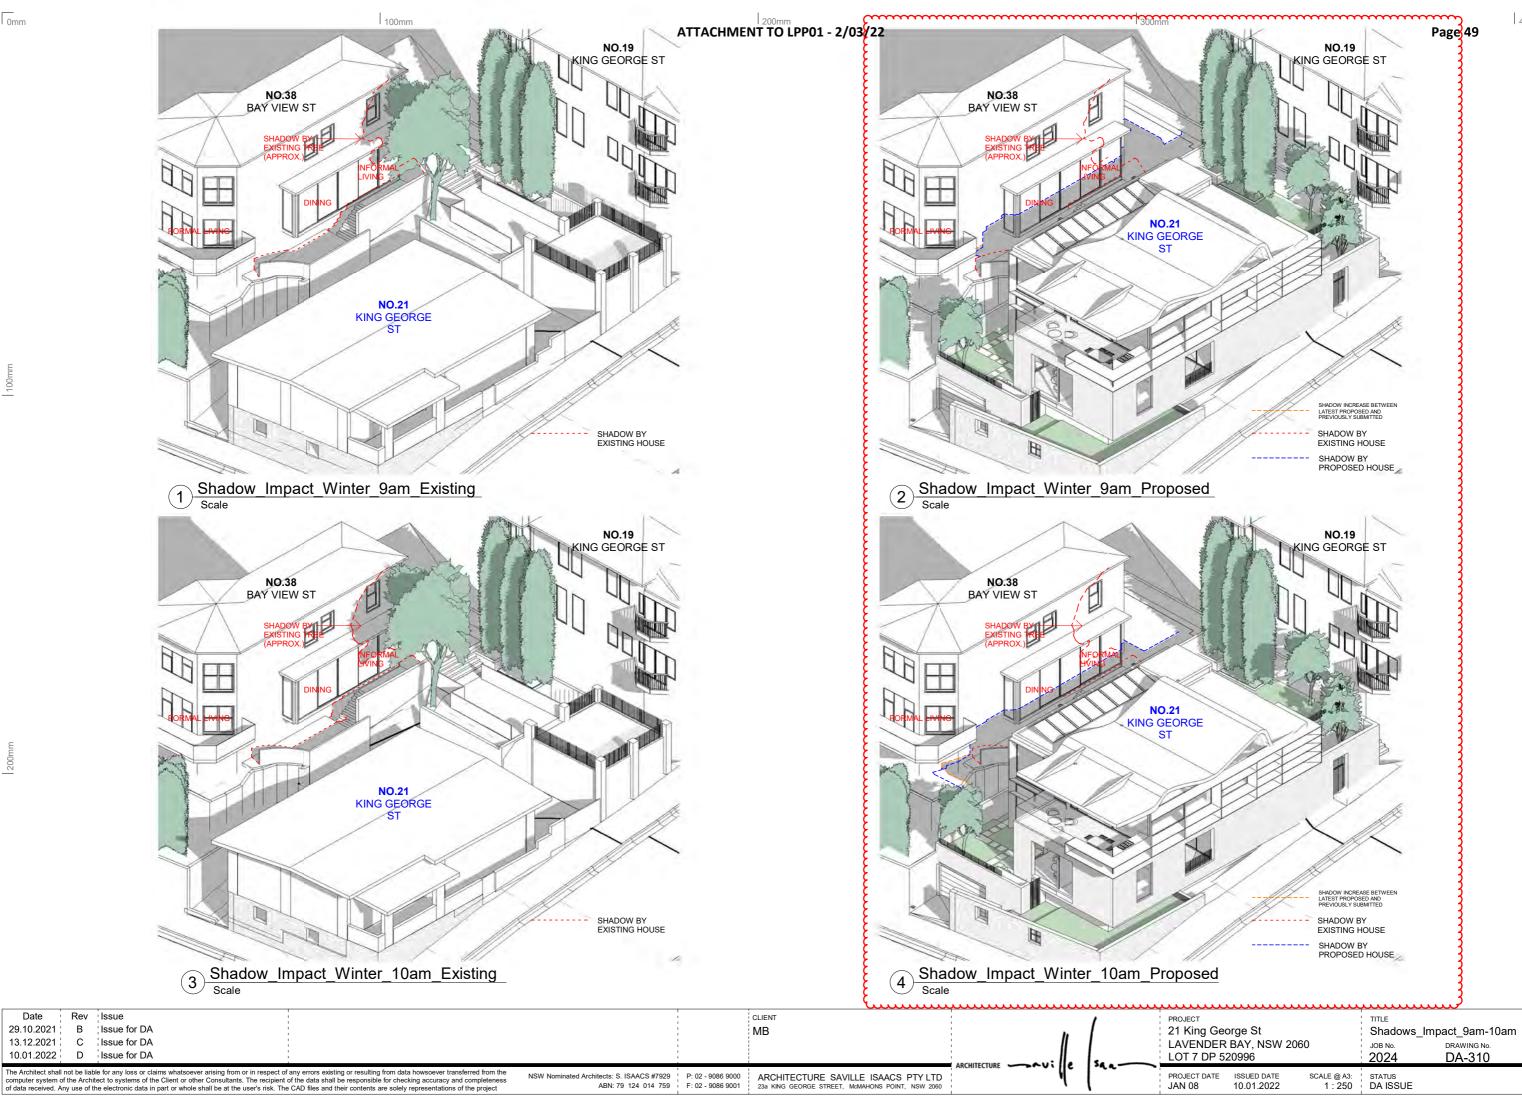


200

	······································				
<sup>JECT</sup>	TITLE				
King George St	Shadows_Impact_9am-10am				
VENDER BAY, NSW 2060	JOB №. DRAWING №. REV.				
T 7 DP 520996	2024 DA-310 D				
JECT DATE ISSUED DATE SCALE @ A3:	STATUS				
108 10.01.2022 1 : 250	DA ISSUE				

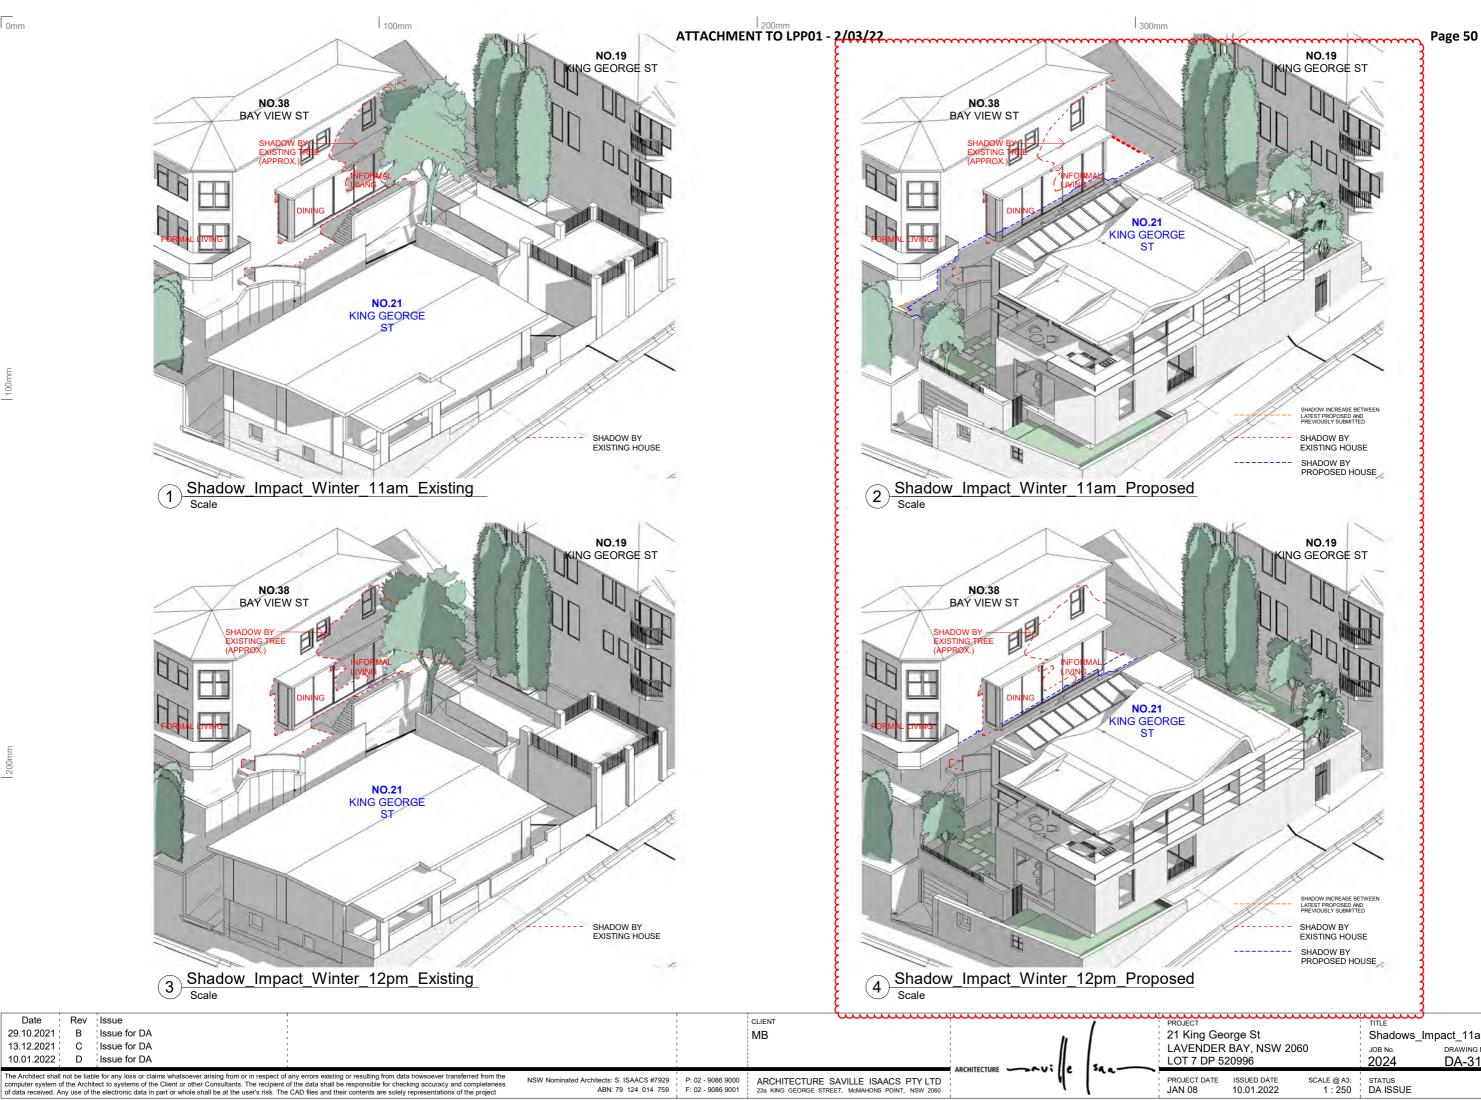

200n

JECT			TITLE	)			
King Geo	orge St		Shadows_Impact_11am-12pm				
VENDER T 7 DP 52	BAY, NSW 20 20996	060	JOB №. 2024	drawing №. DA-311	rev. D		
JECT DATE 1 08	ISSUED DATE 10.01.2022	SCALE @ A3: 1 : 250	STATUS DA ISSUE				

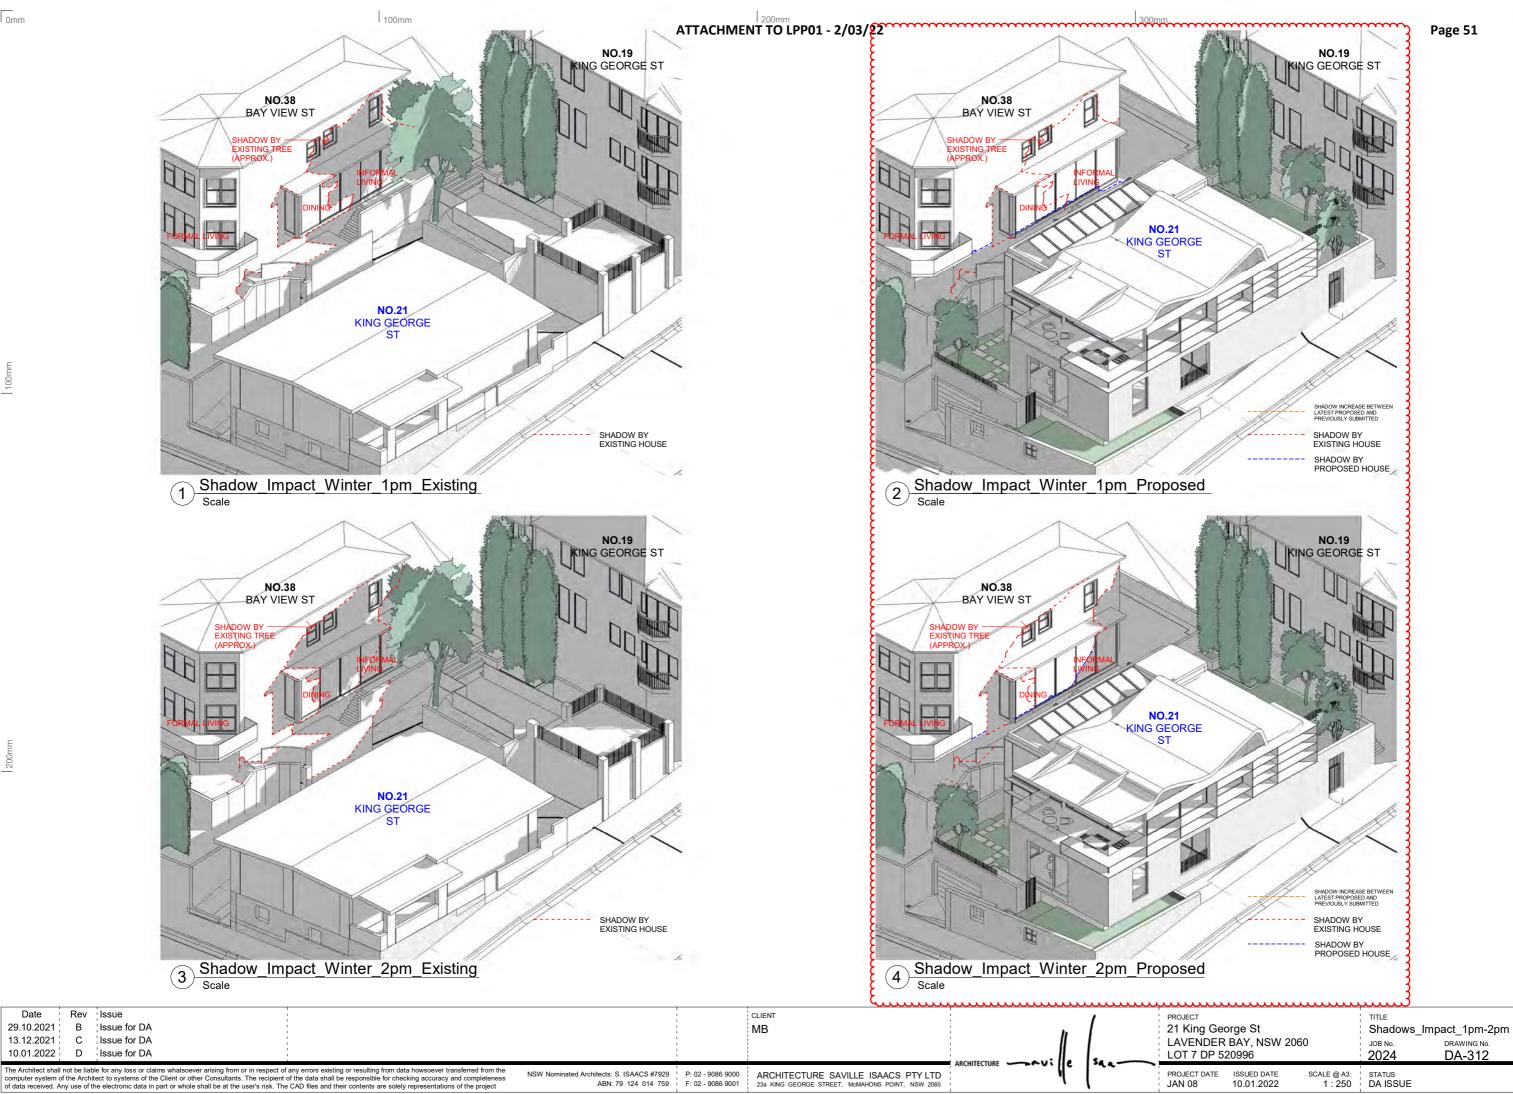

200r


Page 51

DRAWING No.

DA-312

REV.


D

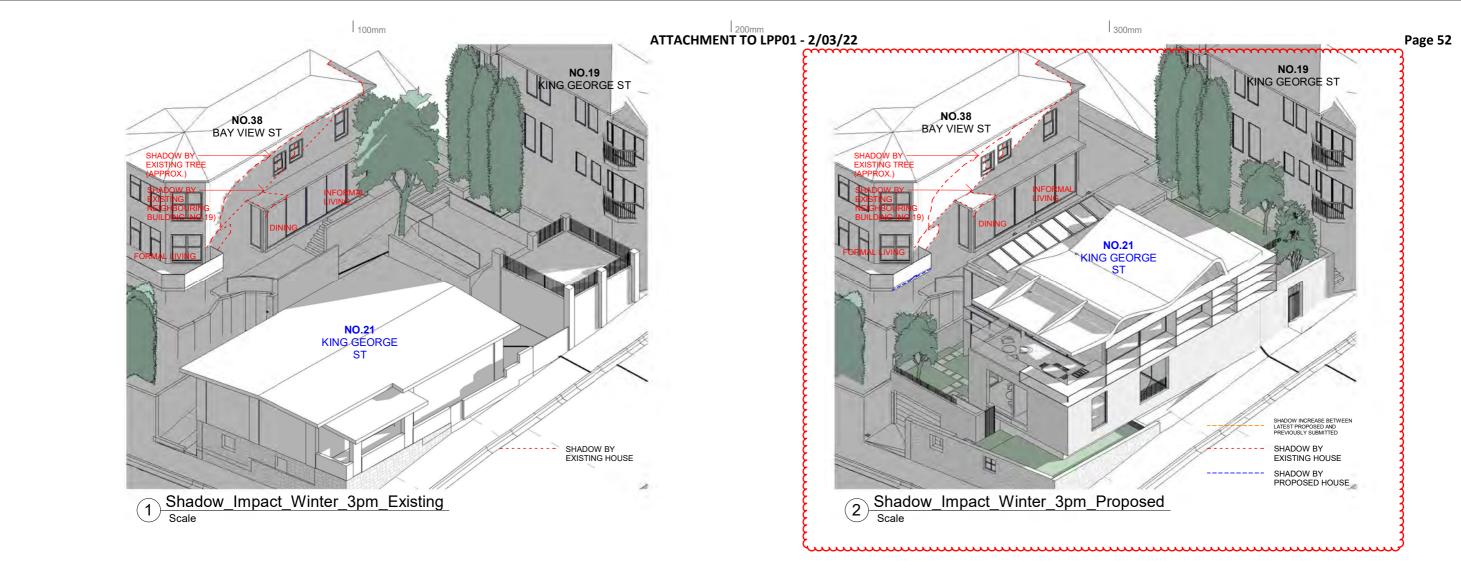

Date	Rev	Issue				CLIENT		,	PRC
09.06.2021	А	Issue for DA	1 1 1		1	MB		1	21
29.10.2021	В	Issue for DA	1		1		: //	1	LA
10.01.2022	С	Issue for DA			1				LC
computer system of	of the Arch	nitect to systems of the Client or other Consultants. The recipient	f any errors existing or resulting from data howsoever transferred from the of the data shall be responsible for checking accuracy and completeness a CAD files and their contents are solely representations of the project	NSW Nominated Architects: S. ISAACS #7929 ABN: 79 124 014 759		ARCHITECTURE SAVILLE ISAACS PTY LTD 23a KING GEORGE STREET, MeMAHONS POINT, NSW 2060			JAN

200mm

TITLE				
Shadows Impact 3pm				
JOB No. DRAWING No. REV. 2024 DA-313 C				
STATUS				
DA ISSUE				

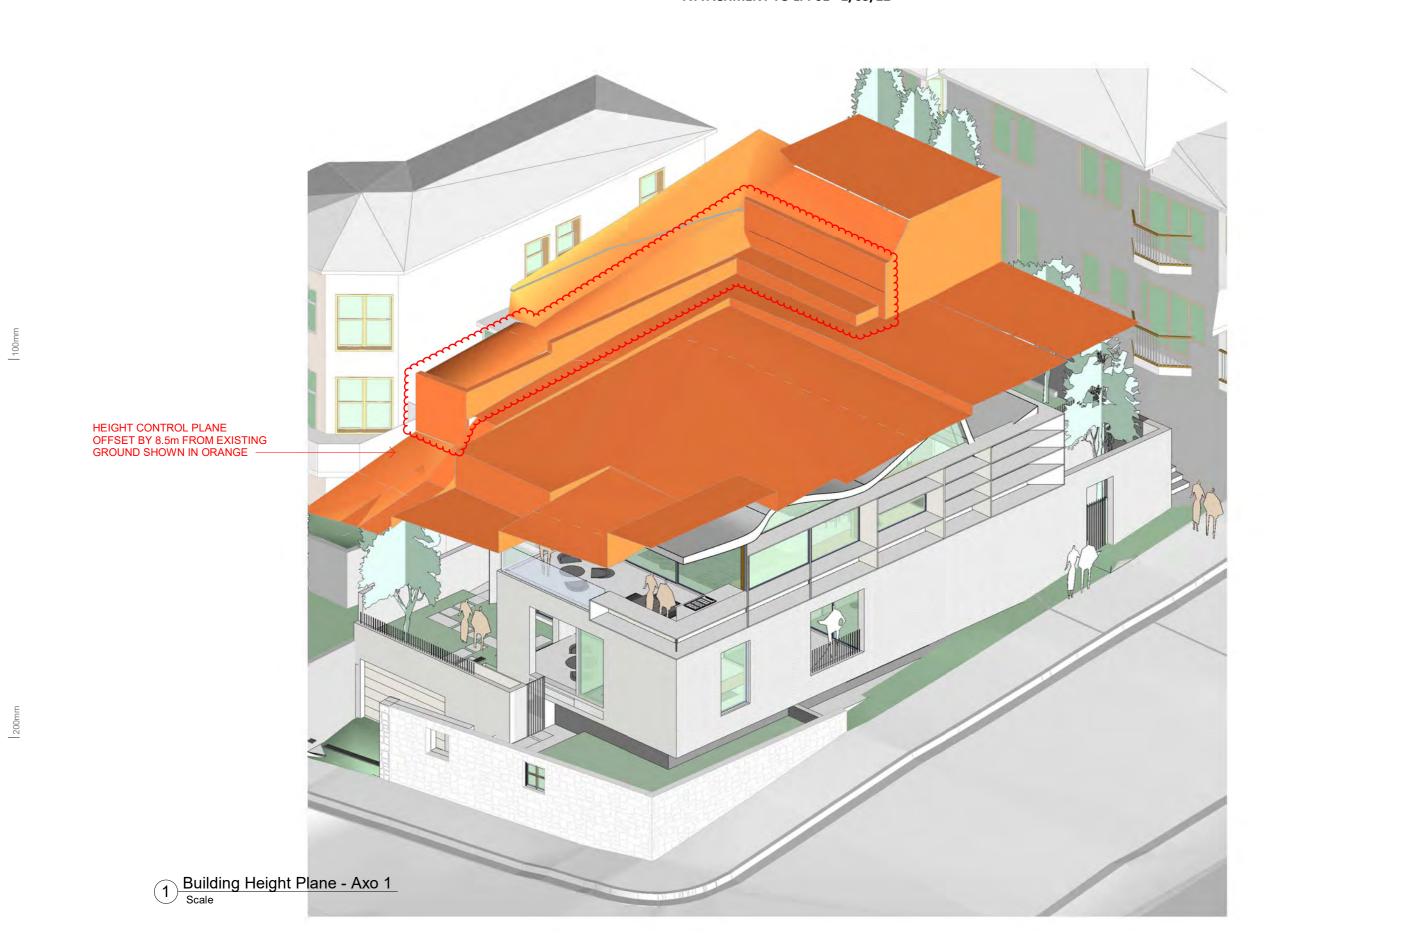




JECT King George St		ттье Max. 8.5m Height Plane Diagram 1				
VENDER BAY, NSW 2060 T 7 DP 520996		JOB №. 2024	DRAWING No.	<sup>REV.</sup>		
JECT DATE ISSUED DATE SO N 08 16.02.2022	CALE @ A3:	STATUS DA ISSUE				

Page 53

200mm

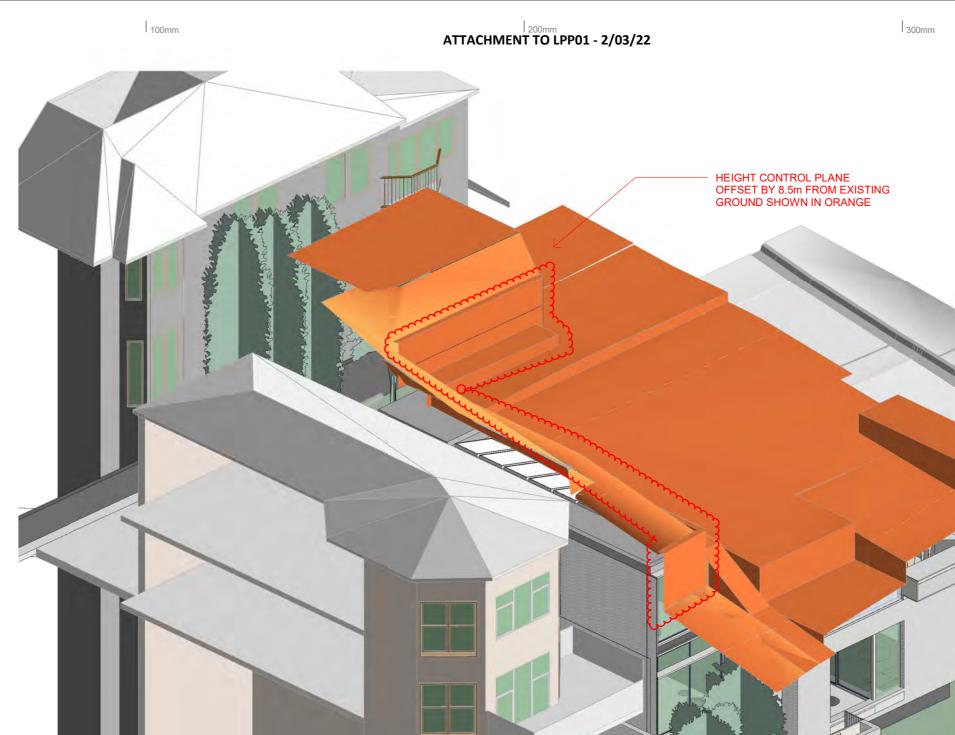



1 Building Height Plane - Axo 2 Scale

Date Rev Issue			CLIENT	1		/	PROJECT	TITLE		
09.06.2021 A Issue for DA			MB	I I		1	21 King George St	Max. 8.5m H	leight Plane Dia	agram 2
13.12.2021 B Issue for DA		1		1	11	1	LAVENDER BAY, NSW 2060	JOB No.	DRAWING No.	REV.
16.02.2022 C Issue for DA					.   .		LOT 7 DP 520996	2024	DA-353	С
The Architect shall not be liable for any loss or claims whatsoever arising from or in respect of any errors existing or resulting from data howsoever transferred from the computer system of the Architect to systems of the Client or other Consultants. The recipient of the data shall be responsible for checking accuracy and completeness of data received. Any use of the electronic data in part or whole shall be at the user's risk. The CAD files and their contents are solely representations of the project	NSW Nominated Architects: S. ISAACS #7929 ABN: 79 124 014 759				`lle		PROJECT DATE ISSUED DATE SCALE @ A3: JAN 08 16.02.2022	STATUS DA ISSUE		

Page 54



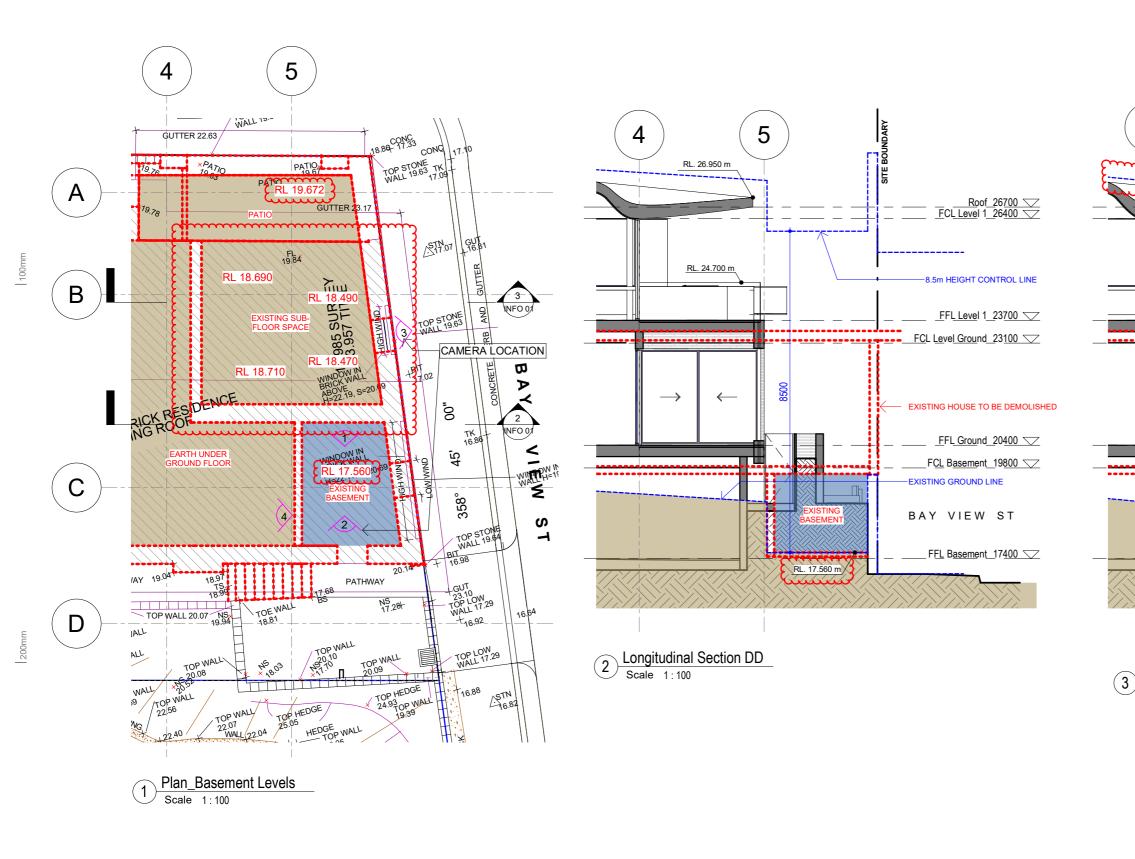


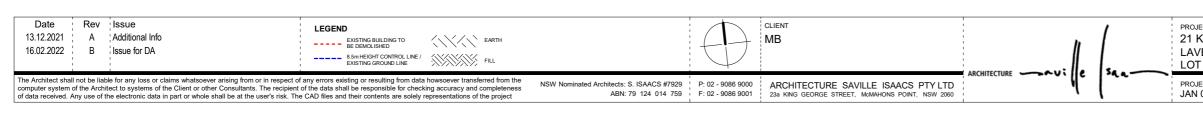

4

Page 55

400mm

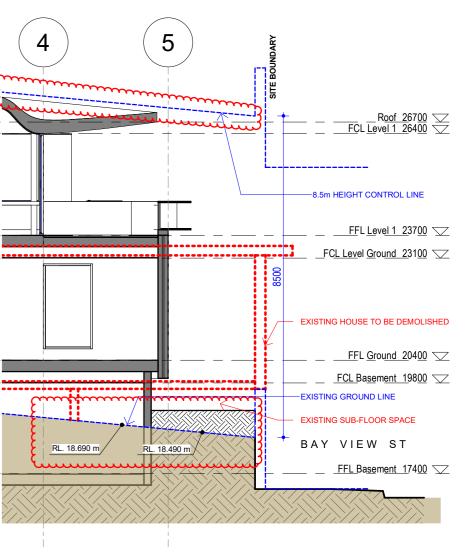

# Longitudinal Section EE Scale 1:100

JECT	ਸਸ∟∈				
King George St	Basement Plan + Elevations				
VENDER BAY, NSW 2060	JOB №.	drawing №.	rev.		
T 7 DP 520996	2024	INFO 01	B		
JECT DATE ISSUED DATE SCALE @ A3: 08 16.02.2022 1 : 100	STATUS DA ISSUE				



3 - EXISTING SUB-FLOOR SPACE (THOUGH NORTHERN HERITAGE WALL WINDOW) - EARTH AT SILL LEVEL



1 - BASEMENT - FACING SOUTH





4 - VISUAL ACCESS PAST BEAM IN BASEMENT TO UNDER GROUND FLOOR




2 - BASEMENT - FACING NORTH

Page 56

400mm

# 4 - EARTH UNDER FLOOR JOISTS OF GROUND FLOOR

JECT King George St	™LE Basement Ima	ages	
VENDER BAY, NSW 2060 T 7 DP 520996	JOB №. 2024	drawing №. INFO 02	rev. A
JECT DATE ISSUED DATE SCALE @ A3: 08 13.12.2021	STATUS DA ISSUE		

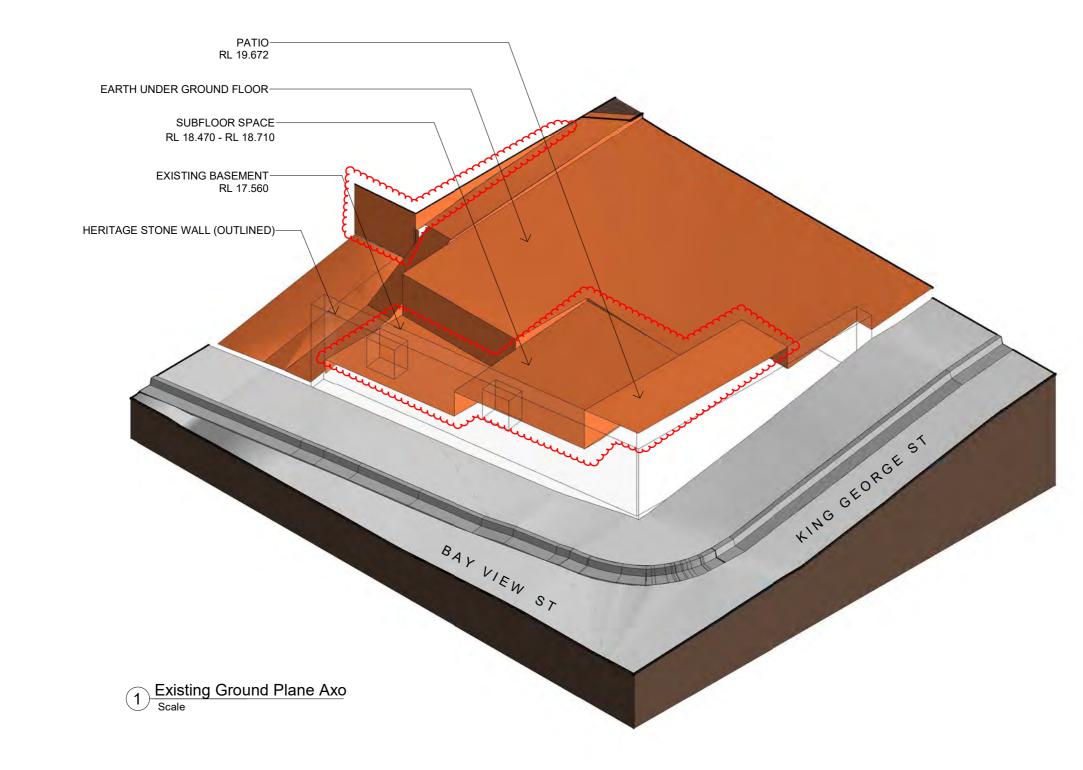

Date 13.12.2021	Rev Issue A Additional Info				CLIENT MB		. 1		PROJECT 21 King George	e St	TITLE Existing Gro	ound Plane Axo	
16.02.2022	B Issue for DA								LAVENDER BA		јов №. 2024	drawing No.	rev. B
computer syster	all not be liable for any loss or claims whatsoever arising from or in respect o n of the Architect to systems of the Client or other Consultants. The recipient Any use of the electronic data in part or whole shall be at the user's risk. Th	of the data shall be responsible for checking accuracy and completeness	NSW Nominated Architects: S. ISAACS #7929 ABN: 79 124 014 759	P: 02 - 9086 9000 F: 02 - 9086 9001	ARCHITECTURE SAVILLE ISAACS PTY LTD 23a KING GEORGE STREET, MCMAHONS POINT, NSW 2060	•	[ <sup>e</sup>   <sup>-</sup>	1		UED DATE SCALE @ A3: 02.2022	STATUS DA ISSUE		

200mm



PHOTOMONTAGE - KING GEORGE ST - EXISTING



PHOTOMONTAGE - KING GEORGE ST - PROPOSED

Date	Rev	Issue			1	CLIENT		,	PROJE
13.12.2021	Α	Additional Info			1	MB	,		21 k
	1						1		LAV
	1							150.0-	LOT
computer system	of the Archi	tect to systems of the Client or other Consultants. The recipient	of any errors existing or resulting from data howsoever transferred from the t of the data shall be responsible for checking accuracy and completeness the CAD files and their contents are solely representations of the project	NSW Nominated Architects: S. ISAACS #7929 ABN: 79 124 014 759	1	ARCHITECTURE SAVILLE ISAACS PTY LTD	4		PROJE



JECT King George St	™LE Streetscape - King Georg	e St
VENDER BAY, NSW 2060 T 7 DP 520996	JOB No. DRAWING No. 2024 INFO 04	REV. A
JECT DATE ISSUED DATE SCALE @ A3: 08 13.12.2021	STATUS DA ISSUE	





PHOTOMONTAGE **BAY VIEW ST - EXISTING** 

PHOTOMONTAGE **BAY VIEW ST - PROPOSED** 



			⊓⊤∟∈ Streetscap	oe - Bay View St	
VENDER BAY, NSW 2060 T 7 DP 520996			јов №. 2024	drawing No.	REV. A
JECT DATE ISSUED DATE SCALE @ A3: N 08 13.12.2021			STATUS DA ISSUE		

200

100mm



PREVIOUSLY SUBITTED

LATEST PROPOSED

### 21 KING GEORGE ST, PROPOSED BUILDING SUPERIMPOSED ONTO IMAGE PROVIDED BY AK PLANNING - UNIT 9 AT 21 WAIWERA ST

NOTE: INFORMATION OF PROVIDED IMAGE REGARDING CAMERA ANGLE AND TYPE, AND CAMERA POSITION FOR AN APPROPRIATE PROFESSIONAL VIEW ANALYSIS IS NOT PROVIDED.


PRELIMINARY							
	-		1				
Date Rev Issue			1	CLIENT		1	PRC
13.12.20 A View Analysis Comparison				MB			21
							1
	1				1		
1 1						Isaa-	<u> </u>
The Architect shall not be liable for any loss or claims whatsoever arising from or in respect of computer system of the Architect to systems of the Cleint or other Consultants. The recipient of data received. Any use of the electronic data in part or whole shall be at the user's risk. The	of the data shall be responsible for checking accuracy and completeness	NSW Nominated Architects: S. ISAACS #7929 ABN: 79 124 014 759		ARCHITECTURE SAVILLE ISAACS PTY LTD	4 N		PRO
• •	, , , , , , , , , , , , , , , , , , , ,		1	1	1		-

Page 60

<sub>ест</sub> King George St	TITLE View Analysis Con	nparison
	JOB №. DRAV 2024 01	VING No. REV. B
IECT DATE ISSUED DATE SCALE @ A3: 13.12.20	STATUS VIEW ANALYSIS	

100n

200n

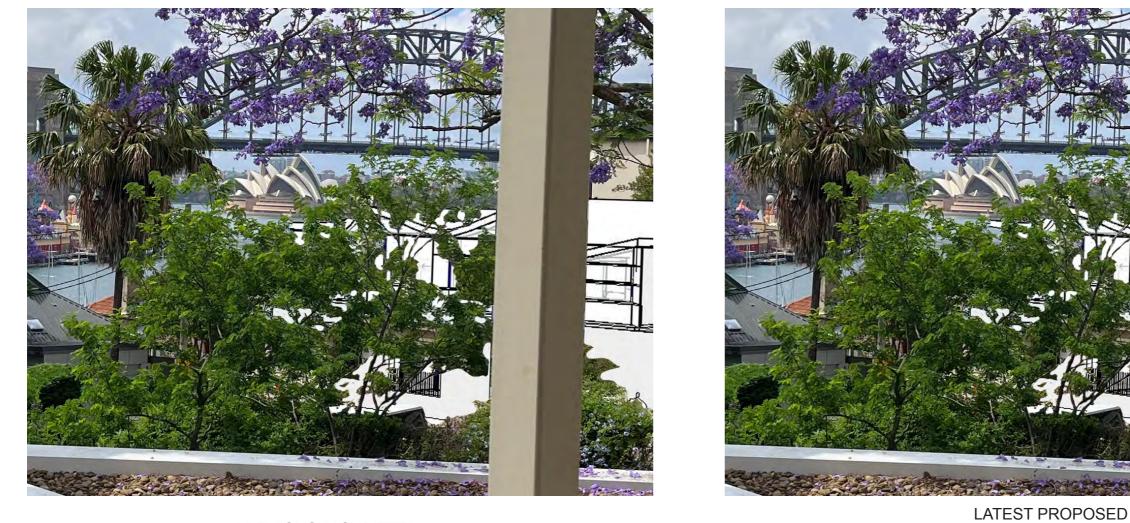

PREVIOUSLY SUBITTED

### 21 KING GEORGE ST, PROPOSED BUILDING SUPERIMPOSED ONTO IMAGE PROVIDED BY AK PLANNING - UNIT 9 AT 21 WAIWERA ST

NOTE: INFORMATION OF PROVIDED IMAGE REGARDING CAMERA ANGLE AND TYPE, AND CAMERA POSITION FOR AN APPROPRIATE PROFESSIONAL VIEW ANALYSIS IS NOT PROVIDED.

	PRELIMINARY							
		-						
Date Rev	Issue	 			CLIENT		1	PR
13.12.20 ¦ A	View Analysis Comparison	1			MB		1	21
1		1				: //		
1				1				
The Architect shall not be lia	ble for any loss or claims whatsoever arising from or in respect of	any errors existing or resulting from data howsoever transferred from the		D 00 0000 0000	1		344	PR
computer system of the Arch	itect to systems of the Client or other Consultants. The recipient	of the data shall be responsible for checking accuracy and completeness e CAD files and their contents are solely representations of the project	NSW Nominated Architects: S. ISAACS #7929 ABN: 79 124 014 759		ARCHITECTURE SAVILLE ISAACS PTY LTD 23a KING GEORGE STREET, MCMAHONS POINT, NSW 2060	્ય		PR
oi uata received. Arty use of	the electronic data in part of whole shall be at the user's lisk. The	CAD mes and their contents are solely representations of the project			· · · · · · · · · · · · · · · · · · ·	1	•	

Page 61




JECT       TITLE         King George St       View Analysis Comparison         JOB No.       DRAWING No.         2024       02         JECT DATE       ISSUED DATE         SCALE @ A3:       STATUS         VIEW ANALYSIS					
JECT DATE ISSUED DATE SCALE @ A3: STATUS				is Comparison	
				DRAWING No. $02$	BREV.
	JECT DATE		SCALE @ A3:	SIS	

PREVIOUSLY SUBITTED LATEST PROPOSED	

#### THROUGH DOUBLE DOORS TO BALCONY, **APARTMENT 10** CAMERA LOCATED 1m BEHIND WINDOW, AT 1.5m FROM FFL

ATTACHMENT TO LPP01 - 2/03/22

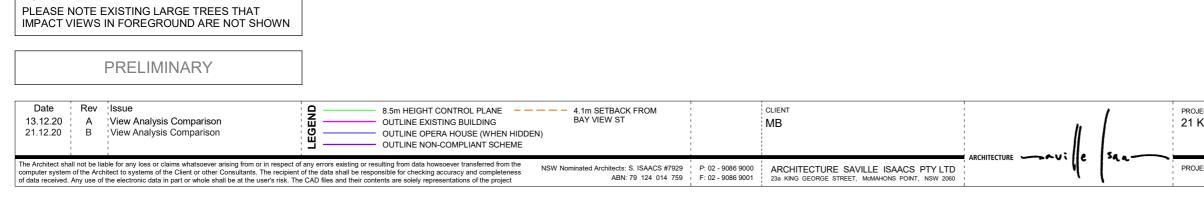


300mm

200m


NOTE

Page 62

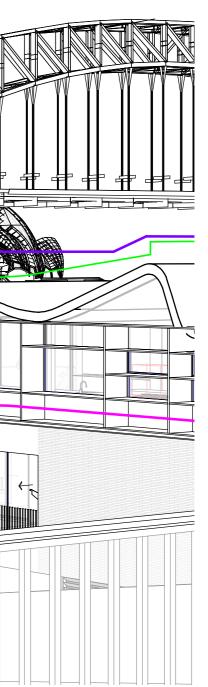

JECT King George St			TITLE View Analysis	Comparison	
		1	JOB No. 2024	DRAWING No.	BREV.
	SSUED DATE 3.12.20	SCALE @ A3:	STATUS VIEW ANALYSIS		

THROUGH EAST WINDOW, APARTMENT 10

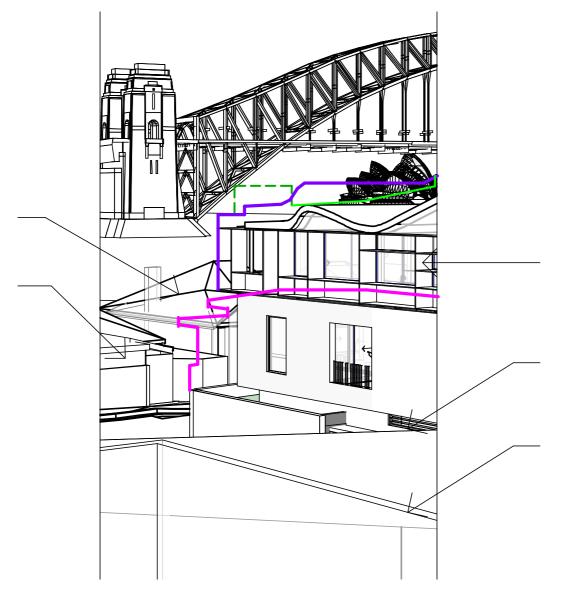




PREVIOUSLY SUBITTED

LATEST PROPOSED

100n

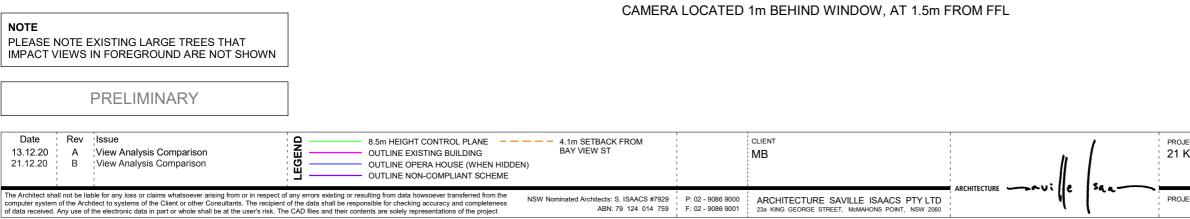


Page 63

JECT King George St			TITLE View Anal	ysis Comparison	
			јов №. <b>2024</b>	DRAWING №. <b>04</b>	BREV.
JECT DATE	ISSUED DATE 13.12.20	SCALE @ A3:	STATUS VIEW ANAL	YSIS	



Dmm

1000

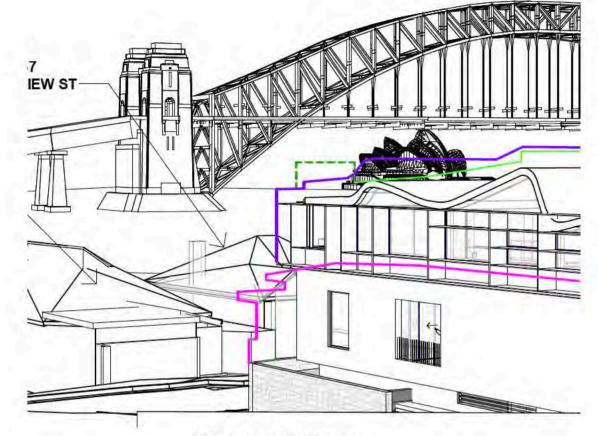

PREVIOUSLY SUBITTED




LATEST PROPOSED

ON BALCONY, APARTMENT 10 CAMERA LOCATED 1m BEHIND WINDOW, AT 1.5m FROM FFL

	E EXISTING LARGE TREES THAT IS IN FOREGROUND ARE NOT SHOWN								
	PRELIMINARY								
Date Rev 13.12.20 A 21.12.20 B	v Issue View Analysis Comparison View Analysis Comparison	8.5m HEIGHT CONTROL PLANE         OUTLINE EXISTING BUILDING         OUTLINE OPERA HOUSE (WHEN HIDDEN)         OUTLINE NON-COMPLIANT SCHEME	<ul> <li>4.1m SETBACK FROM BAY VIEW ST</li> </ul>	CLIENT MB			PROJECT 21 King George St	TITLE View Analysis Comparison JOB No. DRAWING No. 2024 05	REV. B
ne Architect shall not be amputer system of the A f data received. Any use	e liable for any loss or claims whatsoever arising from or in respect of Architect to systems of the Client or other Consultants. The recipient e of the electronic data in part or whole shall be at the user's risk. The	any errors existing or resulting from data howsoever transferred from the of the data shall be responsible for checking accuracy and completeness. CAD files and their contents are solely representations of the project	Nominated Architects: S. ISAACS #7929 ABN: 79 124 014 759	ARCHITECTURE SAVILLE ISAACS PTY LTD 23a KING GEORGE STREET, MOMAHONS POINT, NSW 2060	1		PROJECT DATE ISSUED DATE SCALE @ A3: 13.12.20	STATUS VIEW ANALYSIS	

100

200

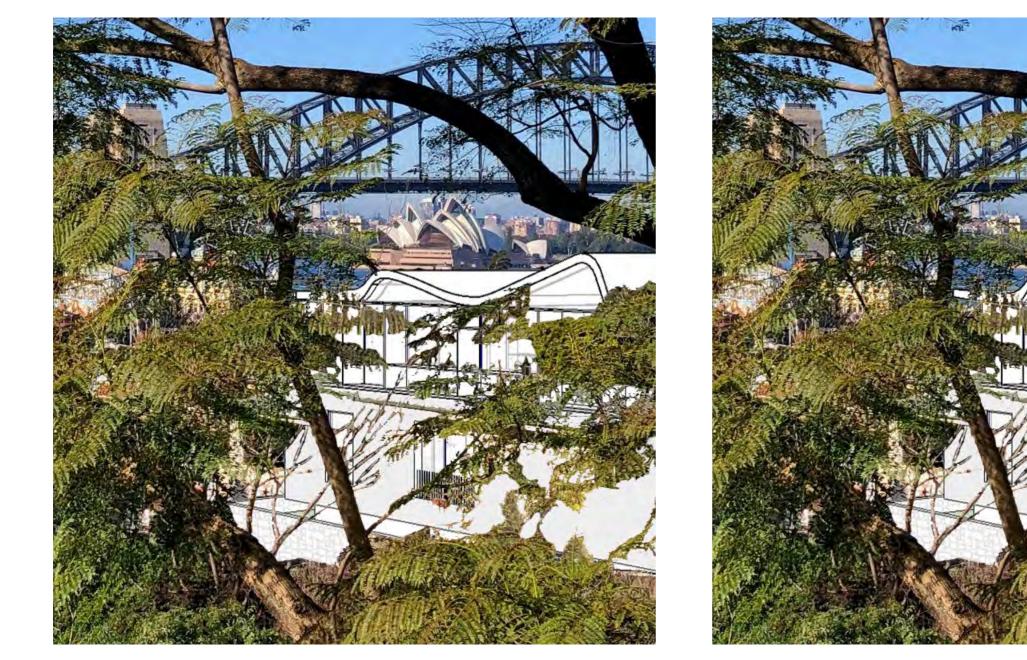

PREVIOUSLY SUBITTED

LATEST PROPOSED

## 21 KING GEORGE ST, PROPOSED BUILDING SUPERIMPOSED ONTO PROVIDED IMAGE FROM COUNCIL SUBMISSION - ATTACHMENT 1112664 - APARTMENT 10 AT 21 WAIWERA ST


NOTE: INFORMATION OF PROVIDED IMAGE REGARDING CAMERA ANGLE AND TYPE, AND CAMERA POSITION FOR AN APPROPRIATE PROFESSIONAL VIEW ANALYSIS IS NOT PROVIDED.


			_						
		PRELIMINARY							
Date	Rev	Issue				CLIENT		,	PROJ
13.12.20	Α	View Analysis Comparison				MB		1	211
	1		1				i //		
	1		1 1						
computer systen	n of the Arch	nitect to systems of the Client or other Consultants. The recipient	any errors existing or resulting from data howsoever transferred from the of the data shall be responsible for checking accuracy and completeness a CAD files and their contents are solely representations of the project	NSW Nominated Architects: S. ISAACS #7929 ABN: 79 124 014 759	P: 02 - 9086 9000 F: 02 - 9086 9001	ARCHITECTURE SAVILLE ISAACS PTY LTD 23a KING GEORGE STREET, MCMAHONS POINT, NSW 2060	ARCHITECTURE	542	PROJ





<sub>лест</sub> King Geo	orge St		TITLE View Analysis Comparison			
			JOB №. 2024	DRAWING №.	BREV.	
JECT DATE	ISSUED DATE 13.12.20	SCALE @ A3:	STATUS VIEW ANAL	YSIS		

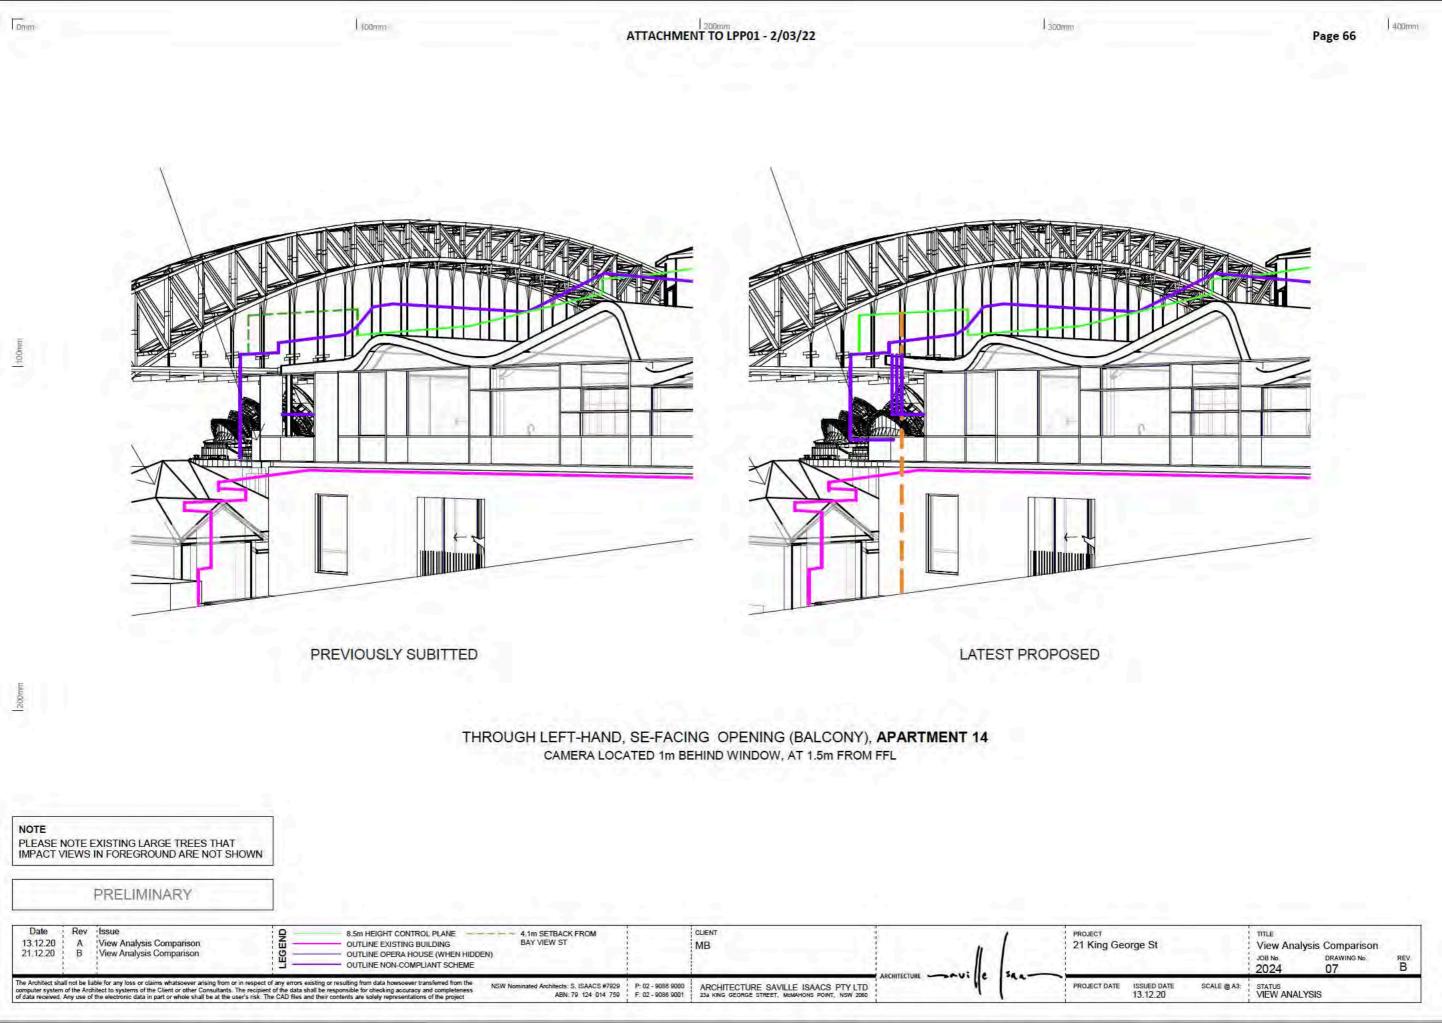

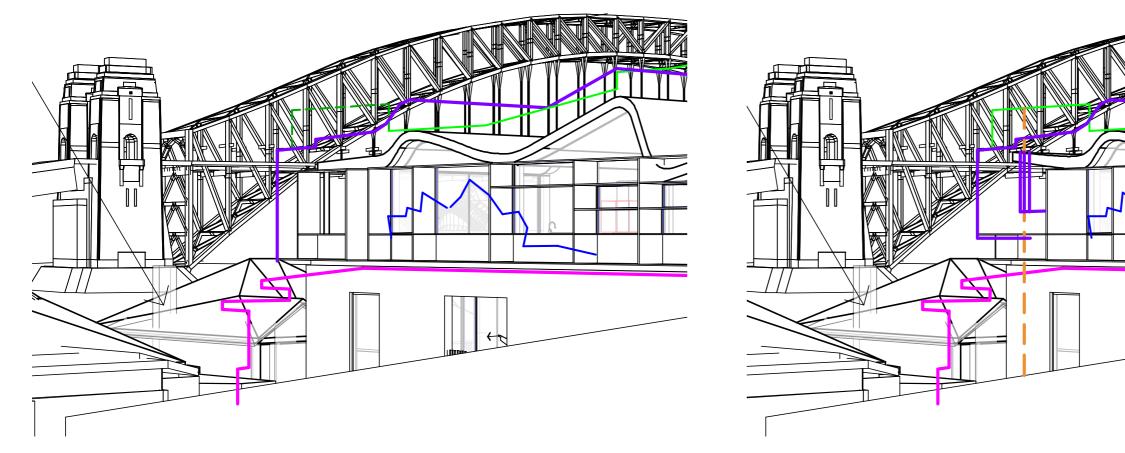


PREVIOUSLY SUBITTED

100mm


LATEST PROPOSED

## THROUGH RIGHT-HAND, SE-FACING WINDOW, APARTMENT 14 CAMERA LOCATED 1m BEHIND WINDOW, AT 1.5m FROM FFL

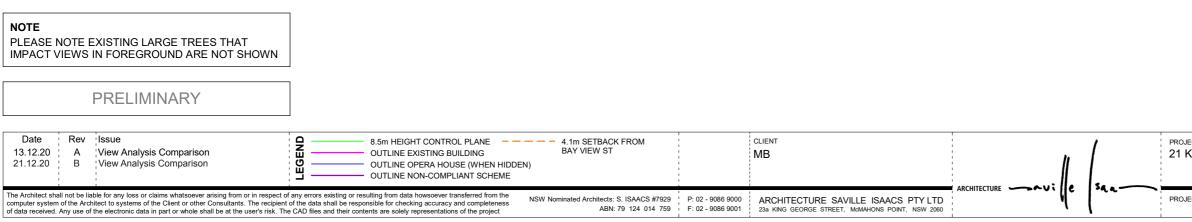

200n

Page 67

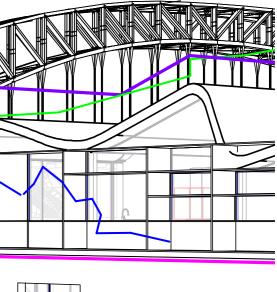




JECT King George St		TITLE View Analysis Comparison			
		јов №. <b>2024</b>	DRAWING №. <b>08</b>	BREV.	
JECT DATE ISSUED DAT 13.12.20	E SCALE @ A3:	STATUS VIEW ANAL	YSIS		

100

200n

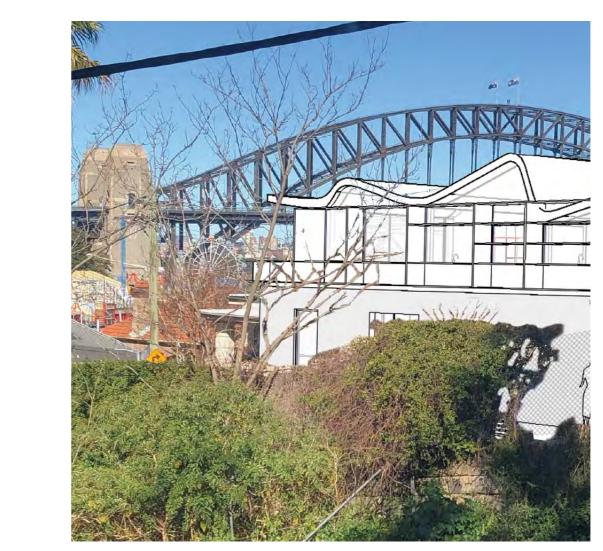

LATEST PROPOSED



PREVIOUSLY SUBITTED


21 KING GEORGE ST, PROPOSED BUILDING SUPERIMPOSED ONTO PROVIDED IMAGE FROM COUNCIL SUBMISSION - ATTACHMENT 1115539 - **APARTMENT 14 AT 21 WAIWERA ST** 

> **NOTE:** INFORMATION OF PROVIDED IMAGE REGARDING CAMERA ANGLE AND TYPE, AND CAMERA POSITION FOR AN APPROPRIATE PROFESSIONAL VIEW ANALYSIS IS NOT PROVIDED.

PRELIMINARY							
Date Rev Issue				CLIENT	1	1	PR
13.12.20 A View Analysis Comparison				MB		1	21
			1		: //	1	1
			1			1.	1
The Architect shall not be liable for any loss or claims whatsoever arising from or in respe computer system of the Architect to systems of the Client or other Consultants. The recip of data received. Any use of the electronic data in part or whole shall be at the user's risk	ent of the data shall be responsible for checking accuracy and completeness	NSW Nominated Architects: S. ISAACS #7929 ABN: 79 124 014 759		ARCHITECTURE SAVILLE ISAACS PTY LTD		59.4	PR

Page 68

JECT King George St	ਸਸ∟ View Analysis Comparison			
	job №. 2024	DRAWING №. <b>09</b>	BREV.	
JECT DATE ISSUED DA 13.12.20	 STATUS VIEW ANAL	YSIS		

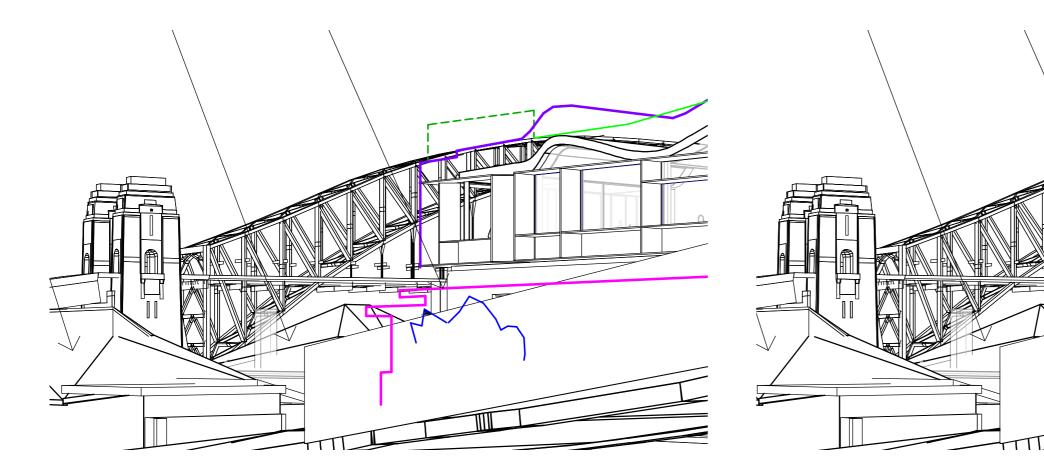


LATEST PROPOSED

PREVIOUSLY SUBITTED

100mm


THROUGH LEFT-HAND, SE-FACING WINDOW, **APARTMENT 17** CAMERA LOCATED 1m BEHIND WINDOW, AT 1.5m FROM FFL

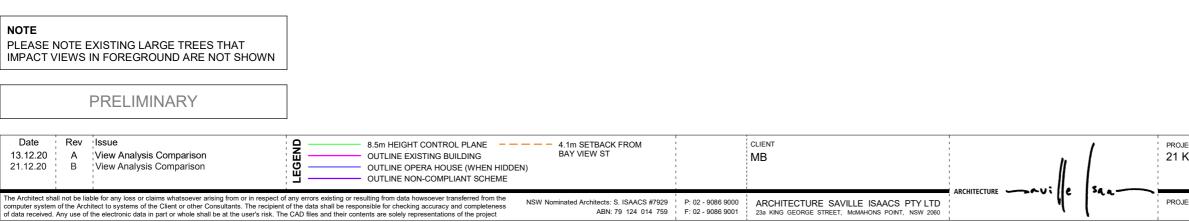

0mm

200r


Page 69

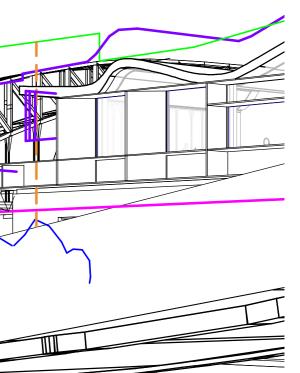


<sub>лест</sub> King Geo	orge St		ागाम View Analysis Comparison			
			JOB №. 2024	drawing №. 010	rev. B	
JECT DATE	ISSUED DATE 13.12.20	SCALE @ A3:	STATUS VIEW ANALYSIS	;		

100n

200m

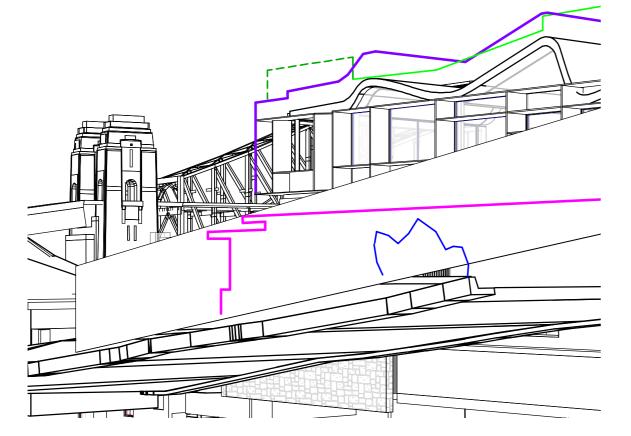


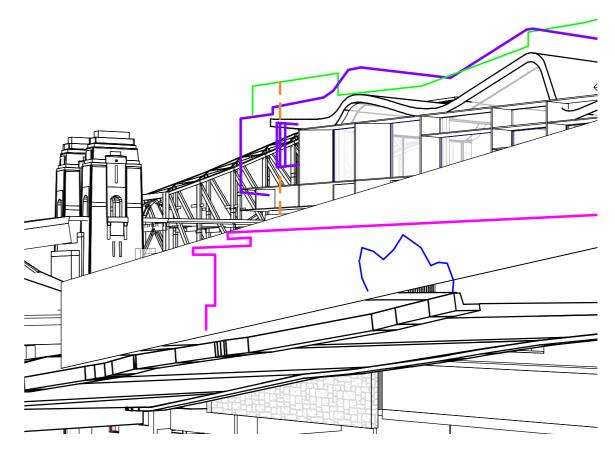

PREVIOUSLY SUBITTED

LATEST PROPOSED

# THROUGH RIGHT-HAND, SE-FACING WINDOW, APARTMENT 17 CAMERA LOCATED 1m BEHIND WINDOW, AT 1.5m FROM FFL

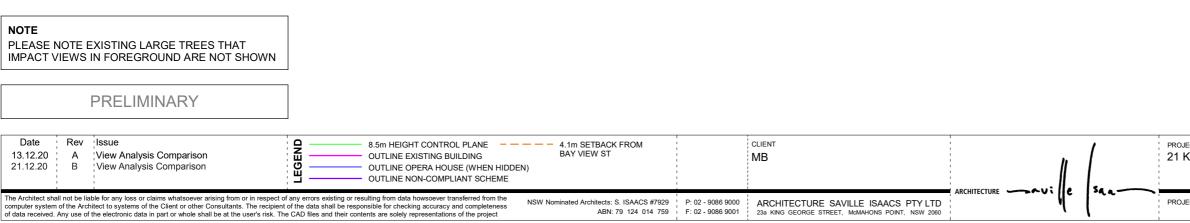


Page 70

<sub>лест</sub> King Geo	orge St		тп∟е View Analysis Comparison			
			јов №. <b>2024</b>	drawing №. 011	BREV.	
JECT DATE	ISSUED DATE 13.12.20	SCALE @ A3:	STATUS VIEW ANAL	YSIS		

100n


200n

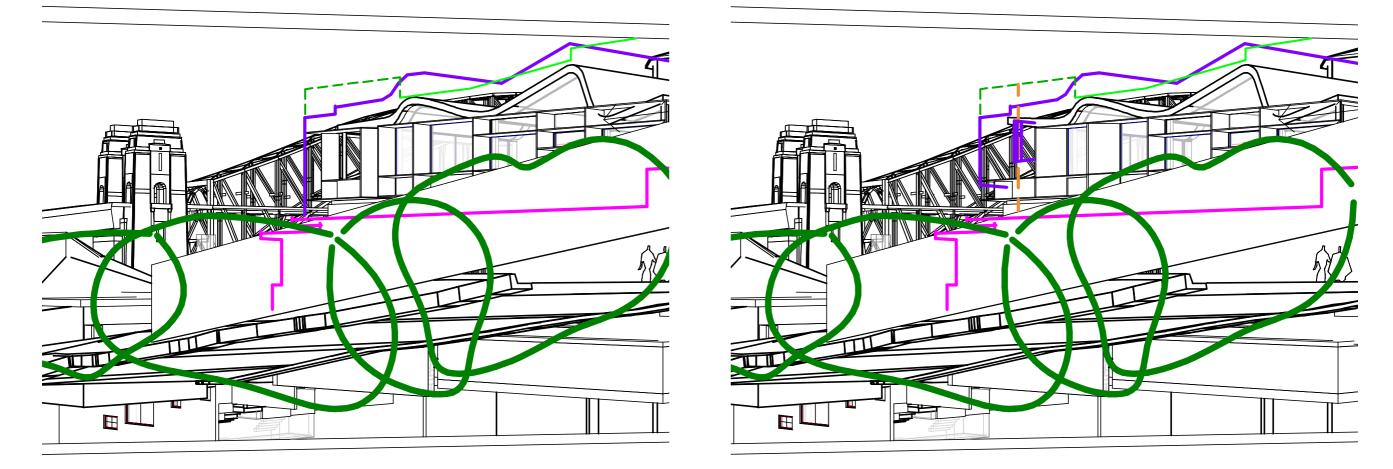

PREVIOUSLY SUBITTED

LATEST PROPOSED

# THROUGH RIGHT-HAND, SE-FACING WINDOW, APARTMENT 17 LOCATED TO MATCH VIEW SEEN IN OBJECTED IMAGE

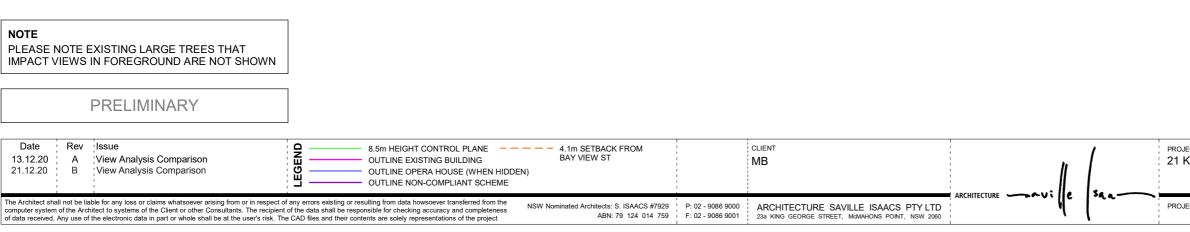

Page 71

<sub>лест</sub> King Geo	orge St		ттье View Analysis Comparison			
			JOB No. 2024	DRAWING №. 012	BREV.	
JECT DATE	ISSUED DATE 13.12.20	SCALE @ A3:	STATUS VIEW ANAL	YSIS		



PREVIOUSLY SUBITTED


100mm

LATEST PROPOSED

300mm

## 21 KING GEORGE ST, PROPOSED BUILDING SUPERIMPOSED ONTO PROVIDED IMAGE FROM COUNCIL SUBMISSION - ATTACHMENT 1115754 - UNIT 17 AT 21 WAIWERA ST

**NOTE:** INFORMATION OF PROVIDED IMAGE REGARDING CAMERA ANGLE AND TYPE, AND CAMERA POSITION FOR AN APPROPRIATE PROFESSIONAL VIEW ANALYSIS IS NOT PROVIDED.

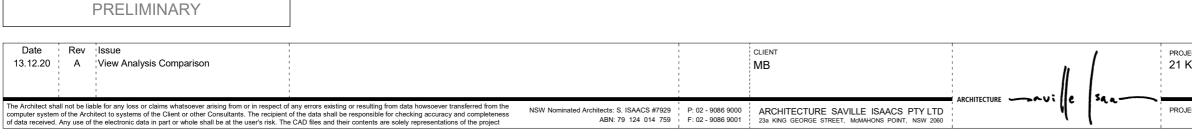


200n

Page 72



<sub>ЕСТ</sub> King George St	ππε View Analysis Comparison			
	JOB №. 2024	drawing №. 013	BREV.	
IECT DATE ISSUED DATE SCALE @ A3: 13.12.20	STATUS VIEW ANALYSIS	6		

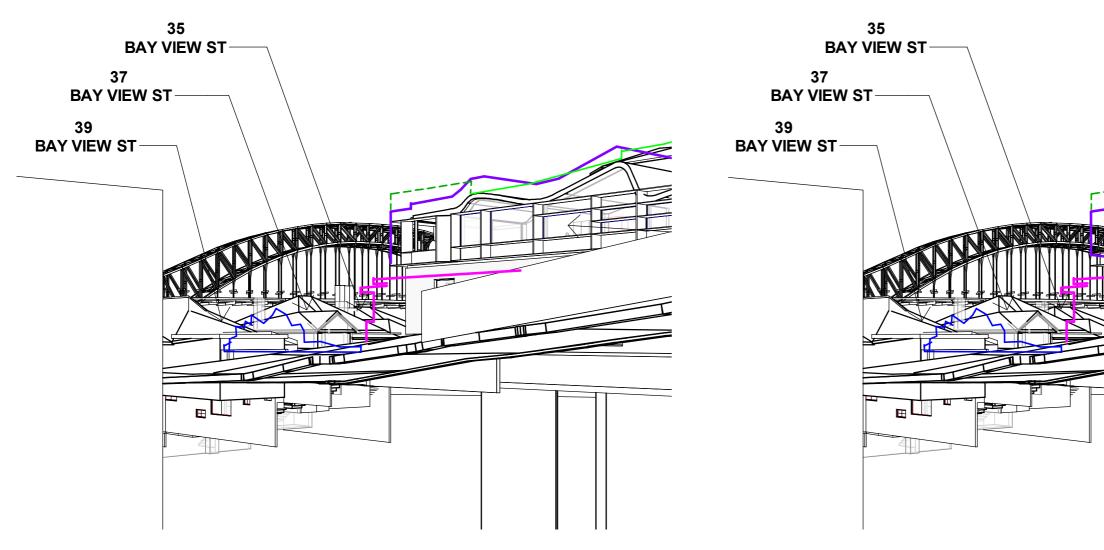

PREVIOUSLY SUBITTED


100mm

LATEST PROPOSED

| <sub>300mm</sub>

VIEW FROM MAIN GARDEN, REAR OF 21 WAIWERA ST

LOCATED 4m BEHIND REAR BRICK WALL

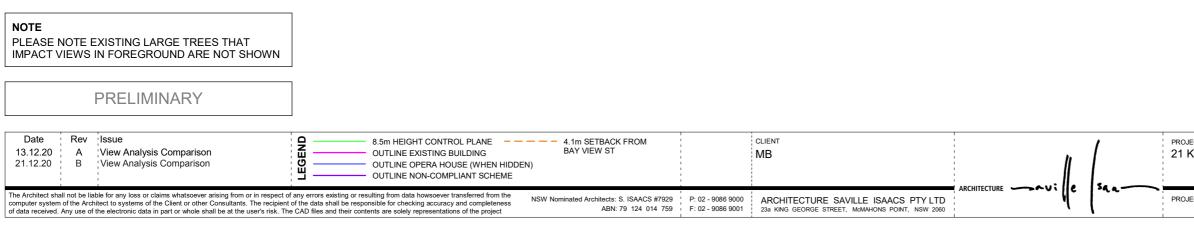


100

200r


Page 73

JECT	TITLE			
King George St	View Analysis Comparison			
	JOB No. DRAWING No. REV. 2024 014 B			
JECT DATE ISSUED DATE SCALE @ A3	STATUS			
13.12.20	VIEW ANALYSIS			

ATTACHMENT TO LPP01 - 2/03/22

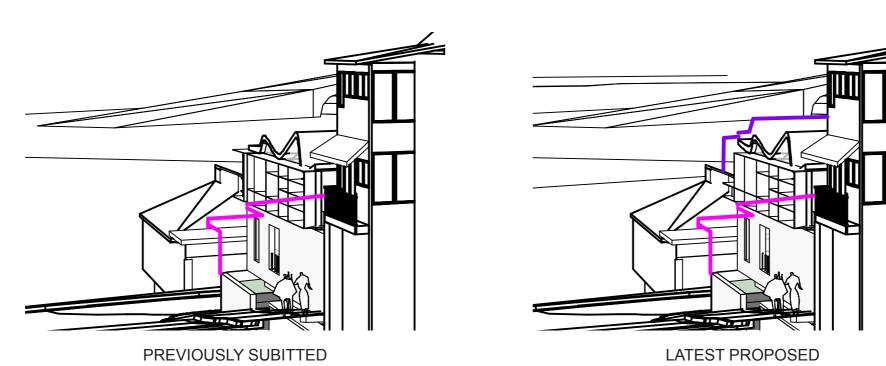

King George St - View 01

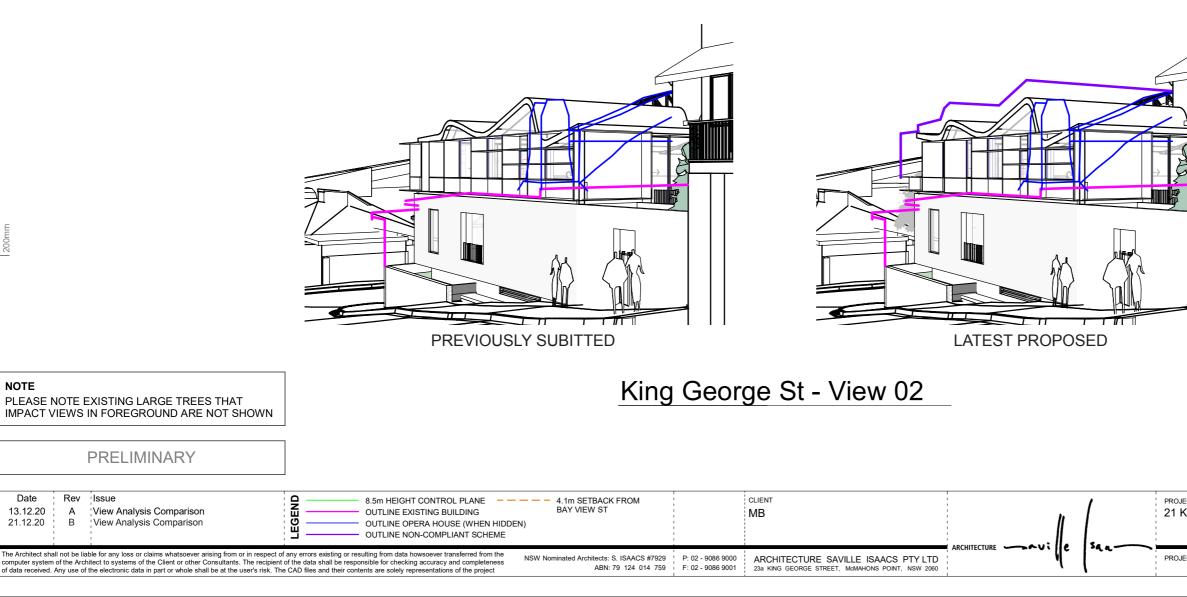

200n

NOTE

Date

13.12.20


21.12.20

0mm

300mm

Page 74




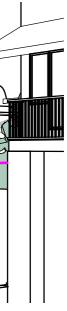

<sub>лест</sub> King Geo	orge St		TITLE View Analysis Comparison			
			JOB №. 2024	drawing №. 015	BREV.	
JECT DATE	ISSUED DATE 13.12.20	SCALE @ A3:	STATUS VIEW ANALY	/SIS		



King George St - View 03

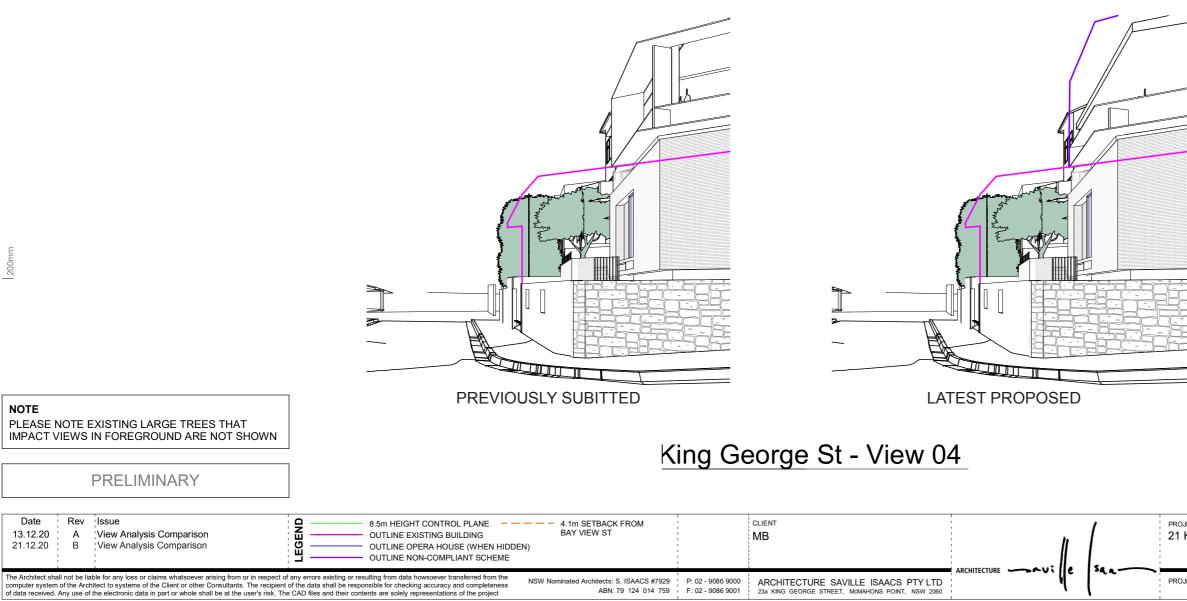


100m


PROJECT 21 King George St TITLE View Analysis Comparison DRAWING No. JOB No. REV. 2024 016 ISSUED DATE 13.12.20 PROJECT DATE SCALE @ A3: STATUS VIEW ANALYSIS


Page 75



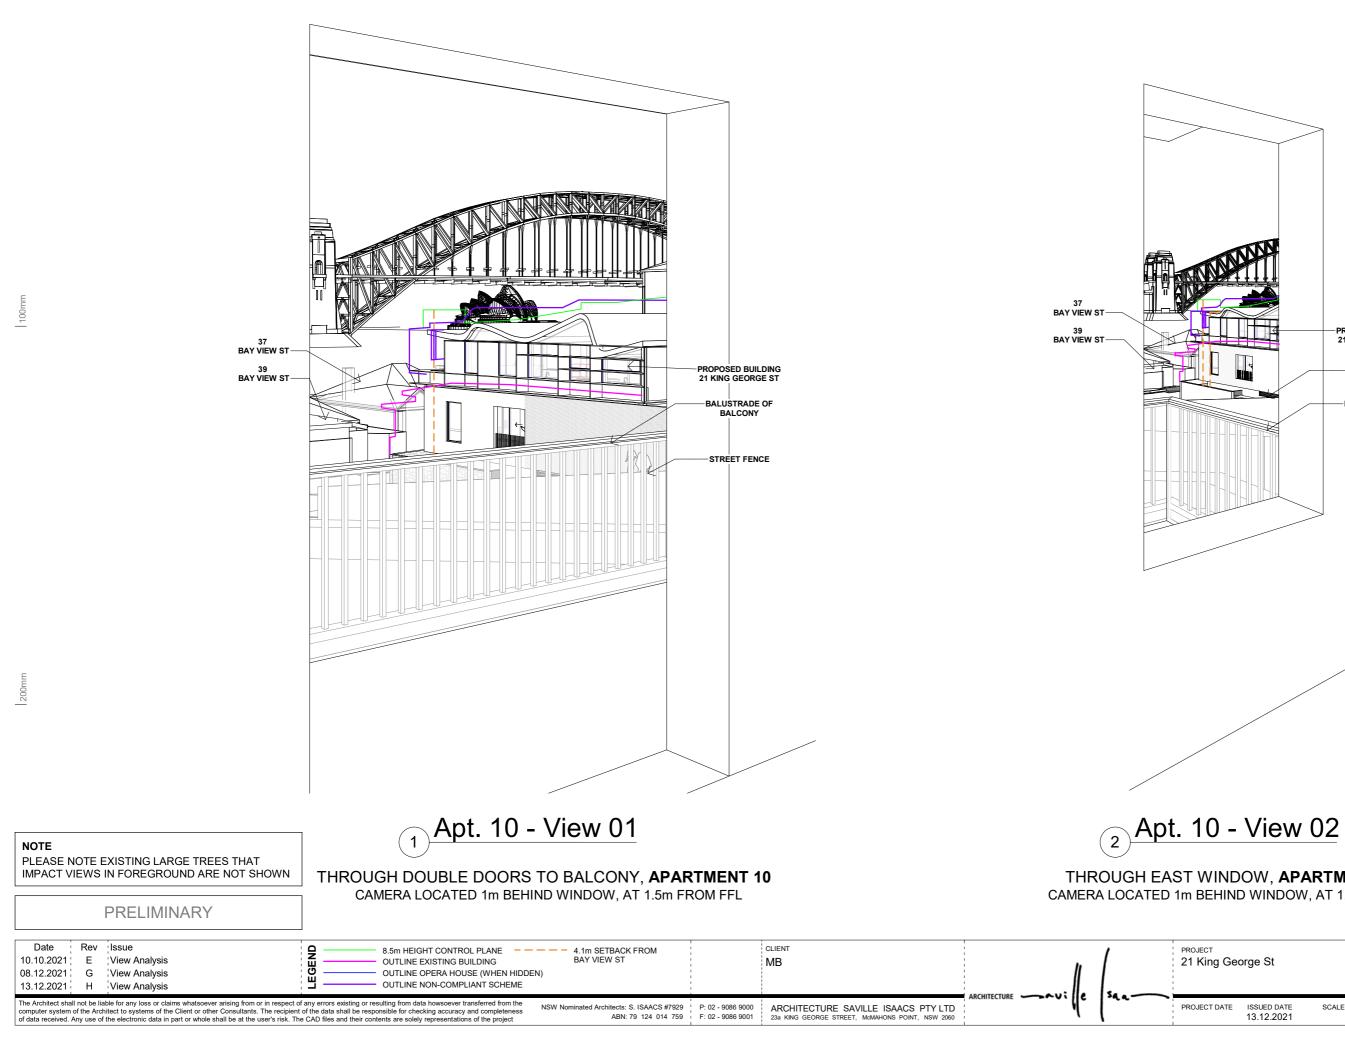

Page 76

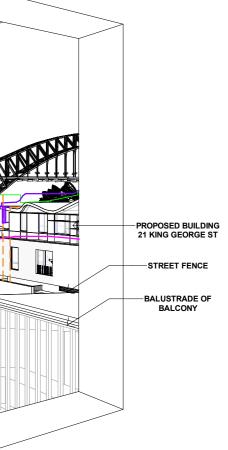


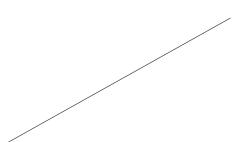


# THROUGH EAST WINDOW, APARTMENT 10

CAMERA LOCATED 1m BEHIND WINDOW, AT 1.5m FROM FFL

<sub>јест</sub> King Geo	orge St		ਸਸ∟ 21 Waiwera - Apt 10 View 1 + 2				
			JOB No. 2024	drawing №. 01	rev. H		
JECT DATE	ISSUED DATE 13.12.2021	SCALE @ A3:	STATUS VIEW ANAL	YSIS			

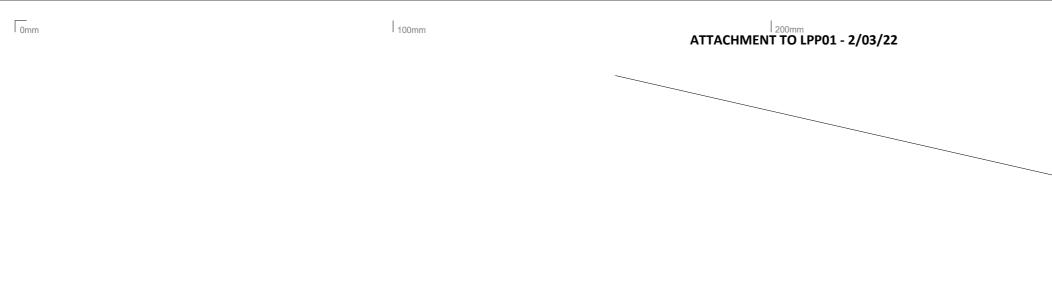

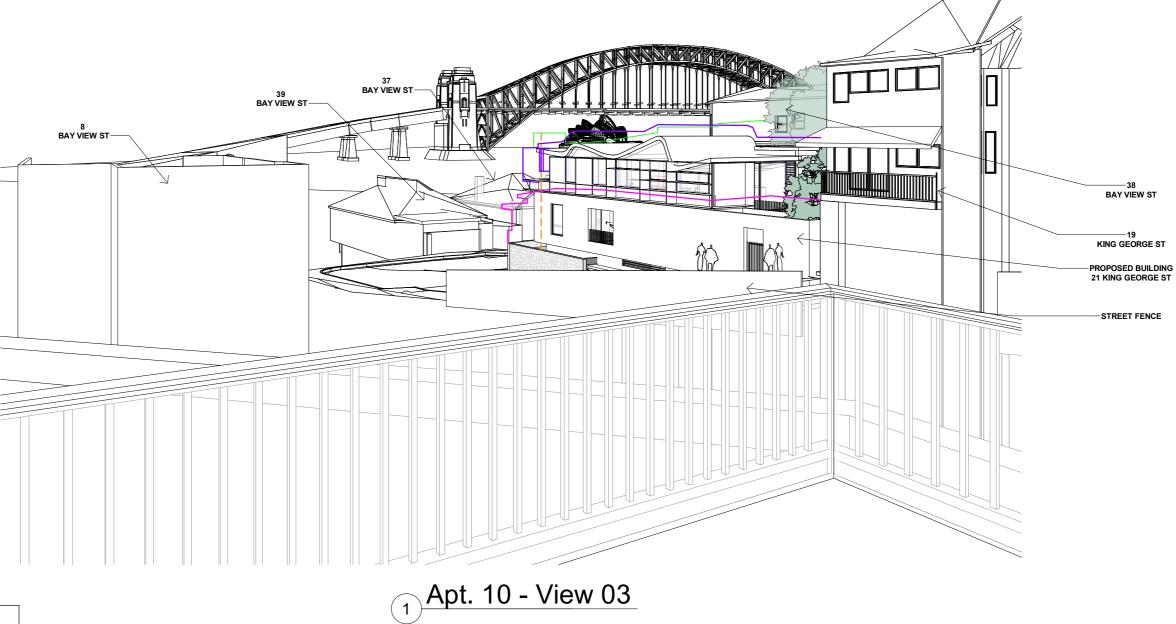

NOTE PLEASE NOTE EXISTING LARGE TREES THAT IMPACT VIEWS IN FOREGROUND ARE NOT SHOWN

PRELIMINARY

# ON BALCONY, APARTMENT 10

CAMERA LOCATED 1m BEHIND WINDOW, AT 1.5m FROM FFL


Date Rev Issue	8.5m HEIGHT CONTROL PLANE	4.1m SETBACK FROM	1	CLIENT	1	1	PROJECT		TITLE		
10.10.2021 E View Analysis	OUTLINE EXISTING BUILDING	BAY VIEW ST	1	MB			21 King George St		21 Waiwera	- Apt 10 View	/3
08.12.2021 G View Analysis		4)			· //				JOB No.	DRAWING No.	REV.
13.12.2021 H View Analysis	OUTLINE NON-COMPLIANT SCHEME		1						2024	02	H
computer system of the Architect to systems of the Client or othe	er arising from or in respect of any errors existing or resulting from data howsoever transferred from the er Consultants. The recipient of the data shall be responsible for checking accuracy and completeness shall be at the user's risk. The CAD files and their contents are solely representations of the project	NSW Nominated Architects: S. ISAACS #7929 ABN: 79 124 014 759		ARCHITECTURE SAVILLE ISAACS PTY LTD		*A A	PROJECT DATE ISSUED DATE 13.12.2021	SCALE @ A3:	STATUS VIEW ANALYS	SIS	

200mm

Page 77

100r

200r

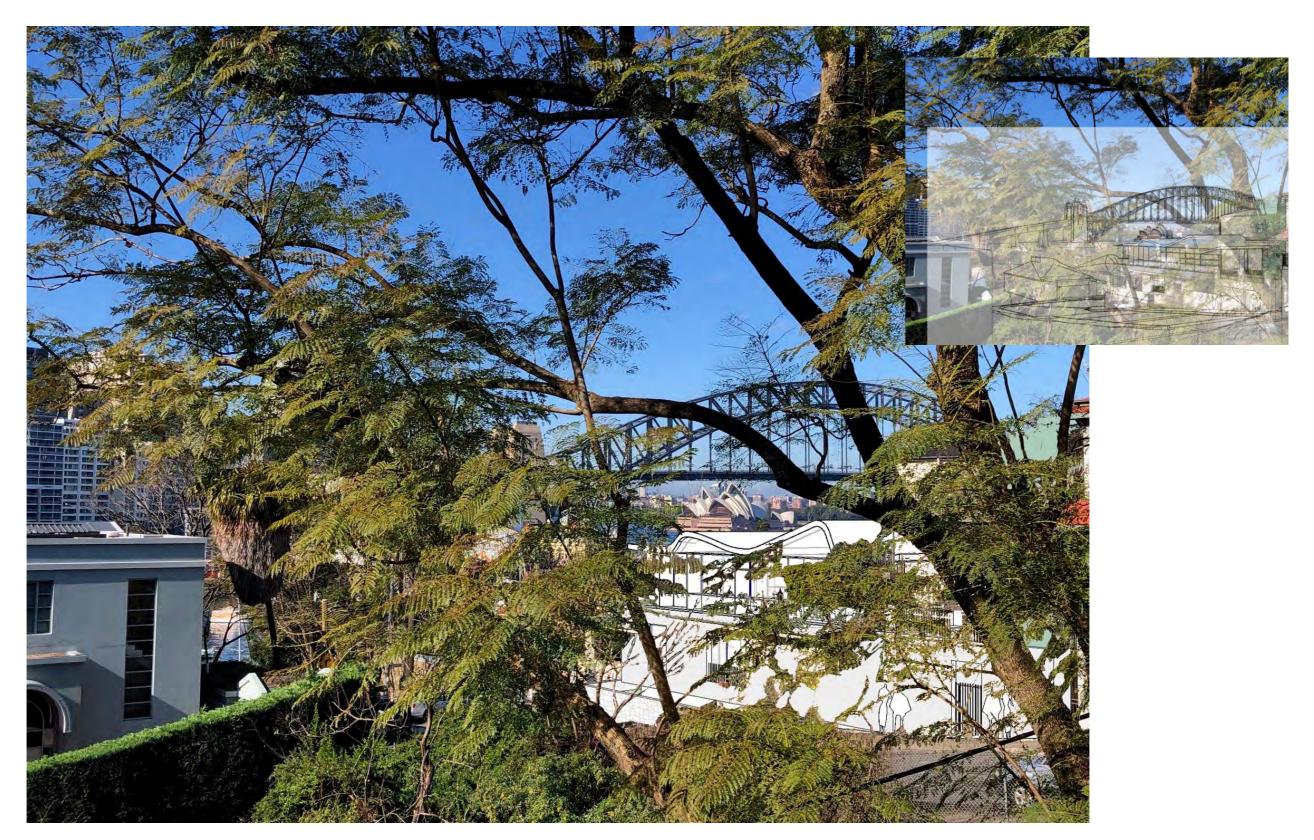

## 21 KING GEORGE ST, PROPOSED BUILDING SUPERIMPOSED ONTO PROVIDED IMAGE FROM COUNCIL SUBMISSION - ATTACHMENT 1112664 - **APARTMENT 10 AT 21 WAIWERA ST**

PRELIMINARY			NOTE: TRACE OVERLAY IN TO TO ILLUSTRATE RELATIVE AC REVIT MODEL OVER PROVID	CURACY OF	NOTE: INFORMATION OF PROVID ANGLE AND TYPE, AND CAMERA PROFESSIONAL VIEW AN	POSITION FOR AN APPRO	PRIATE		
10.10.2021	E	Issue View Analysis View Analysis				client MB			PRO. 21
computer system	of the Arc	hitect to systems of the Client or other Consultants. The recipient	f any errors existing or resulting from data howsoever transferred from the of the data shall be responsible for checking accuracy and completeness e CAD files and their contents are solely representations of the project	NSW Nominated Architects: S. ISAACS #7929 ABN: 79 124 014 759		ARCHITECTURE SAVILLE ISAACS PTY LTD 23a KING GEORGE STREET, MOMAHONS POINT, NSW 2060		*a a	PRO.

JECT King Geo	orge St		ппье 21 Waiwera - Apt 10 Overlay				
0	0		JOB №. <b>2024</b>	DRAWING No.	, rev. H		
JECT DATE	ISSUED DATE 13.12.2021	SCALE @ A3:	STATUS VIEW ANAL	YSIS			

100n

NOTE

Date

10.10.2021

08.12.2021

13.12.2021

G

View Analysis


The Architect shall not be liable for any loss or claims whatsoever arising from or in respect of any errors existing or resulting from data howsoever transferred from the computer system of the Architect to systems of the Client or other Consultants. The recipient of the data shall be responsible for checking accuracy and completeness of data received. Any use of the electronic data in part or whole shall be at the user's risk. The CAD files and their contents are solely representations of the project

H <sup>1</sup>View Analysis

OUTLINE OPERA HOUSE (WHEN HIDDEN)

NSW Nominated Architects: S. ISAACS #7929 P: 02 - 9086 9000 ABN: 79 124 014 759 F: 02 - 9086 9001

OUTLINE NON-COMPLIANT SCHEME

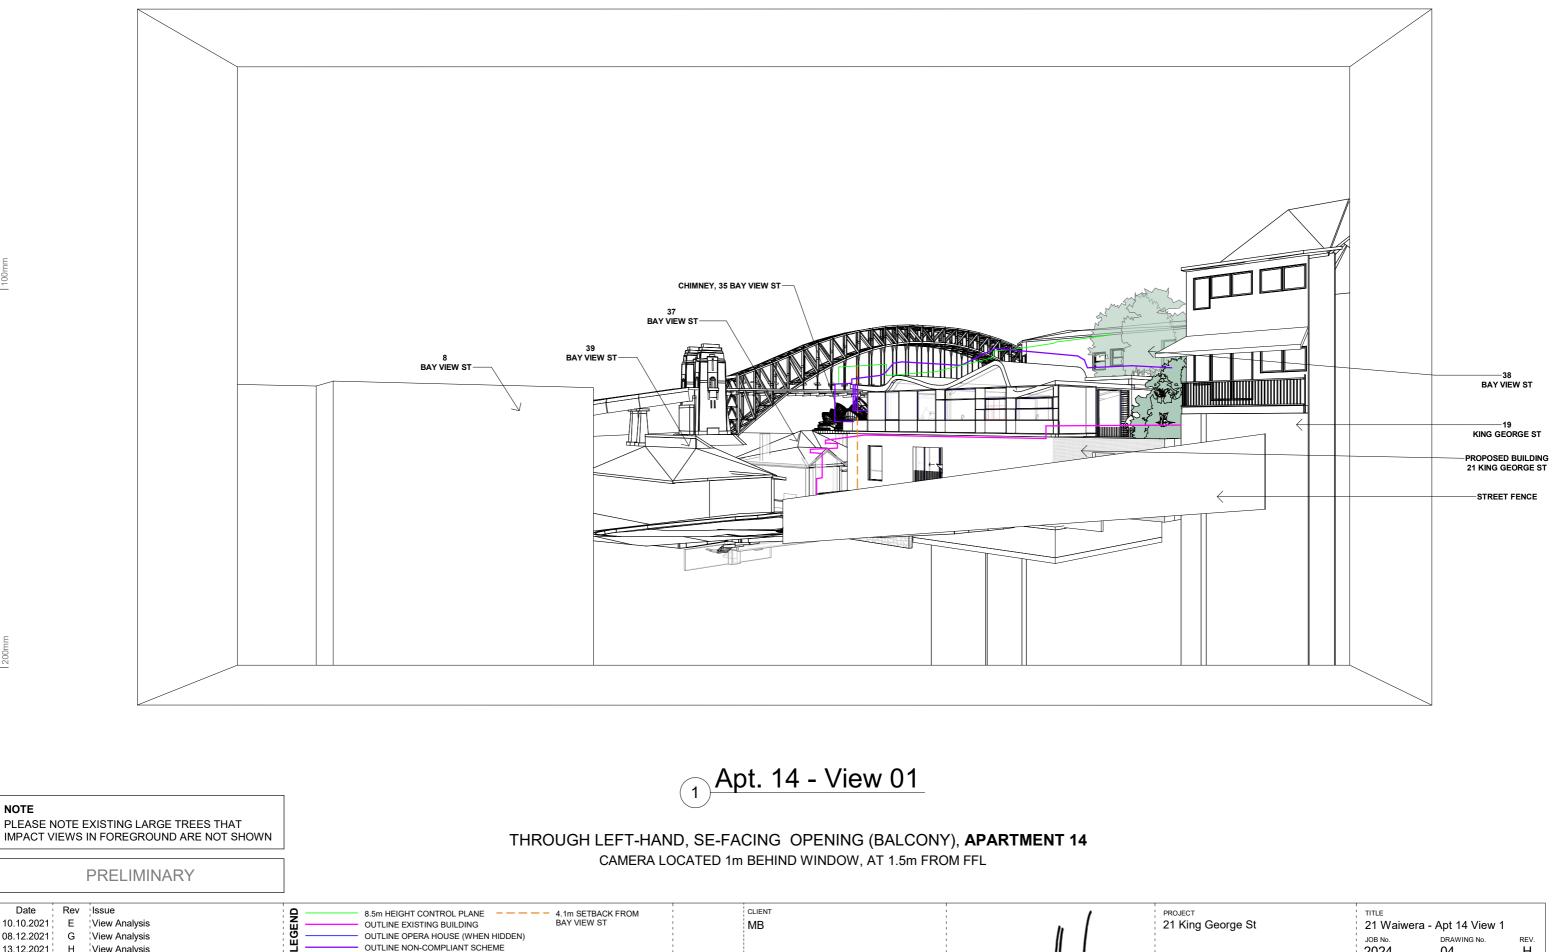

ARCHITECTURE SAVILLE ISAACS PTY LTD 23a KING GEORGE STREET, MCMAHONS POINT, NSW 2060

ARCHITECTURE


-~ui

e


Sa. 1

Page 79

PROJECT 21 King Geo	orge St		TITLE 21 Waiwer	ra - Apt 14 View 1	
			јов №. 2024	DRAWING №. <b>04</b>	rev. H
PROJECT DATE	ISSUED DATE 13.12.2021	SCALE @ A3:	STATUS	YSIS	

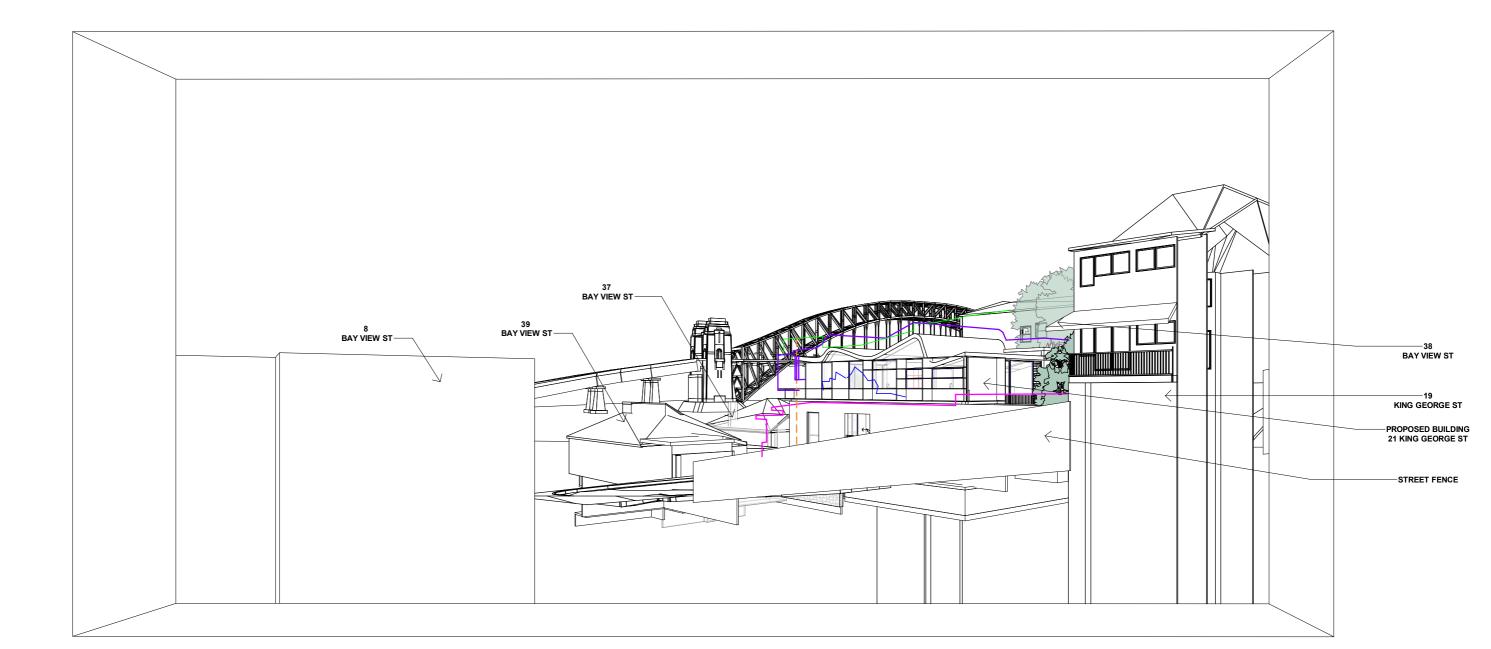


100n

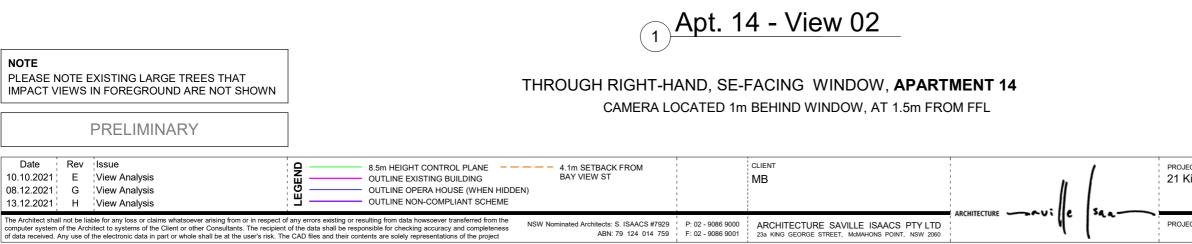

JECT King Geo	orge St		TITLE 21 Waiwera - Apt 14 View 2			
King George St			JOB No. 2024	DRAWING No. 05	rev. H	
JECT DATE	ISSUED DATE 13.12.2021	SCALE @ A3:	STATUS VIEW ANAL	YSIS		

100m

200m

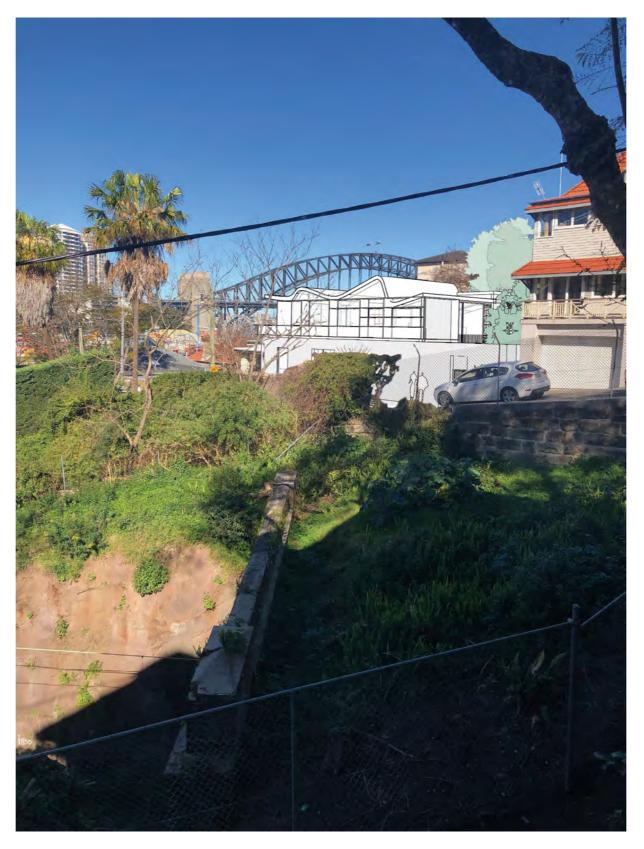



# 21 KING GEORGE ST, PROPOSED BUILDING SUPERIMPOSED ONTO PROVIDED IMAGE FROM COUNCIL SUBMISSION - ATTACHMENT 1115539 - **APARTMENT 14 AT 21 WAIWERA ST**

	PRELIMINARY	]	NOTE: TRACE OVERLAY IN TO TO ILLUSTRATE RELATIVE ACC REVIT MODEL OVER PROVID	CURACY OF	NOTE: INFORMATION OF PROVID ANGLE AND TYPE, AND CAMERA PROFESSIONAL VIEW AN	POSITION FOR AN APPRO	OPRIATE	
10.10.2021	Rev Issue E View Analysis H View Analysis				CLIENT MB	.//	[.	PROJ
computer system of t		of f any errors existing or resulting from data howsoever transferred from the t of the data shall be responsible for checking accuracy and completeness he CAD files and their contents are solely representations of the project	NSW Nominated Architects: S. ISAACS #7929 ABN: 79 124 014 759		ARCHITECTURE SAVILLE ISAACS PTY LTD 23a KING GEORGE STREET, MOMAHONS POINT, NSW 2060		saa	PROJ



JECT	דודLE			
King George St	21 Waiwera - Apt 14 Overlay			
	JOB No. DRAWING No. REV. 2024 06 H			
JECT DATE ISSUED DATE SCALE @ A	STATUS			
13.12.2021	VIEW ANALYSIS			

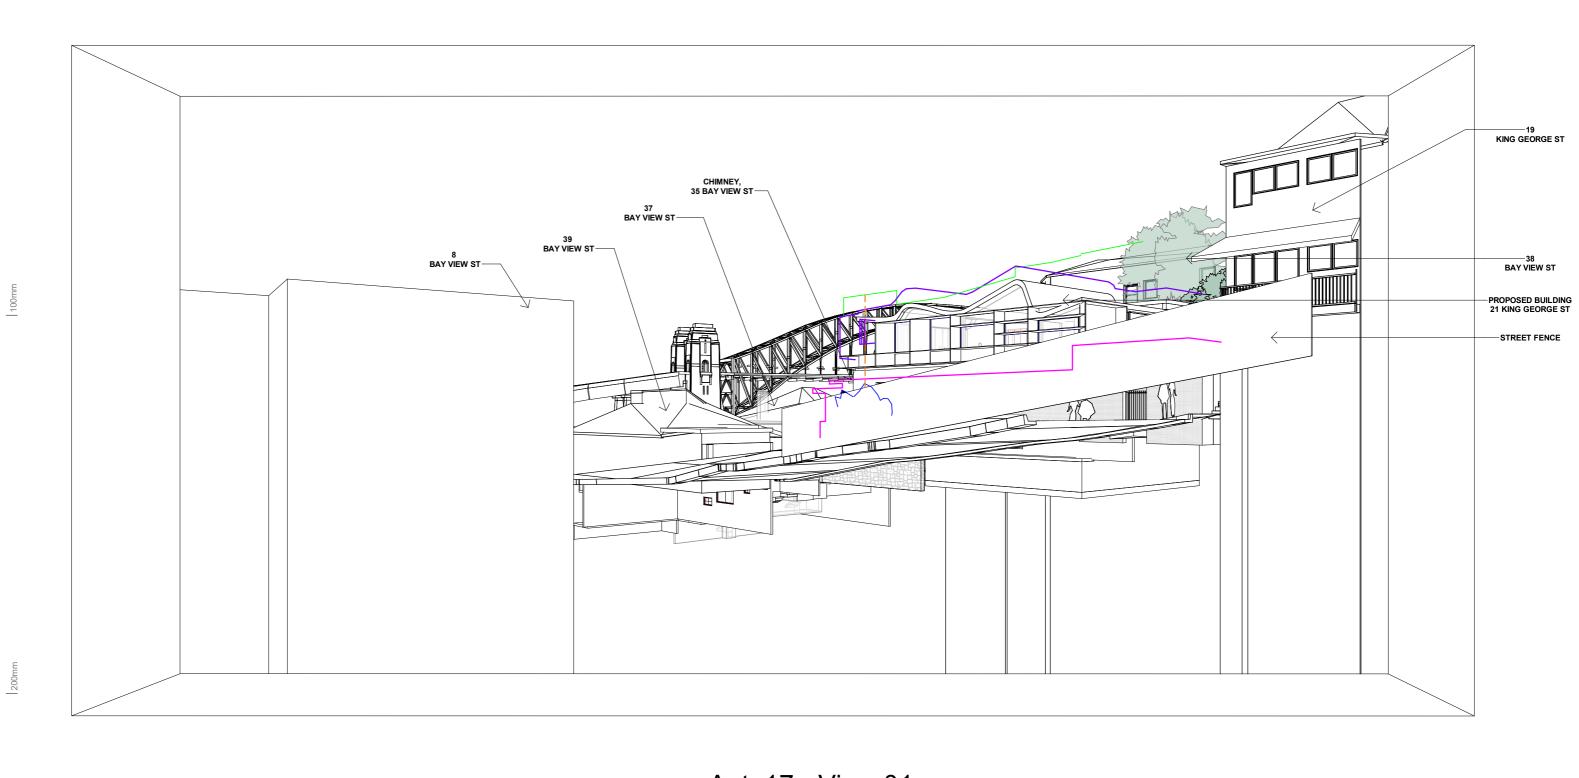


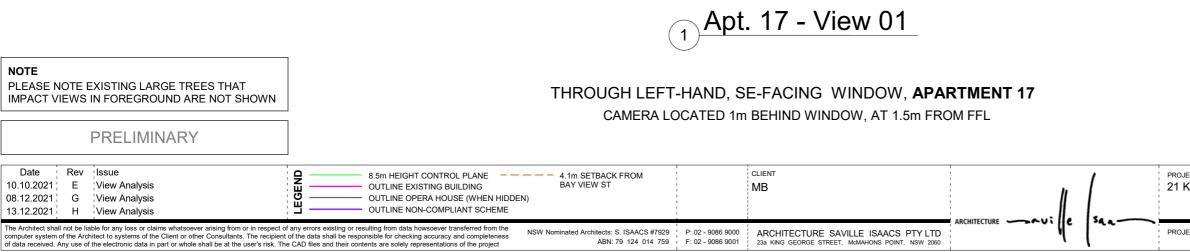


Page 82

JECT	דודנב		
King George St	21 Waiwera - Apt 17 View 1		
	JOB NO. DRAWING NO. REV. 2024 07 H		
JECT DATE ISSUED DATE SCALE @ A	STATUS		
13.12.2021	VIEW ANALYSIS		

ATTACHMENT TO LPP01 - 2/03/22

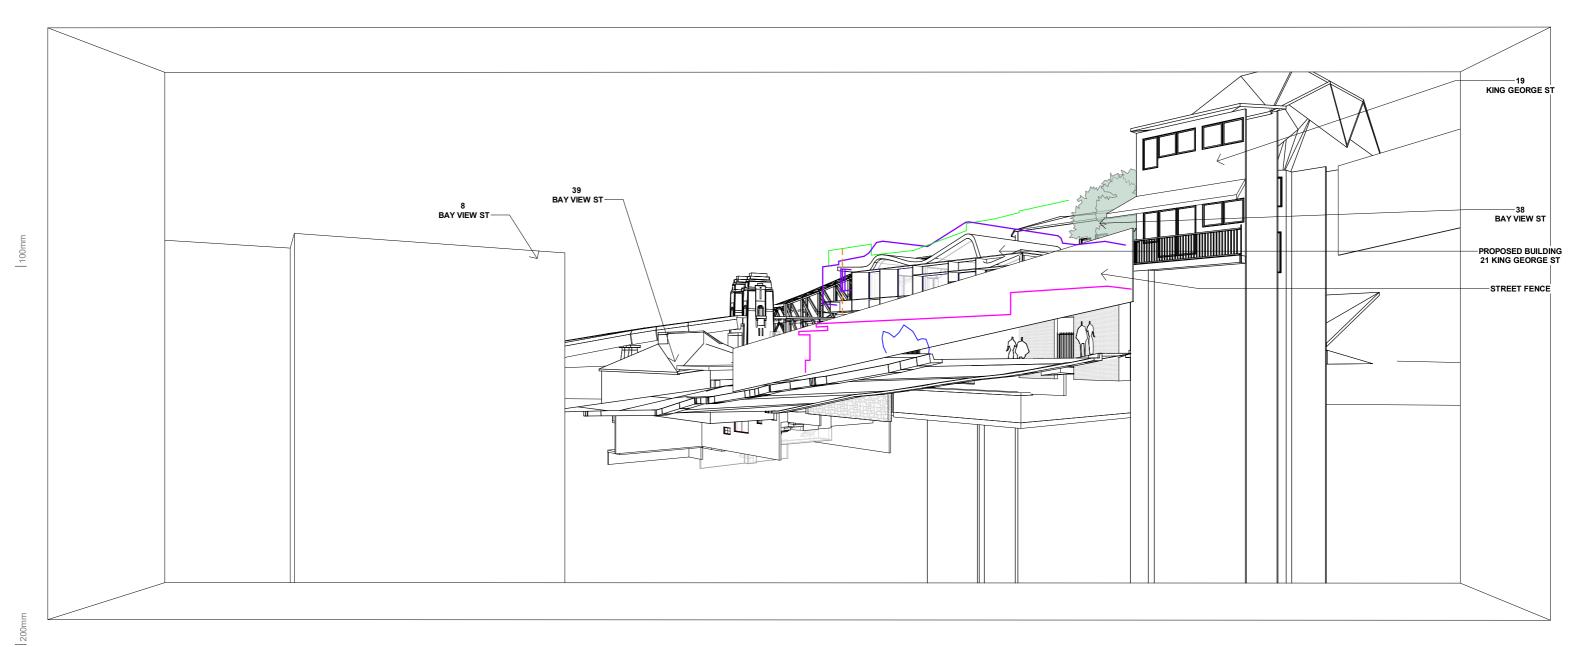

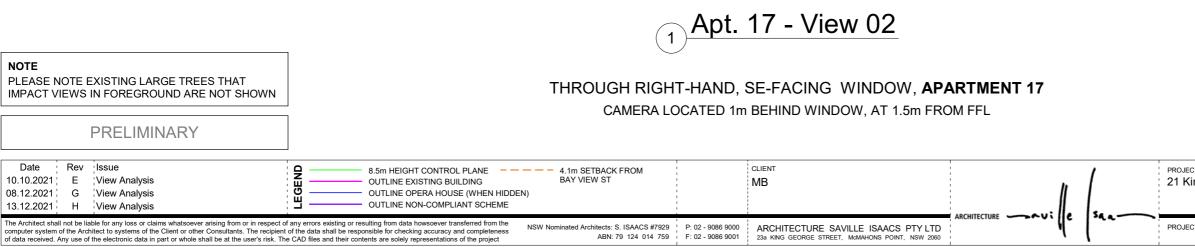


100mm

Page 83

JECT King Geo	orge St		TITLE 21 Waiwe	ra - Apt 17 View 2	
			JOB №. <b>2024</b>	DRAWING №. <b>08</b>	rev. H
JECT DATE	ISSUED DATE 13.12.2021	SCALE @ A3:	STATUS VIEW ANAL	YSIS	

100m

200mm

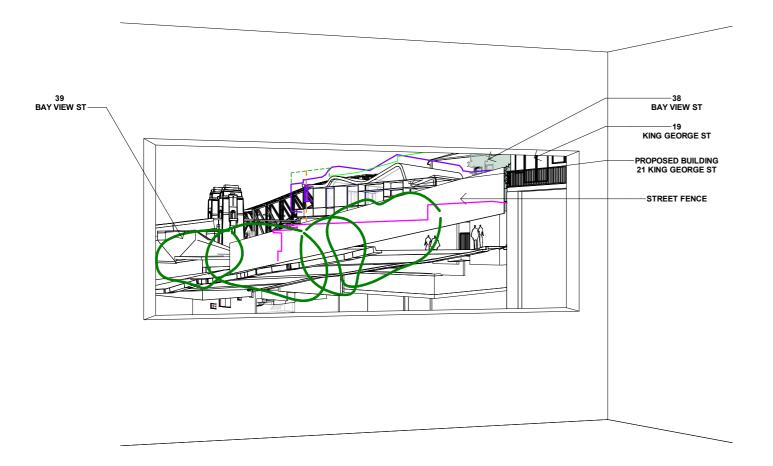

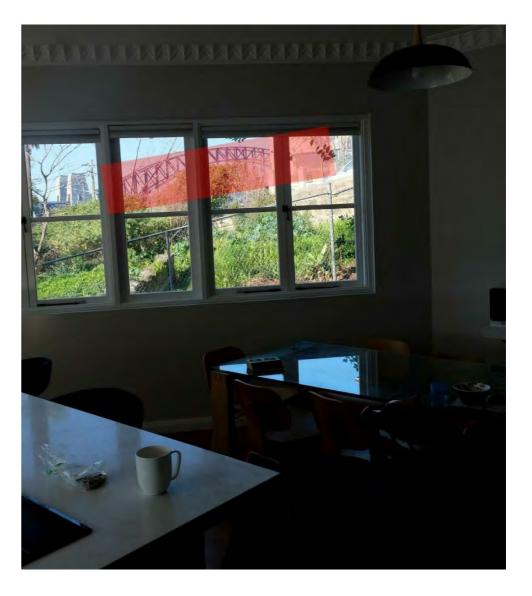


FIG. 7, ATTACHMENT FROM SUBMISSION REFERENCE #: 9LDMKHW - APARTMENT 17

(1) Apt. 17 - View 03


# THROUGH RIGHT-HAND, SE-FACING WINDOW, APARTMENT 17

LOCATED TO MATCH VIEW SEEN IN OBJECTED IMAGE

		EXISTING LARGE TREES THAT IN FOREGROUND ARE NOT SHOWN					
		PRELIMINARY					
Date 10.10.2021 08.12.2021 13.12.2021	Rev E G H	Issue View Analysis View Analysis View Analysis	8.5m HEIGHT CONTROL PLANE        4.1m SETBACK FROM         OUTLINE EXISTING BUILDING       BAY VIEW ST         OUTLINE OPERA HOUSE (WHEN HIDDEN)       OUTLINE NON-COMPLIANT SCHEME		CLIENT MB		PR0 21
computer system	of the Arc	hitect to systems of the Client or other Consultants. The recipient	any errors existing or resulting from data howsoever transferred from the of the data shall be responsible for checking accuracy and completeness a CAD files and their contents are solely representations of the project ABN: 79 124 014 79	P: 02 - 9086 9000 F: 02 - 9086 9001	ARCHITECTURE SAVILLE ISAACS PTY LTD 23a KING GEORGE STREET, MCMAHONS POINT, NSW 2060	saa	PR(

Page 84

<sub>лест</sub> King Geo	orge St		דודנב 21 Waiwera - Apt 17 View 3					
			JOB №. 2024	DRAWING №. <b>09</b>	rev. H			
JECT DATE	ISSUED DATE 13.12.2021	SCALE @ A3:	STATUS VIEW ANAL	YSIS				

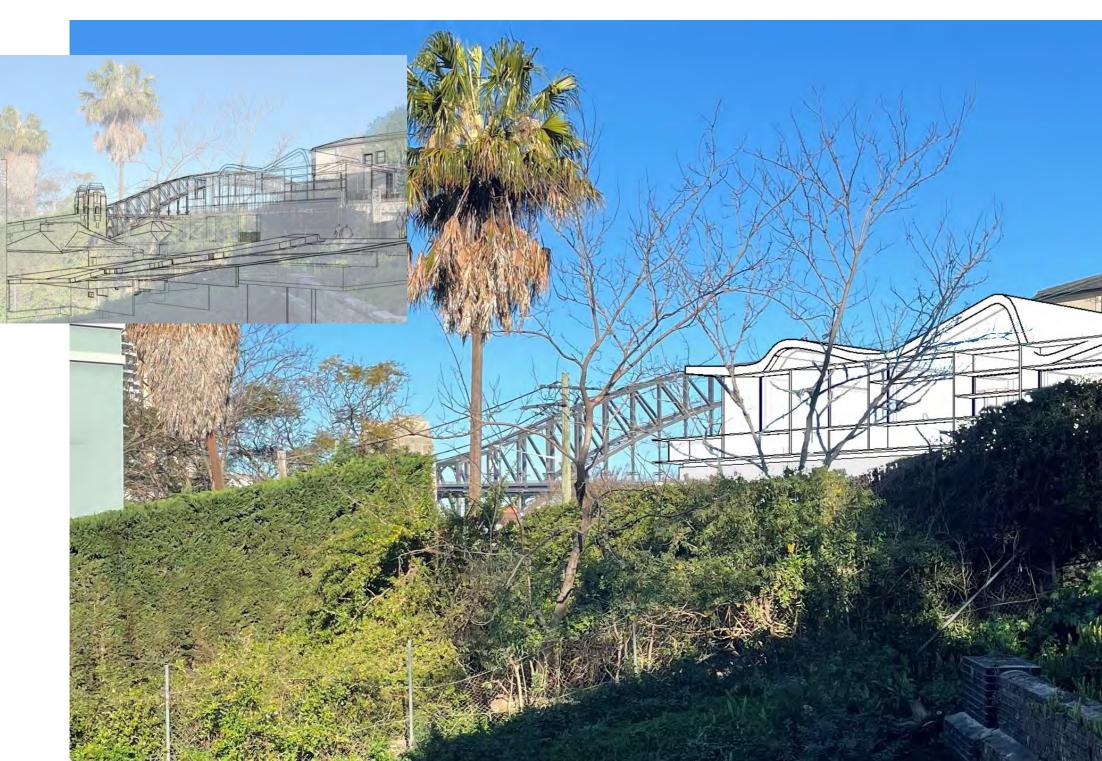

# 21 KING GEORGE ST, PROPOSED BUILDING SUPERIMPOSED ONTO PROVIDED IMAGE FROM COUNCIL SUBMISSION - ATTACHMENT 1115754 - UNIT 17 AT 21 WAIWERA ST

ATTACHMENT TO LPP01 - 2/03/22


		NOTE:	TRACE OVERLAY IN TOP COR	NER	NOTE: INFORMATION OF PROVIDED IN	MAGE REGARDING CAMER	2A		
PRELIMINARY		TO ILLUSTRATE RELATIVE ACCURACY OF AI REVIT MODEL OVER PROVIDED IMAGE.			ANGLE AND TYPE, AND CAMERA POSITION FOR AN APPROPRIATE PROFESSIONAL VIEW ANALYSIS IS NOT PROVIDED.				
Date Re	ev Issue				CLIENT	1	,	PROJ	
10.10.2021 E	View Analysis				MB		1	21	
13.12.2021 H	l View Analysis			1		: <i>I</i>	1 :		
-									
computer system of the	Architect to systems of the Client or other Consultants. The recipient	any errors existing or resulting from data howsoever transferred from the of the data shall be responsible for checking accuracy and completeness cAD files and their contents are solely representations of the project	NSW Nominated Architects: S. ISAACS #7929 ABN: 79 124 014 759		ARCHITECTURE SAVILLE ISAACS PTY LTD 23a KING GEORGE STREET, MOMAHONS POINT, NSW 2060		1.4.4	PRO	


0mm

Page 85

JECT King Geo	orge St		TITLE 21 Waiwera - Apt 17 Overlay					
			<sup>ЈОВ №.</sup> 2024	drawing №. 10	rev. H			
JECT DATE	ISSUED DATE 13.12.2021	SCALE @ A3:	STATUS VIEW ANAL	YSIS				



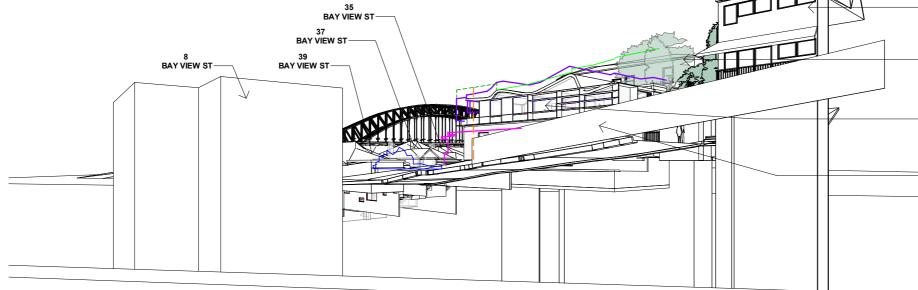

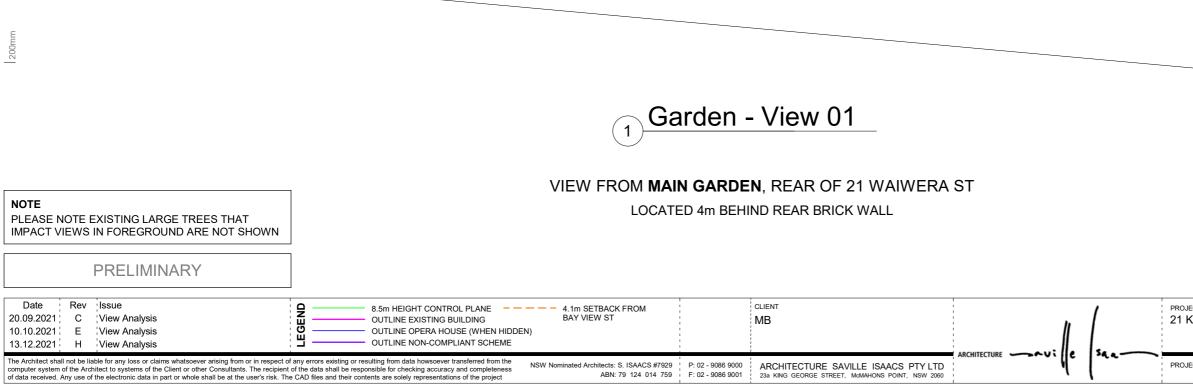


Page 86

19 KING GEORGE ST
 38 BAY VIEW ST
 PROPOSED BUILDING 21 KING GEORGE ST
 STREET FENCE

<sub>лест</sub> King Geo	orge St		TITLE 21 Waiwera - Garden					
			JOB №. 2024	drawing №. 11	rev. H			
JECT DATE	ISSUED DATE 13.12.2021	SCALE @ A3:	STATUS VIEW ANALYSIS					


200mm

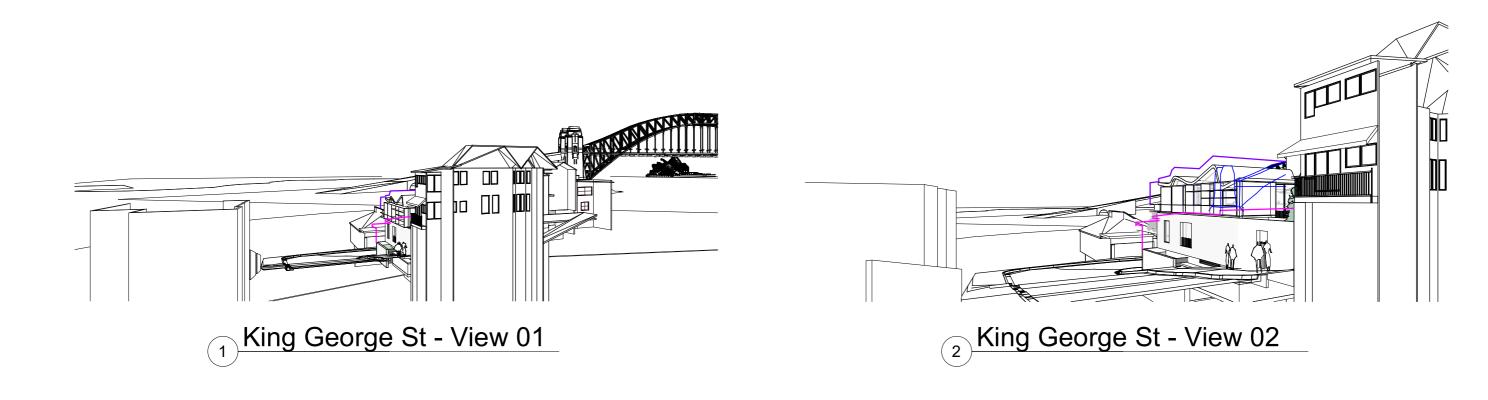




Date Rev Issue 06.09.2021 B View Analysis	8.5m HEIGHT CONTROL PLANE OUTLINE EXISTING BUILDING		client MB	h	1	PROJECT 21 King George St	TITLE Street Views - F	King George	St
20.09.2021         C         View Analysis           10.10.2021         E         View Analysis	OUTLINE HARBOUR BRIDGE (WHEN HIDDEN OUTLINE NON-COMPLIANT SCHEME	۹)			se		JOB №. 1 2024	0RAWING No. 12	<sup>rev.</sup>
The Architect shall not be liable for any loss or claims whatsoever arising from or in respect computer system of the Architect to systems of the Client or other Consultants. The recipie of data received. Any use of the electronic data in part or whole shall be at the user's risk. The computer system of the section o	Int of the data shall be responsible for checking accuracy and completeness	W Nominated Architects: S. ISAACS #7929 ABN: 79 124 014 759	ARCHITECTURE SAVILLE ISAACS PTY LTD			PROJECT DATE ISSUED DA 10.10.202	STATUS VIEW ANALYSIS		

Page 87

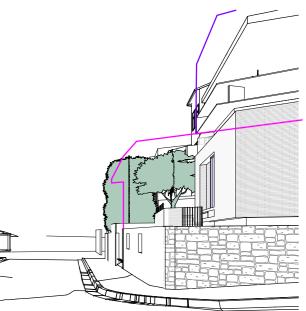



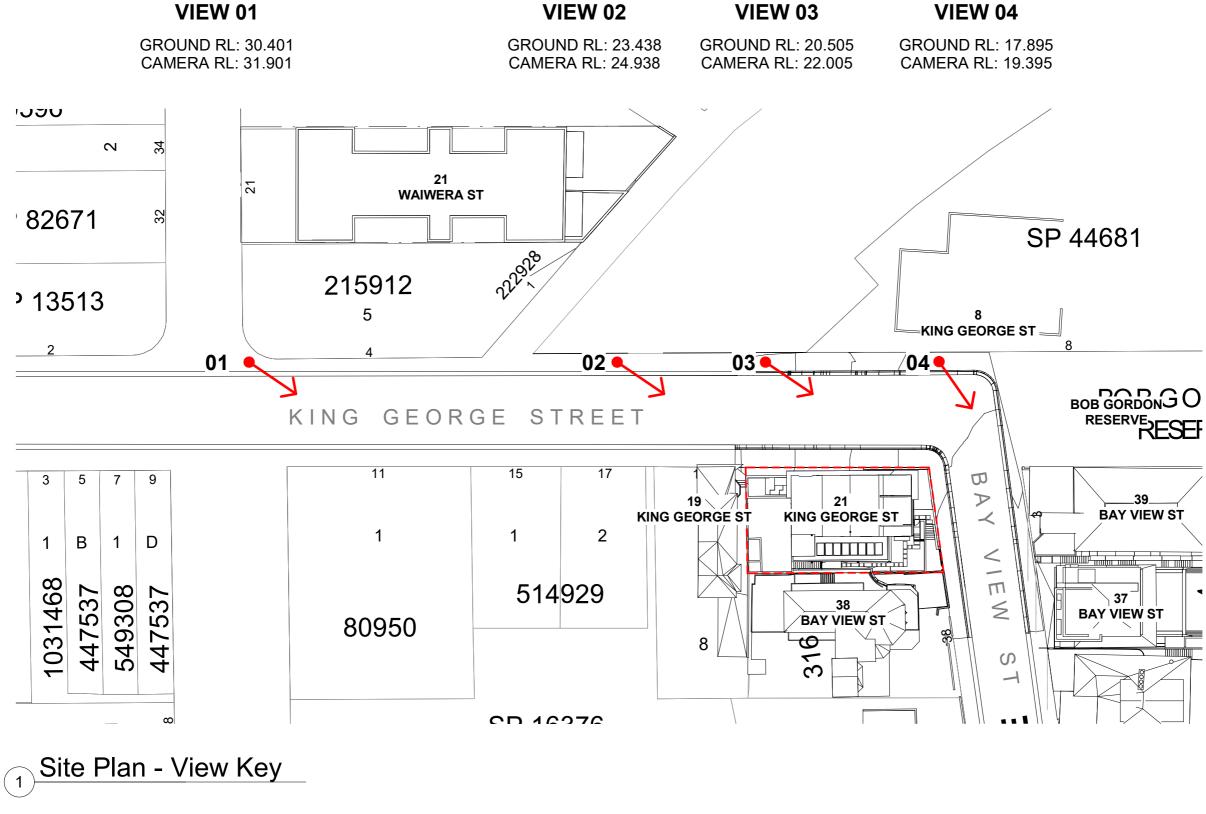

Date     Rev     Issue       20.09.2021     C     View Analysis			CLIENT MB	" (	,	PROJECT 21 King Geor	rge St		TITLE Street View Pla	an Key	
10.10.2021 E View Analysis		1 1 1		.  ,					JOB №. 2024	drawing №. 13	rev. E
The Architect shall not be liable for any loss or claims whatsoever arising from or in respect of any errors existing or resulting from data howsoever transferred from the computer system of the Architect to systems of the Client or other Consultants. The recipient of the data shall be responsible for checking accuracy and completeness of data received. Any use of the electronic data in part or whole shall be at the user's risk. The CAD files and their contents are solely representations of the project	NSW Nominated Architects: S. ISAACS #7929 ABN: 79 124 014 759	P: 02 - 9086 9000 F: 02 - 9086 9001	ARCHITECTURE SAVILLE ISAACS PTY LTD 23a KING GEORGE STREET, MeMAHONS POINT, NSW 2060	9° [	~~~~	1	ISSUED DATE 10.10.2021	SCALE @ A3: 1 : 500	STATUS VIEW ANALYSIS		


PRELIMINARY

300mm

Page 88

100

200n

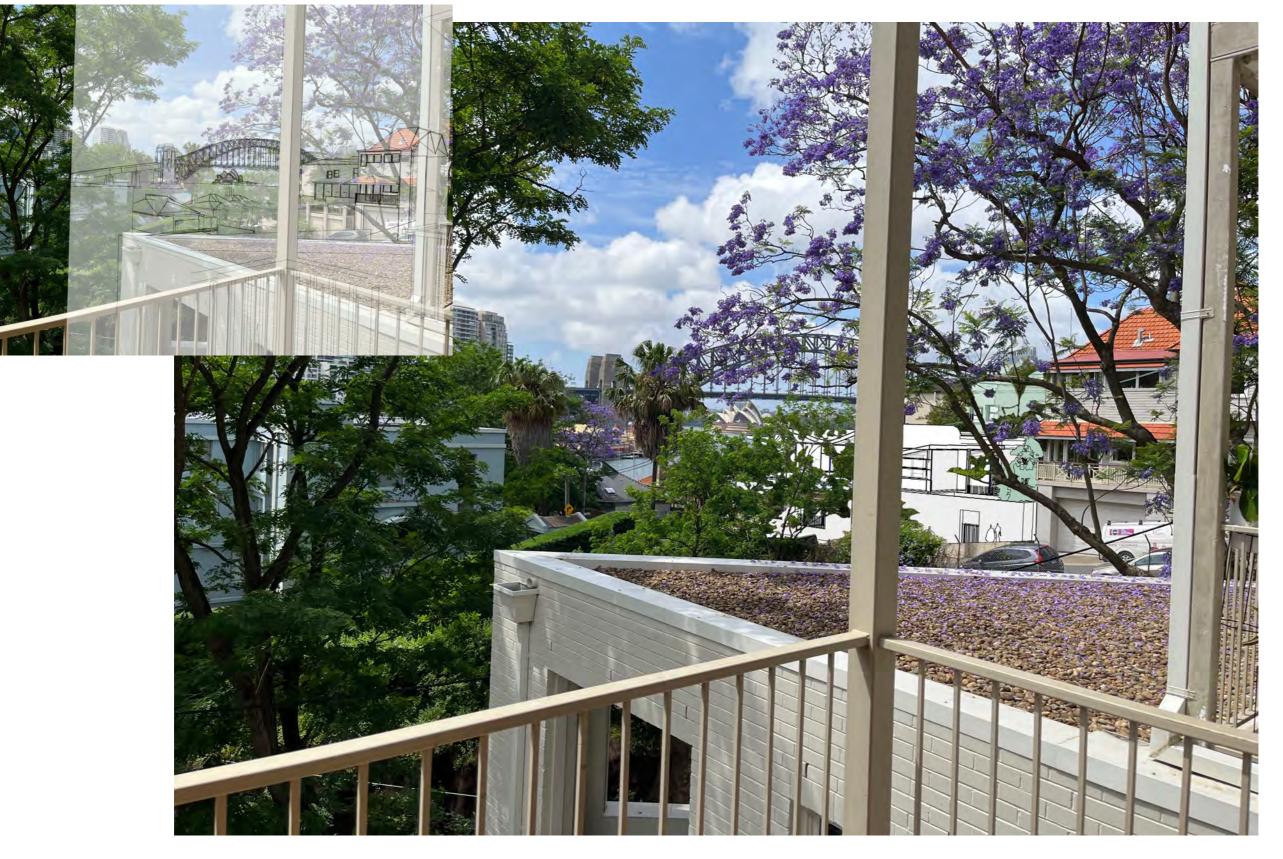

# 21 KING GEORGE ST, PROPOSED BUILDING SUPERIMPOSED ONTO IMAGE PROVIDED BY AK PLANNING - **UNIT 9 AT 21 WAIWERA ST**

PRELIMINARY
-------------

NOTE: TRACE OVERLAY IN TOP CORNER TO ILLUSTRATE RELATIVE ACCURACY OF REVIT MODEL OVER PROVIDED IMAGE. NOTE: INFORMATION OF PROVIDED IMAGE REGARDING CAMERA ANGLE AND TYPE, AND CAMERA POSITION FOR AN APPROPRIATE PROFESSIONAL VIEW ANALYSIS IS NOT PROVIDED.

Date	Rev	Issue			1	CLIENT	1	1	PROJE
11.11.2021	F	View Analysis			1	MB		1	21 Ki
13.12.2021	н	View Analysis	1		1		: //		
						1 1 1 1			
computer system	of the Arc	hitect to systems of the Client or other Consultants. The recipient	of any errors existing or resulting from data howsoever transferred from the t of the data shall be responsible for checking accuracy and completeness the CAD files and their contents are solely representations of the project	NSW Nominated Architects: S. ISAACS #7929 ABN: 79 124 014 759		ARCHITECTURE SAVILLE ISAACS PTY LTD 23a KING GEORGE STREET, MEMAHONS POINT, NSW 2060			PROJEC

<sub>лест</sub> King Geo	orge St		דודנב 21 Waiwera - Apt 09 Overlay				
			JOB №. <b>2024</b>	drawing №. <b>14</b>	rev. H		
JECT DATE	ISSUED DATE 13.12.2021	SCALE @ A3:	STATUS VIEW ANAL	YSIS			

200m



# 21 KING GEORGE ST, PROPOSED BUILDING SUPERIMPOSED ONTO IMAGE PROVIDED BY AK PLANNING - **UNIT 9 AT 21 WAIWERA ST**

PRELIMINARY

NOTE: TRACE OVERLAY IN TOP CORNER TO ILLUSTRATE RELATIVE ACCURACY OF REVIT MODEL OVER PROVIDED IMAGE. NOTE: INFORMATION OF PROVIDED IMAGE REGARDING CAMERA ANGLE AND TYPE, AND CAMERA POSITION FOR AN APPROPRIATE PROFESSIONAL VIEW ANALYSIS IS NOT PROVIDED.


	Date	Rev	Issue			1	CLIENT		1	PROJE
11.	11.2021	F	View Analysis				MB		1	21 K
13.	12.2021	Н	View Analysis			1		: //	1	1
						1			1.	
com	The Architect shall not be liable for any loss or claims whatsoever arising from or in respect of any errors existing or resulting from data howsoever transferred from the computer system of the Architect to systems of the Client or other Consultants. The recipient of the data shall be responsible for checking accuracy and completeness of data received. Any use of the electronic data in part or whole shall be at the user's risk. The CAD files and their contents are solely representations of the project				NSW Nominated Architects: S. ISAACS #7929 ABN: 79 124 014 759	1	ARCHITECTURE SAVILLE ISAACS PTY LTD		34.4	PROJE

Page 90

JECT			TITLE				
King Geo	orge St		21 Waiwera - Apt 09 Overlay				
			JOB No.	DRAWING No.	REV.		
			2024	15	Н		
JECT DATE	ISSUED DATE 13.12.2021	SCALE @ A3:	STATUS VIEW ANAL	YSIS			



### LEGEND

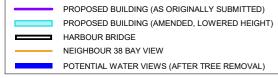

PRELIMINARY


# 21 KING GEORGE ST, PROPOSED BUILDING OUTLINE OVERLAID ONTO IMAGE PROVIDED BY RICHARD LAMB - RLA09249

	Date	Rev	Issue			1	CLIENT		,	PRO
11	.11.2021	F	View Analysis	1 1 1			MB		1	21
	1								1	-
	1		1	1		1			50.	
con	nputer system	of the Arch	itect to systems of the Client or other Consultants. The recipient	f any errors existing or resulting from data howsoever transferred from the of the data shall be responsible for checking accuracy and completeness e CAD files and their contents are solely representations of the project	NSW Nominated Architects: S. ISAACS #7929 ABN: 79 124 014 759	1	ARCHITECTURE SAVILLE ISAACS PTY LTD	4-		PRO

Page 91


JECT King Ge	orge St		TITLE 19 King G	eorge - RLA0924	9
			JOB №. 2024	rev. F	
JECT DATE	ISSUED DATE 11.11.2021	SCALE @ A3: 1 : 100	STATUS VIEW ANAL	YSIS	

100n

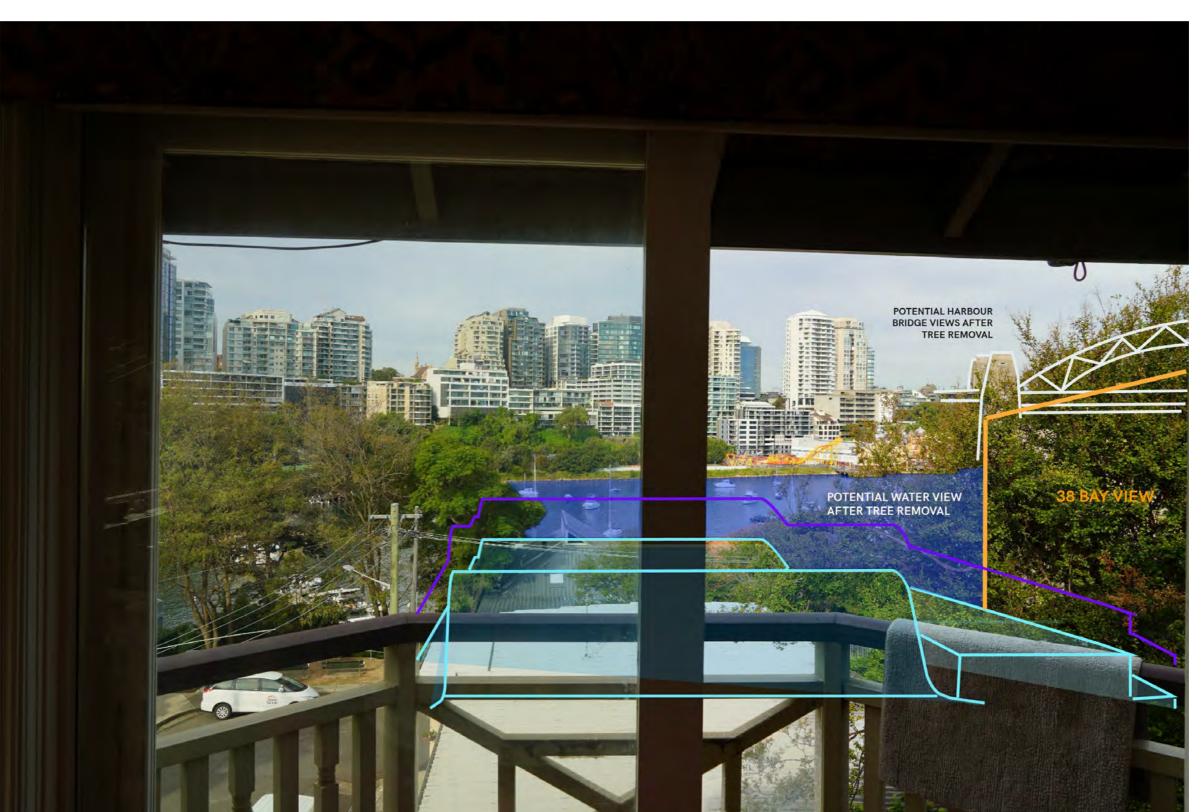

200

LEGEND

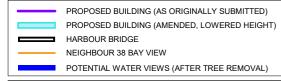

PRELIMINARY


# 21 KING GEORGE ST, PROPOSED BUILDING OUTLINE OVERLAID ONTO IMAGE PROVIDED BY RICHARD LAMB - RLA09255

	ate 1.2021	Rev F	Issue View Analysis			1	CLIENT MB	h	1	рко. 21
									50.	
compu	ter system o	of the Arch	nitect to systems of the Client or other Consultants. The recipien	of any errors existing or resulting from data howsoever transferred from the t of the data shall be responsible for checking accuracy and completeness re CAD files and their contents are solely representations of the project	NSW Nominated Architects: S. ISAACS #7929 ABN: 79 124 014 759	1	ARCHITECTURE SAVILLE ISAACS PTY LTD	1		PRO.

Page 92


JECT King Ge	orge St		¦ ™LE ¦ 19 King G	eorge - RLA0925	5
			јов №. 2024	drawing №. <b>17</b>	rev. F
JECT DATE	ISSUED DATE 11.11.2021	SCALE @ A3: 1 : 100	STATUS	YSIS	

100r

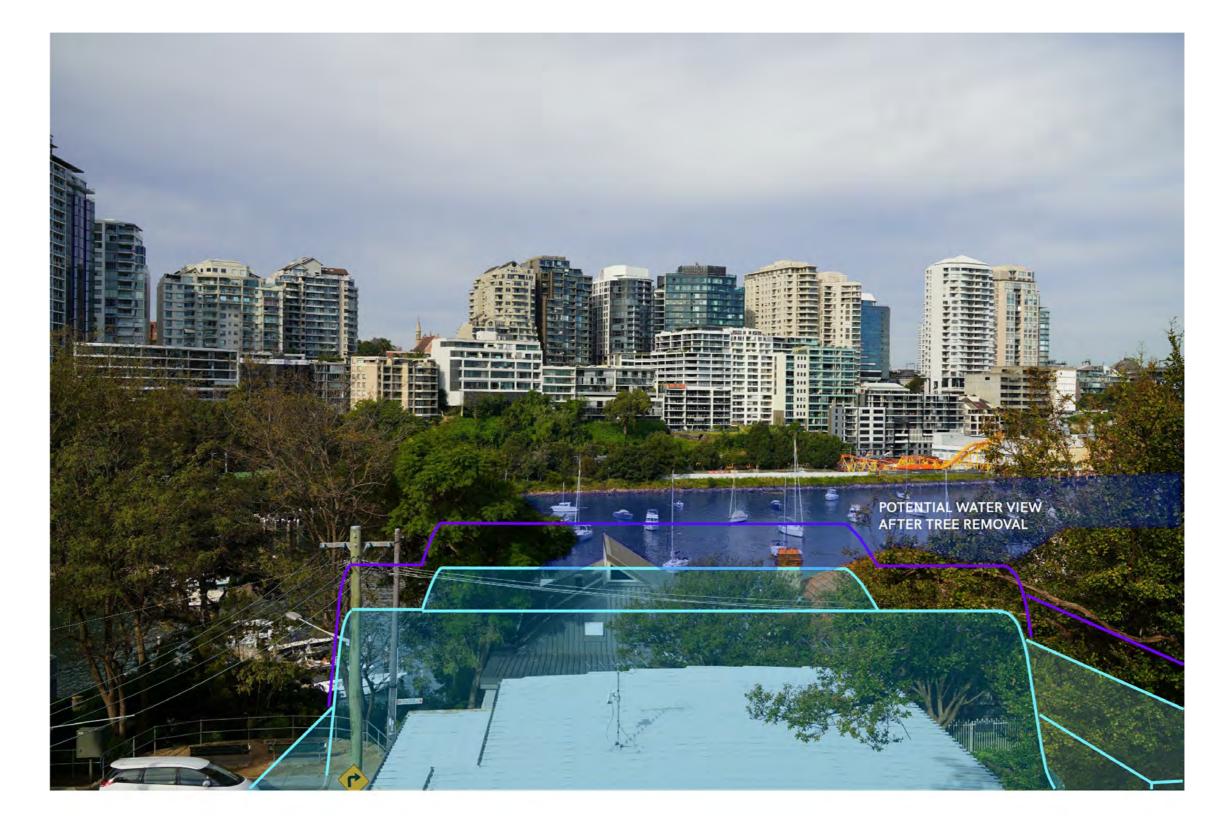

200

LEGEND

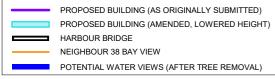

PRELIMINARY


# 21 KING GEORGE ST, PROPOSED BUILDING OUTLINE OVERLAID ONTO IMAGE PROVIDED BY RICHARD LAMB - RLA09256

Date 11.11.2021	Rev F	Issue View Analysis			1	CLIENT MB	h	1	1	PROJE
	1							.	54	
computer system	of the Arc	chitect to systems of the Client or other Consultants. The recipie	t of any errors existing or resulting from data howsoever transferred from the ent of the data shall be responsible for checking accuracy and completeness The CAD files and their contents are solely representations of the project	NSW Nominated Architects: S. ISAACS #7929 ABN: 79 124 014 759		ARCHITECTURE SAVILLE ISAACS PTY LTD	N N			PROJE

JECT King Geo	JECT King George St			eorge - RLA09256 DRAWING No. 18	ð <sup>REV.</sup> F
JECT DATE	ISSUED DATE 11.11.2021	SCALE @ A3: 1 : 100	STATUS VIEW ANAL	YSIS	


Page 93

100r

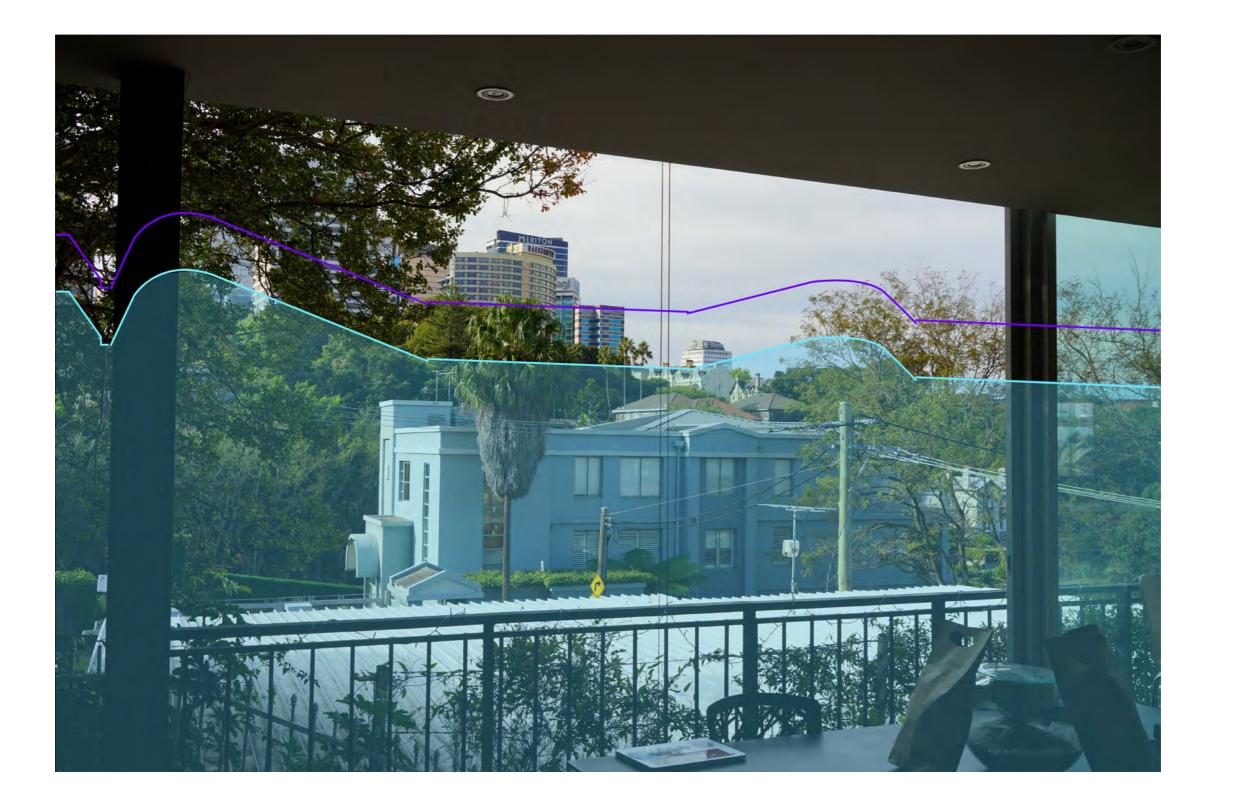

2001

LEGEND

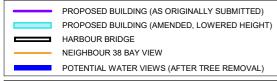

PRELIMINARY


# 21 KING GEORGE ST, PROPOSED BUILDING OUTLINE OVERLAID ONTO IMAGE PROVIDED BY RICHARD LAMB - RLA09258

Date	Re		1			1	CLIENT	1		1	PROJ
11.11.2021	F	View Ana	alysis				MB				21 k
computer system	m of the a	Architect to system	ms of the Client or other Consultants. The recipient of	any errors existing or resulting from data howsoever transferred from the of the data shall be responsible for checking accuracy and completeness CAD files and their contents are solely representations of the project	NSW Nominated Architects: S. ISAACS #7929 ABN: 79 124 014 759		ARCHITECTURE SAVILLE ISAACS PTY LTD		(°	-4.4	PROJ


JECT King Geo	orge St		птье 19 King George - RLA09258				
			јов №. <b>2024</b>	drawing №. <b>19</b>	rev. F		
JECT DATE	ISSUED DATE 11.11.2021	SCALE @ A3: 1 : 100	STATUS VIEW ANAL	LYSIS			


Page 94



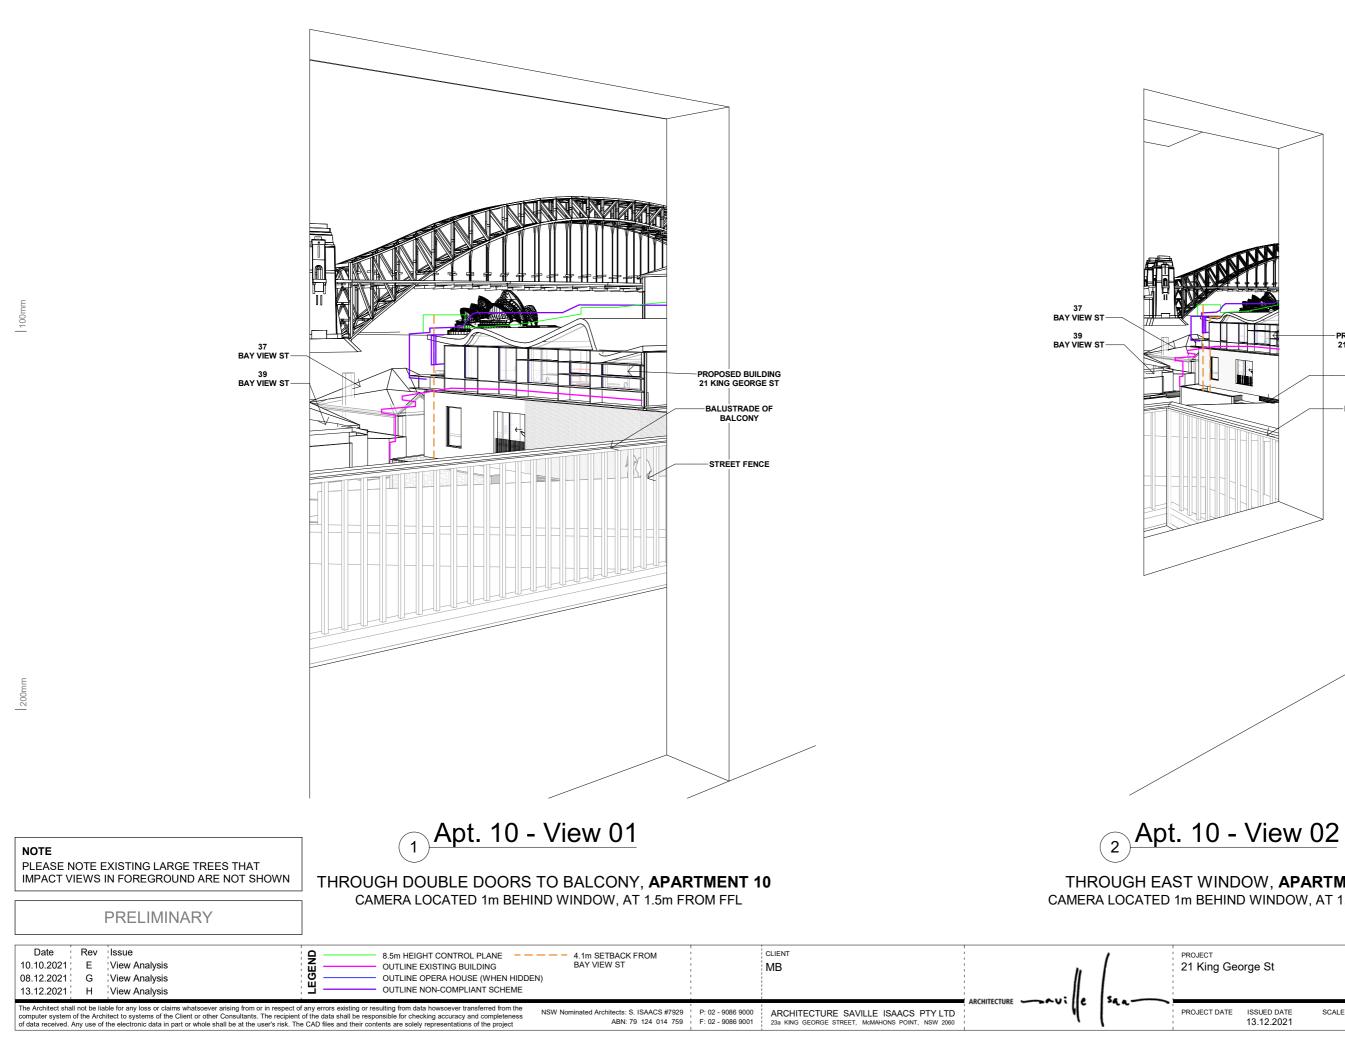

Page 95

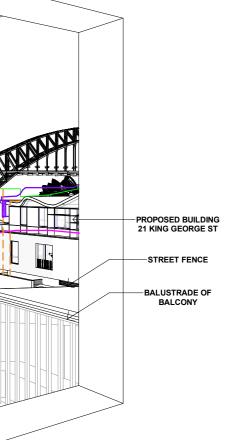


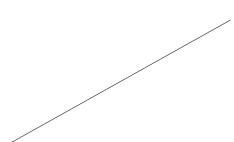


# THROUGH EAST WINDOW, APARTMENT 10

CAMERA LOCATED 1m BEHIND WINDOW, AT 1.5m FROM FFL

<sub>лест</sub> King Geo	orge St		ਸਸ਼⊧ 21 Waiwera - Apt 10 View 1 + 2				
			JOB №. 2024	drawing №. 01	rev. H		
JECT DATE	ISSUED DATE 13.12.2021	SCALE @ A3:	STATUS VIEW ANAL	YSIS			

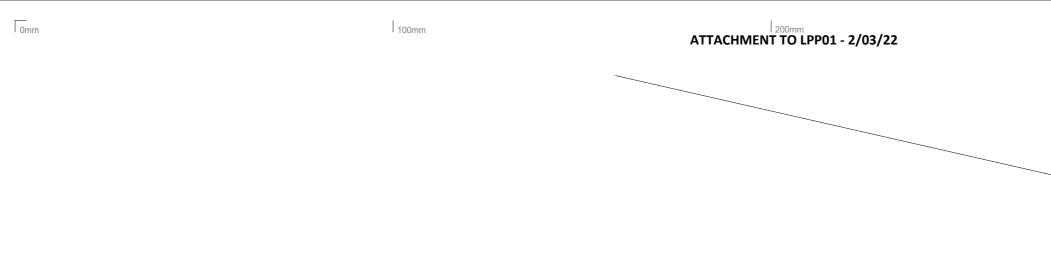

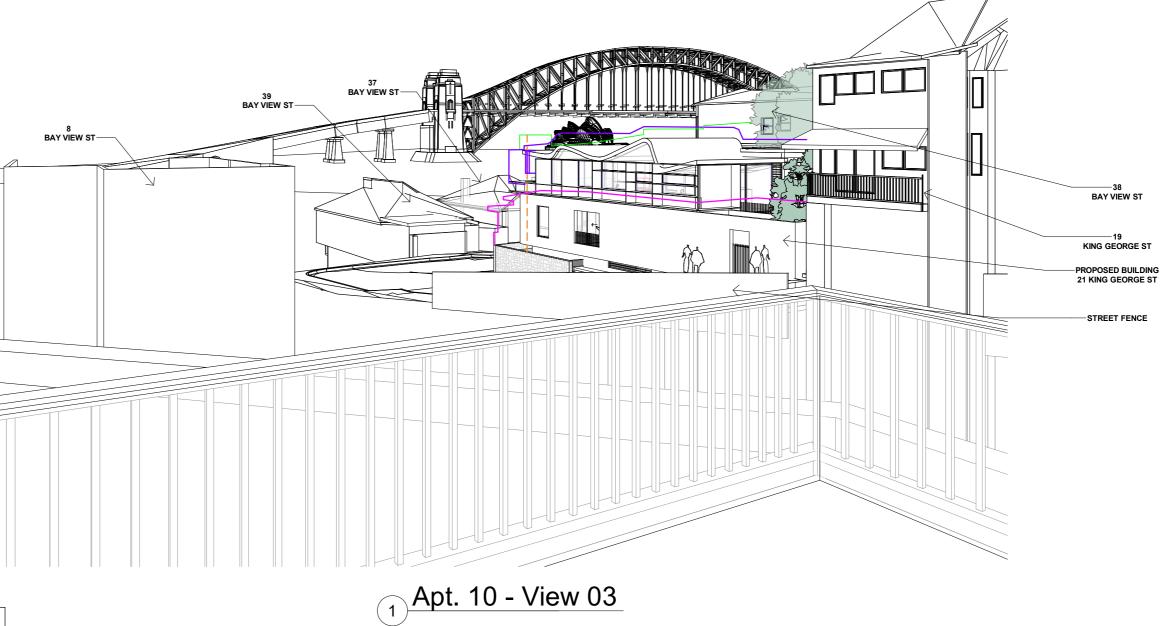

NOTE PLEASE NOTE EXISTING LARGE TREES THAT IMPACT VIEWS IN FOREGROUND ARE NOT SHOWN

PRELIMINARY

ON BALCONY, APARTMENT 10

CAMERA LOCATED 1m BEHIND WINDOW, AT 1.5m FROM FFL

Date Rev Issue 10.10.2021 E View Analysis	8.5m HEIGHT CONTROL PLANE	4.1m SETBACK FROM BAY VIEW ST	CLIENT MB	h	1	PROJECT 21 King George St		זודנב 21 Waiwera - A	pt 10 View 3	3
08.12.2021 G View Analysis 13.12.2021 H View Analysis	OUTLINE OPERA HOUSE (WHEN HIDDE)	N)						job №. 2024	DRAWING No.	rev. H
The Architect shall not be liable for any loss or claims whatsoever arising from or in respect or computer system of the Architect to systems of the Client or other Consultants. The recipient of data received. Any use of the electronic data in part or whole shall be at the user's risk. The	t of the data shall be responsible for checking accuracy and completeness	NSW Nominated Architects: S. ISAACS #7929 ABN: 79 124 014 759	ARCHITECTURE SAVILLE ISAACS PTY LTD 23a KING GEORGE STREET, McMAHONS POINT, NSW 2060			PROJECT DATE ISSUED DATE 13.12.2021	SCALE @ A3:	STATUS VIEW ANALYSIS		


200mm

300mm

Page 96

100r

200r

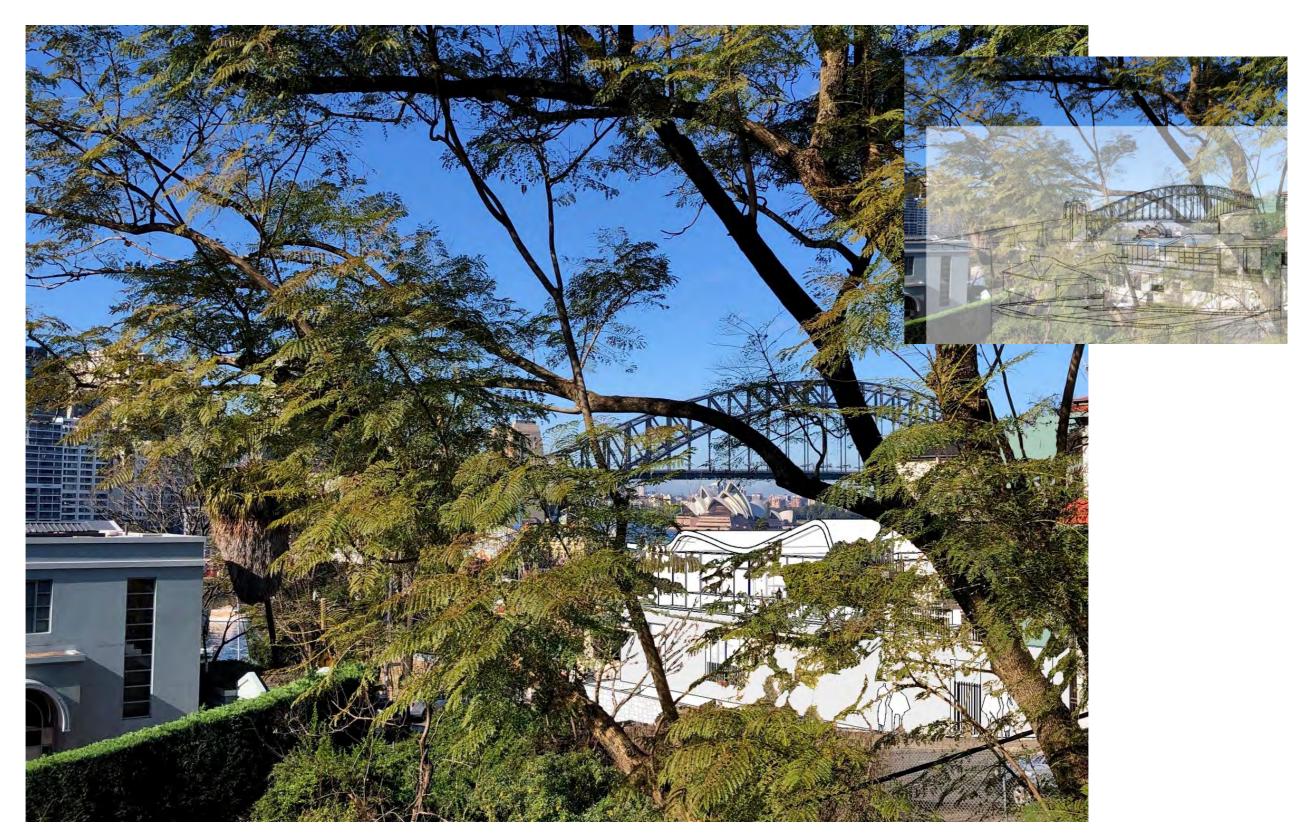

## 21 KING GEORGE ST, PROPOSED BUILDING SUPERIMPOSED ONTO PROVIDED IMAGE FROM COUNCIL SUBMISSION - ATTACHMENT 1112664 - **APARTMENT 10 AT 21 WAIWERA ST**

		PRELIMINARY		NOTE: TRACE OVERLAY IN TO TO ILLUSTRATE RELATIVE AC REVIT MODEL OVER PROVID	CURACY OF	NOTE: INFORMATION OF PROVID ANGLE AND TYPE, AND CAMERA PROFESSIONAL VIEW AN	POSITION FOR AN APPRO	PRIATE	
10.10.2021	E	Issue View Analysis View Analysis				client MB			PRO. 21
computer system	of the Arc	hitect to systems of the Client or other Consultants. The recipient	f any errors existing or resulting from data howsoever transferred from the of the data shall be responsible for checking accuracy and completeness e CAD files and their contents are solely representations of the project	NSW Nominated Architects: S. ISAACS #7929 ABN: 79 124 014 759		ARCHITECTURE SAVILLE ISAACS PTY LTD 23a KING GEORGE STREET, MOMAHONS POINT, NSW 2060		*a a	PRO.

<sub>ест</sub>	דודנב		
King George St	21 Waiwera - Apt 10 Overlay		
	JOB No. DRAWING No. REV. 2024 03 H		
IECT DATE ISSUED DATE SCALE @ A3:	STATUS		
13.12.2021	VIEW ANALYSIS		

100n

NOTE


Date

10.10.2021

08.12.2021

G

View Analysis

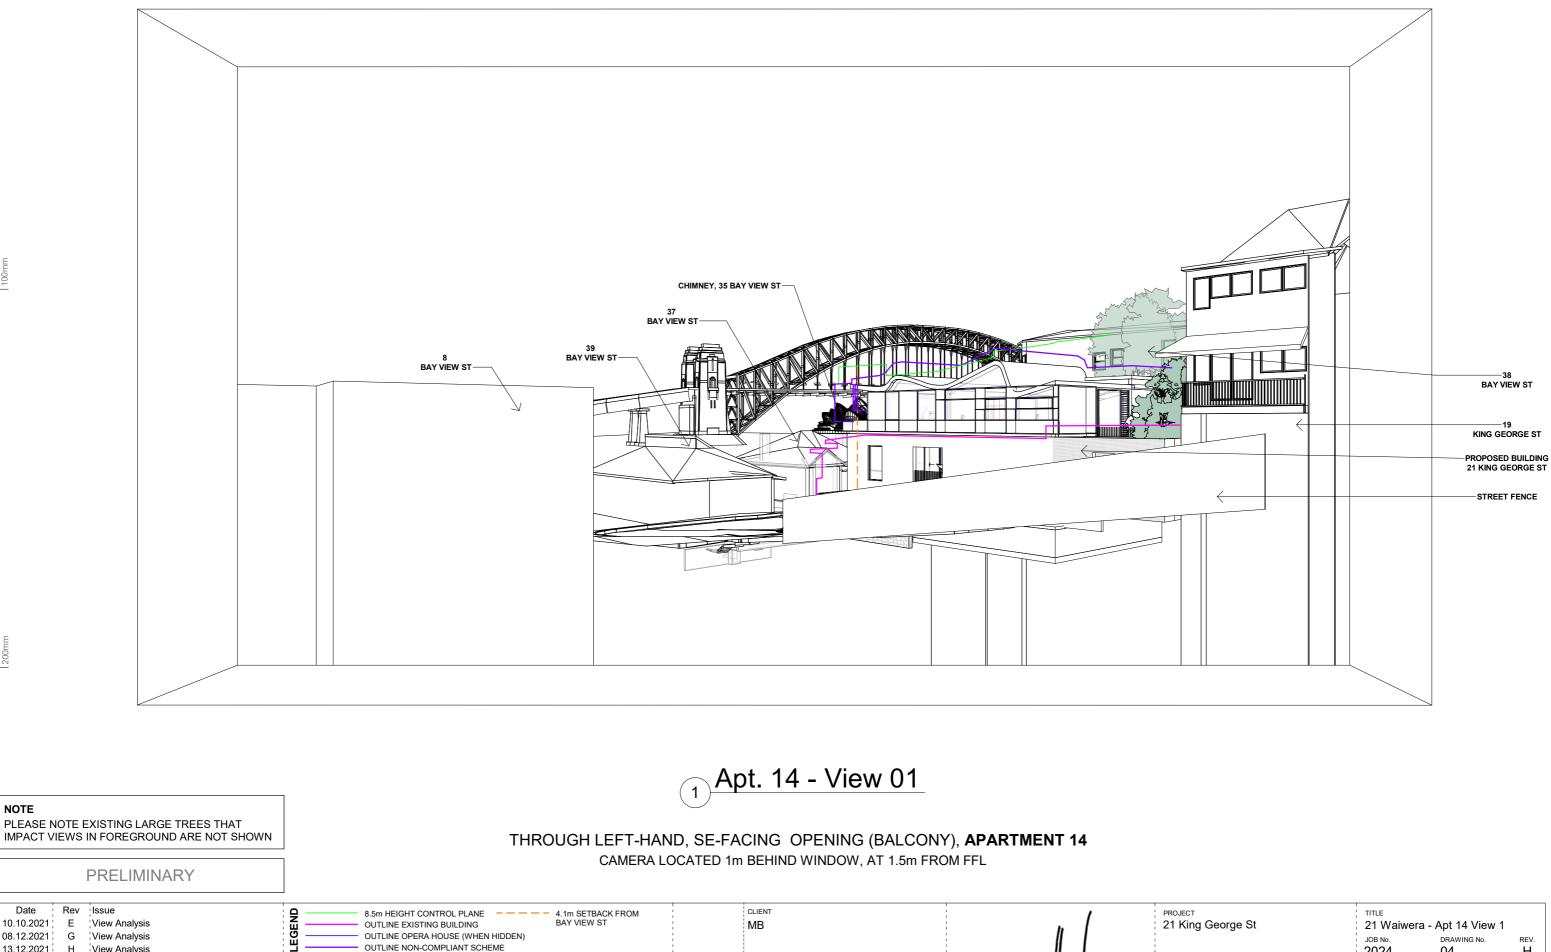


13.12.2021 H <sup>1</sup>View Analysis ARCHITECTURE -~ui e Sa. 1 The Architect shall not be liable for any loss or claims whatsoever arising from or in respect of any errors existing or resulting from data howsoever transferred from the computer system of the Architect to systems of the Client or other Consultants. The recipient of the data shall be responsible for checking accuracy and completeness of data received. Any use of the electronic data in part or whole shall be at the user's risk. The CAD files and their contents are solely representations of the project NSW Nominated Architects: S. ISAACS #7929 P: 02 - 9086 9000 ABN: 79 124 014 759 F: 02 - 9086 9001 ARCHITECTURE SAVILLE ISAACS PTY LTD 23a KING GEORGE STREET, MCMAHONS POINT, NSW 2060

OUTLINE NON-COMPLIANT SCHEME


Page 98

PROJECT 21 King George St			ਸਸ∟ 21 Waiwera - Apt 14 View 1		
			јов №. 2024	DRAWING No.	rev. H
PROJECT DATE	ISSUED DATE 13.12.2021	SCALE @ A3:	STATUS	YSIS	

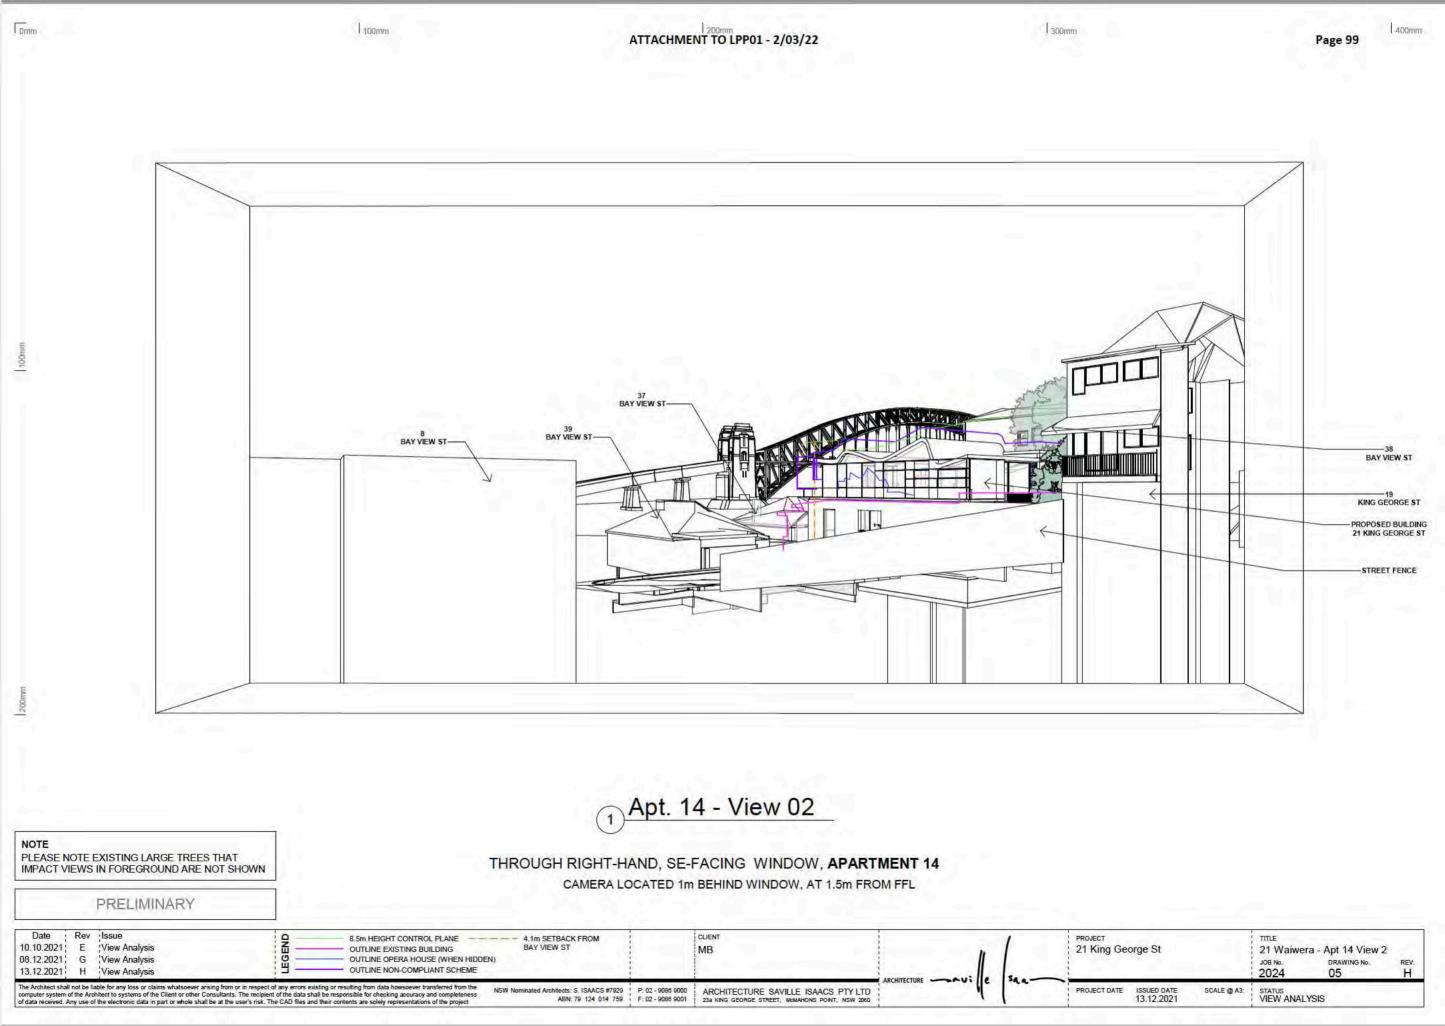

100m

200m

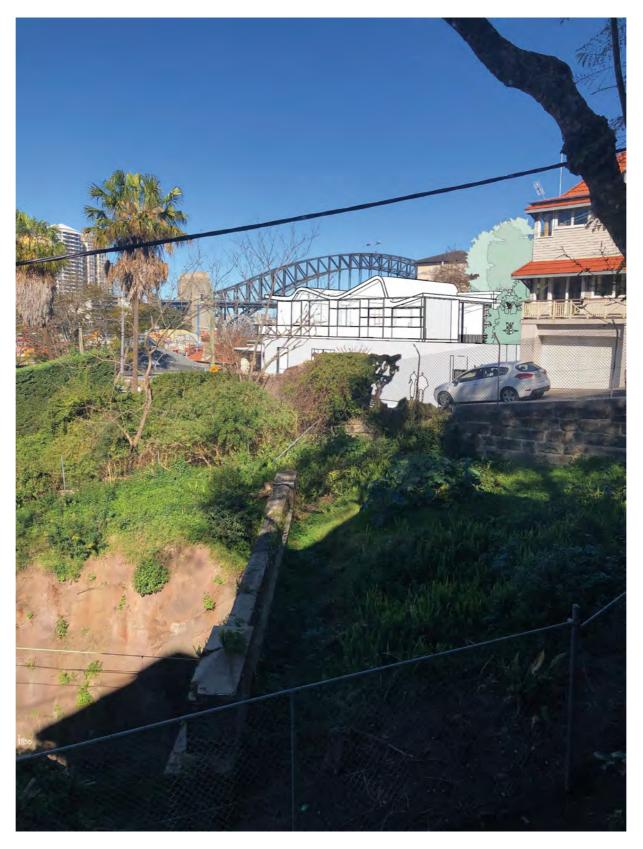



# 21 KING GEORGE ST, PROPOSED BUILDING SUPERIMPOSED ONTO PROVIDED IMAGE FROM COUNCIL SUBMISSION - ATTACHMENT 1115539 - **APARTMENT 14 AT 21 WAIWERA ST**

		PRELIMINARY	]	NOTE: TRACE OVERLAY IN TO TO ILLUSTRATE RELATIVE AC REVIT MODEL OVER PROVID	CURACY OF	NOTE: INFORMATION OF PROVID ANGLE AND TYPE, AND CAMERA PROFESSIONAL VIEW AN	POSITION FOR AN APPRO	PRIATE	
Date 10.10.2021 13.12.2021	Rev E H	Issue View Analysis View Analysis				client MB	l	[	PROJE 21 k
					1			50.	
computer system of	the Arc	hitect to systems of the Client or other Consultants. The recipient	of any errors existing or resulting from data howsoever transferred from the tof the data shall be responsible for checking accuracy and completeness the CAD files and their contents are solely representations of the project	NSW Nominated Architects: S. ISAACS #7929 ABN: 79 124 014 759	P: 02 - 9086 9000 F: 02 - 9086 9001	ARCHITECTURE SAVILLE ISAACS PTY LTD 23a KING GEORGE STREET, MOMAHONS POINT, NSW 2060			PROJE



JECT King George St			ਸਸ∟⊑ 21 Waiwera - Apt 14 Overlay		
			JOB No. DRAWING No. 2024 06		
JECT DATE	ISSUED DATE 13.12.2021	SCALE @ A3:	STATUS VIEW ANAI	LYSIS	

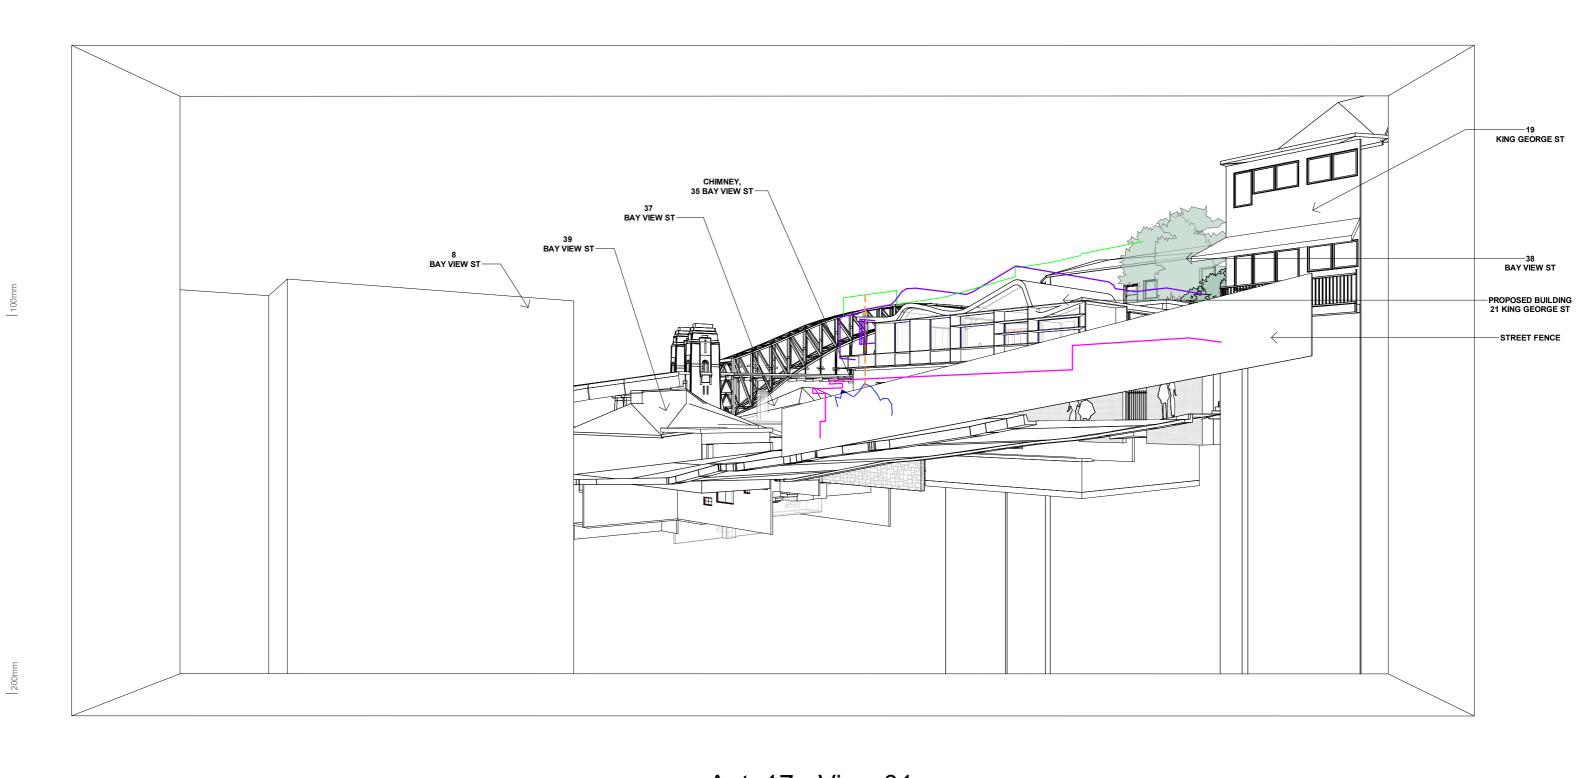


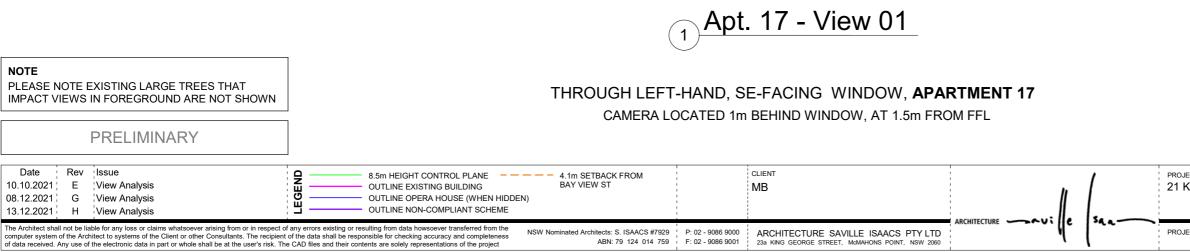


Page 101

JECT King George St			ਸਸ∟ 21 Waiwera - Apt 17 View 1		
			JOB No. DRAWING No. 2024 07		
JECT DATE	ISSUED DATE 13.12.2021	SCALE @ A3:	STATUS VIEW ANAL	YSIS	

ATTACHMENT TO LPP01 - 2/03/22

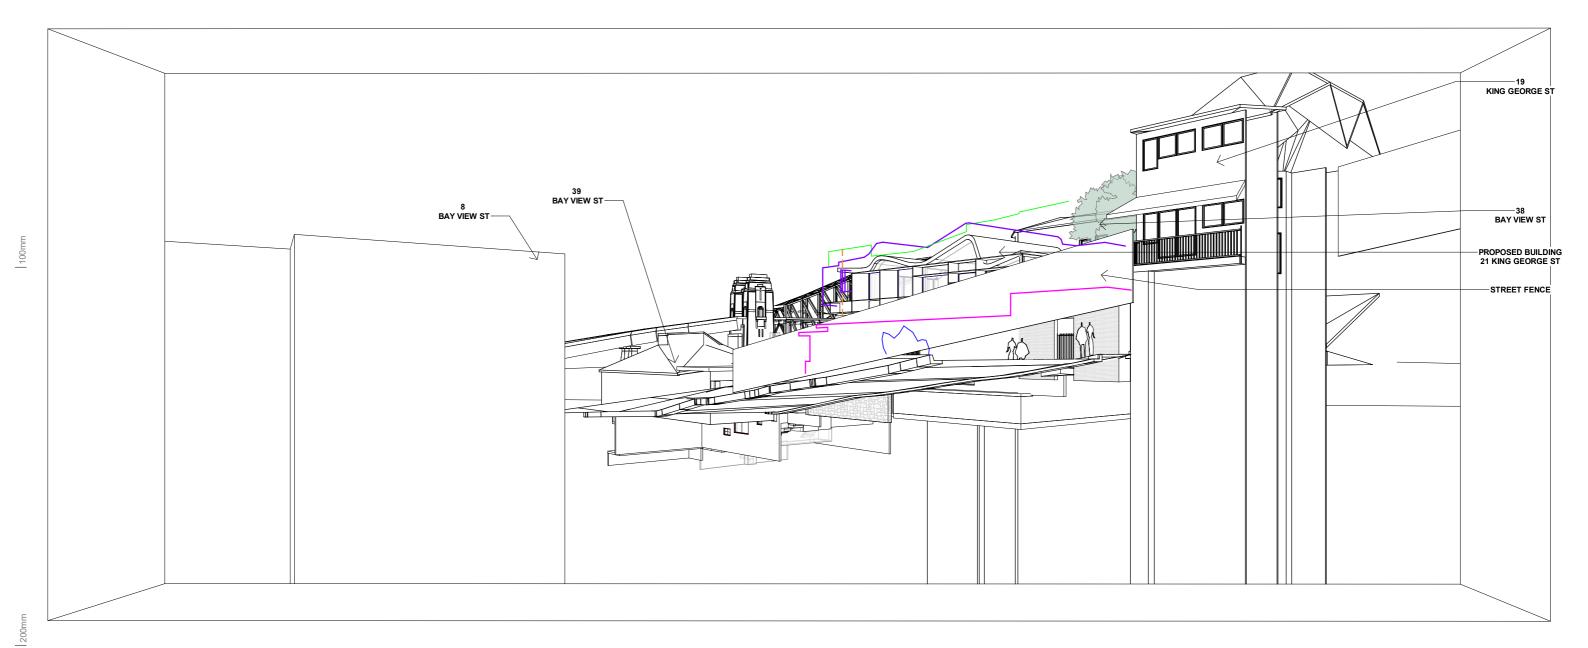

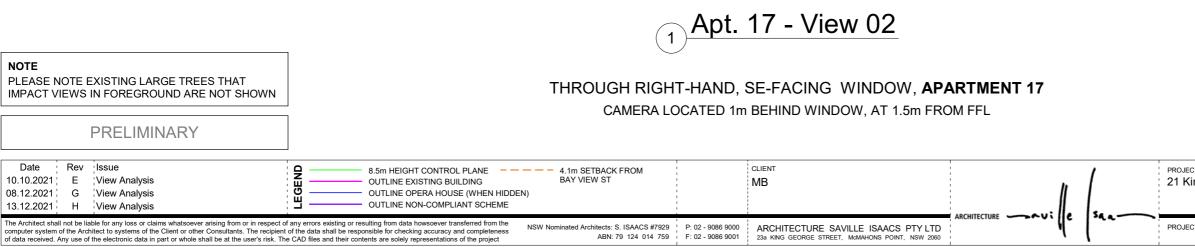


100mm

Page 102

JECT King George St			ਸਸ∟E 21 Waiwera - Apt 17 View 2			
			JOB №. <b>2024</b>	DRAWING №. <b>08</b>	rev. H	
JECT DATE	ISSUED DATE 13.12.2021	SCALE @ A3:	STATUS VIEW ANAL	YSIS		

100m

200mm

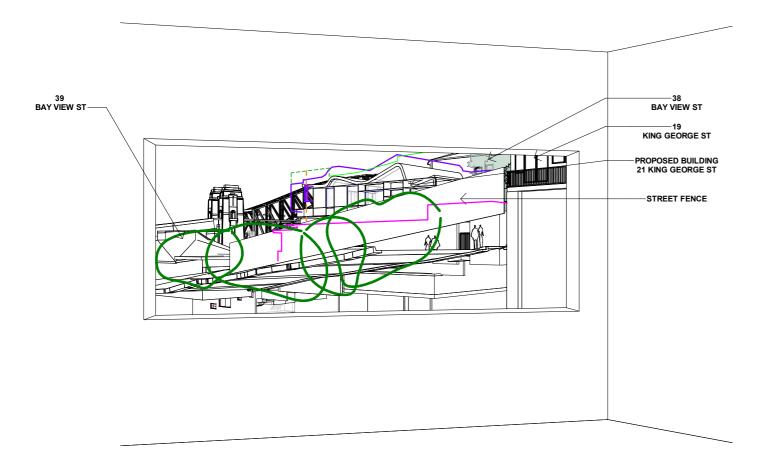

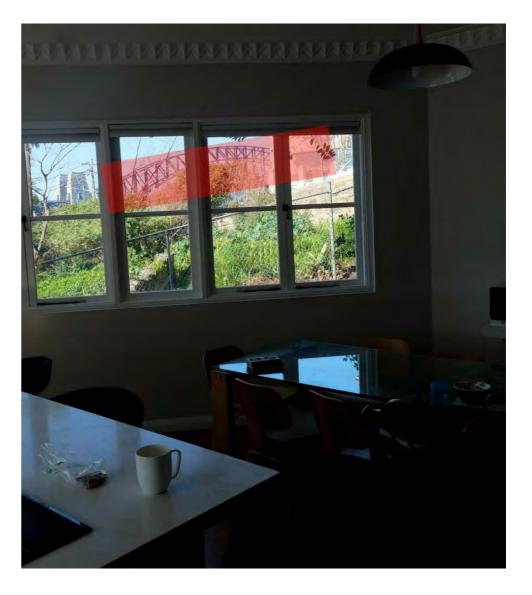


FIG. 7, ATTACHMENT FROM SUBMISSION REFERENCE #: 9LDMKHW - APARTMENT 17

(1) Apt. 17 - View 03


# THROUGH RIGHT-HAND, SE-FACING WINDOW, APARTMENT 17

LOCATED TO MATCH VIEW SEEN IN OBJECTED IMAGE

NOTE PLEASE NOTE EXISTING LARGE TREES THAT IMPACT VIEWS IN FOREGROUND ARE NOT SHOWN					
PRELIMINARY					
DateRevIssue10.10.2021EView Analysis08.12.2021GView Analysis13.12.2021HView Analysis	8.5m HEIGHT CONTROL PLANE        4.1m SETBACK FROM         OUTLINE EXISTING BUILDING       BAY VIEW ST         OUTLINE OPERA HOUSE (WHEN HIDDEN)       OUTLINE NON-COMPLIANT SCHEME	1	CLIENT MB		PR 21
The Architect shall not be liable for any loss or claims whatsoever arising from or in respect computer system of the Architect to systems of the Client or other Consultants. The recipier of data received. Any use of the electronic data in part or whole shall be at the user's risk. T	t of the data shall be responsible for checking accuracy and completeness		ARCHITECTURE SAVILLE ISAACS PTY LTD 23a KING GEORGE STREET, MGMAHONS POINT, NSW 2060	<sup>3</sup> a a	PR

Page 103

IECT TITLE King George St 21 Waiwera - Apt 17 View 3 JOB NO. DRAWING NO. REV 2024 09 H						
<u>2024 09 H</u>	I			1		
13.12.2021 VIEW ANALYSIS	JECT DATE	ISSUED DATE 13.12.2021	SCALE @ A3:	STATUS VIEW ANAL	YSIS	

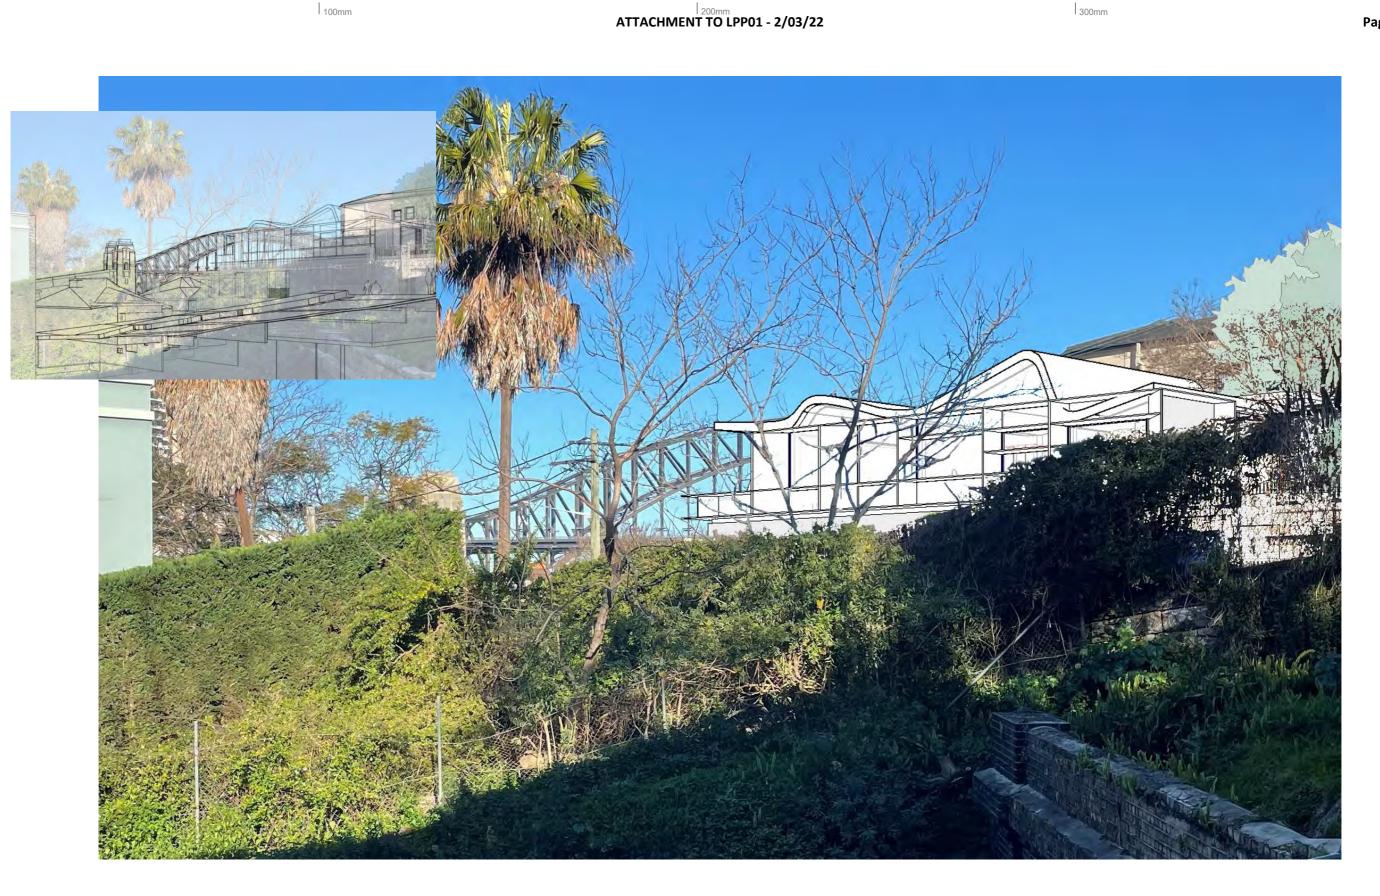

# 21 KING GEORGE ST, PROPOSED BUILDING SUPERIMPOSED ONTO PROVIDED IMAGE FROM COUNCIL SUBMISSION - ATTACHMENT 1115754 - UNIT 17 AT 21 WAIWERA ST

		NOTE:	TRACE OVERLAY IN TOP COR	NER	NOTE: INFORMATION OF PROVIDED IN	MAGE REGARDING CAMER	2A	
	PRELIMINARY		JSTRATE RELATIVE ACCURAC MODEL OVER PROVIDED IMA		ANGLE AND TYPE, AND CAMERA POSI PROFESSIONAL VIEW ANALYS		TE	
Date Re	ev Issue				CLIENT	1	,	PROJ
10.10.2021 E	View Analysis				MB		1	21
13.12.2021 H	l View Analysis			1		: <i>I</i>	1 :	
-								
computer system of the	Architect to systems of the Client or other Consultants. The recipient	any errors existing or resulting from data howsoever transferred from the of the data shall be responsible for checking accuracy and completeness cAD files and their contents are solely representations of the project	NSW Nominated Architects: S. ISAACS #7929 ABN: 79 124 014 759		ARCHITECTURE SAVILLE ISAACS PTY LTD 23a KING GEORGE STREET, MOMAHONS POINT, NSW 2060		1.4.4	PRO


0mm


100mm

Page 104

JECT King George St			דודנב 21 Waiwera - Apt 17 Overlay			
			JOB No. DRAWING No. 2024 10			
JECT DATE	ISSUED DATE 13.12.2021	SCALE @ A3:	STATUS	YSIS		



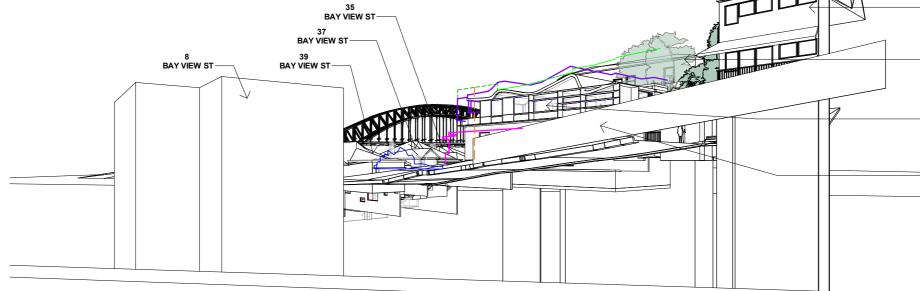

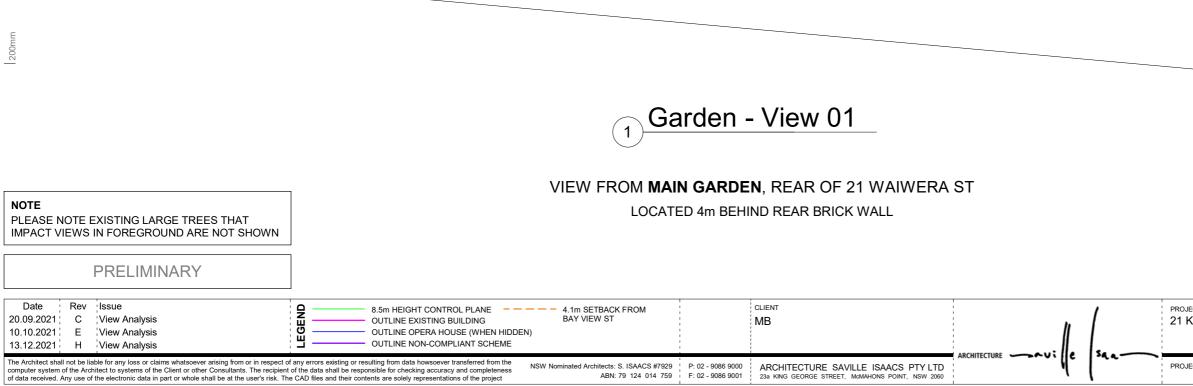


Page 105

19
KING GEORGE ST
BAY VIEW ST
PROPOSED BUILDING 21 KING GEORGE ST
 STREET FENCE

JECT King George St			тттье 21 Waiwera - Garden			
			JOB №. 2024	drawing №. <b>11</b>	rev. H	
JECT DATE	ISSUED DATE 13.12.2021	SCALE @ A3:	STATUS VIEW ANAL	YSIS		
			-			


200mm

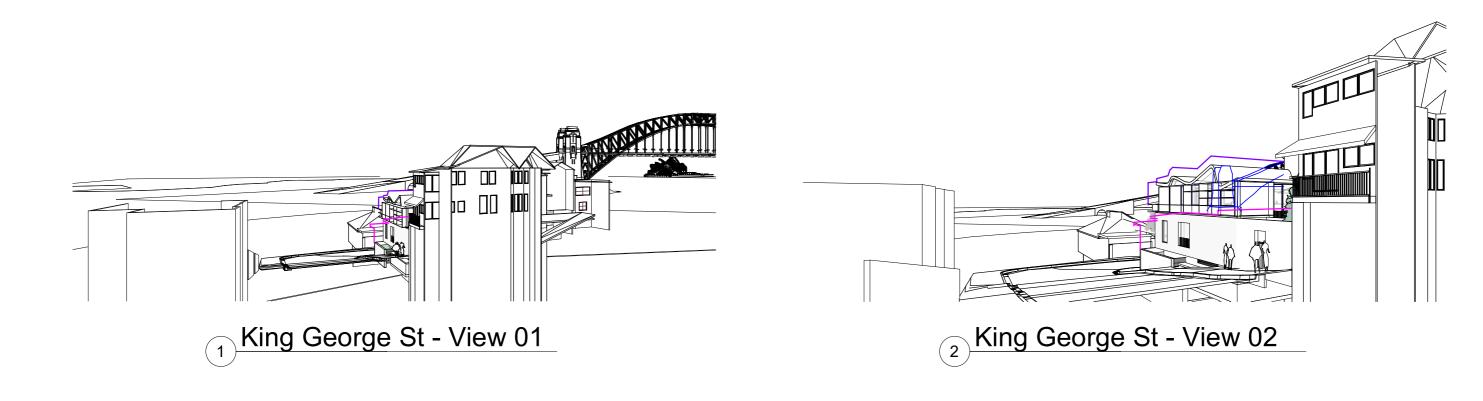




Date Rev Issue 06.09.2021 B View Analysis	8.5m HEIGHT CONTROL PLANE OUTLINE EXISTING BUILDING		client MB	h	1	PROJECT 21 King Geo	rge St	TITLE Street Views	- King Georg	je St
20.09.2021         C         View Analysis           10.10.2021         E         View Analysis	OUTLINE HARBOUR BRIDGE (WHEN HID OUTLINE NON-COMPLIANT SCHEME	DEN)			Se			JOB No. 2024	drawing №. 12	rev. E
The Architect shall not be liable for any loss or claims whatsoever arising from or in respect computer system of the Architect to systems of the Client or other Consultants. The recipier of data received. Any use of the electronic data in part or whole shall be at the user's risk. T	nt of the data shall be responsible for checking accuracy and completeness	NSW Nominated Architects: S. ISAACS #7929 ABN: 79 124 014 759	ARCHITECTURE SAVILLE ISAACS PTY LTD	4		PROJECT DATE	ISSUED DATE SCAL 10.10.2021	E@A3: STATUS VIEW ANALYS	IS	

Page 106

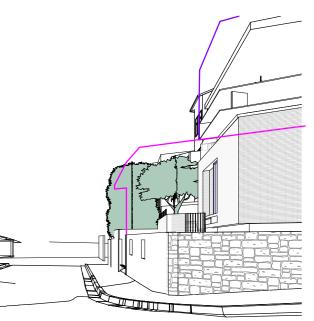



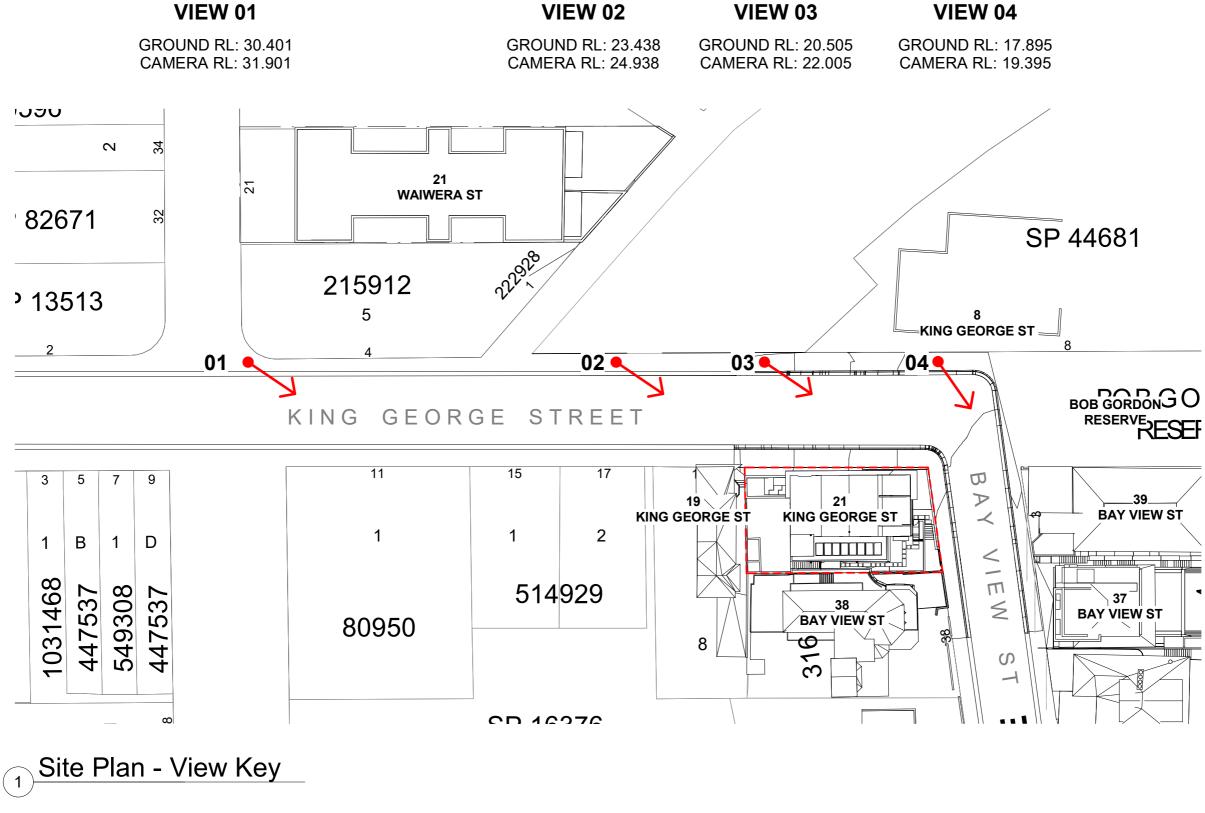


Date Rev Issue 20.09.2021 C View Analysis		1	CLIENT	1		1	PROJECT	TITLE Street View F	Dan Key	
10.10.2021 E View Analysis					_	•.	21 King George of	JOB No. 2024	DRAWING No.	REV.
The Architect shall not be liable for any loss or claims whatsoever arising from or in respect of any errors existing or resulting from data howsoever transferred from the computer system of the Architect to systems of the Client or other Consultants. The recipient of the data shall be responsible for checking accuracy and completeness of data received. Any use of the electronic data in part or whole shall be at the user's risk. The CAD files and their contents are solely representations of the project	NSW Nominated Architects: S. ISAACS #7929 ABN: 79 124 014 759	P: 02 - 9086 9000 F: 02 - 9086 9001	ARCHITECTURE SAVILLE ISAACS PTY LTD 23a KING GEORGE STREET, MoMAHONS POINT, NSW 2060		4°	34 a	PROJECT DATE ISSUED D 10.10.2	STATUS VIEW ANALYS	S	

PRELIMINARY

Page 107

100

200n

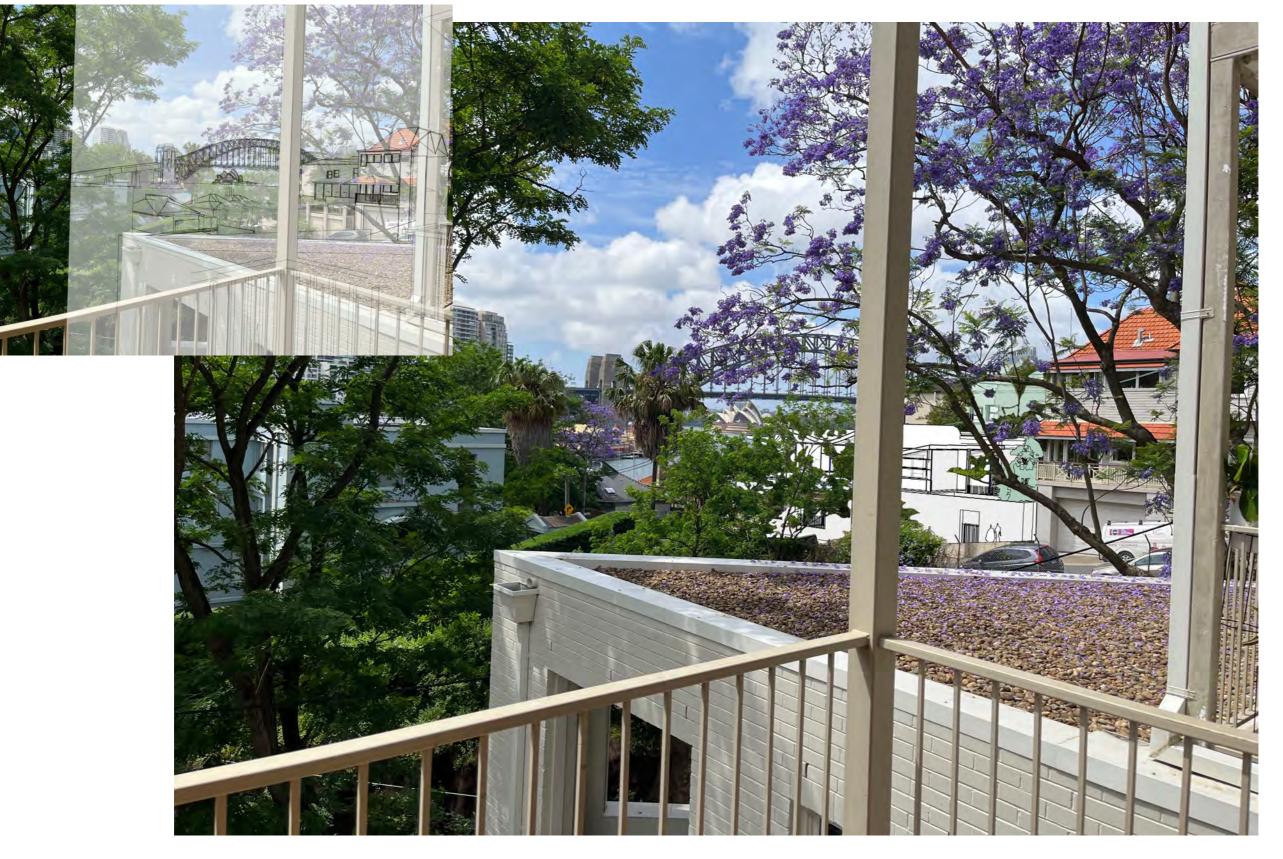

# 21 KING GEORGE ST, PROPOSED BUILDING SUPERIMPOSED ONTO IMAGE PROVIDED BY AK PLANNING - **UNIT 9 AT 21 WAIWERA ST**

PRELIMINARY
-------------

NOTE: TRACE OVERLAY IN TOP CORNER TO ILLUSTRATE RELATIVE ACCURACY OF REVIT MODEL OVER PROVIDED IMAGE. NOTE: INFORMATION OF PROVIDED IMAGE REGARDING CAMERA ANGLE AND TYPE, AND CAMERA POSITION FOR AN APPROPRIATE PROFESSIONAL VIEW ANALYSIS IS NOT PROVIDED.

Date	Rev	Issue			1	CLIENT	1	1	PROJE
11.11.2021	F	View Analysis			1	MB		1	21 Ki
13.12.2021	н	View Analysis	1		1		: //		
						1 1 1 1			
computer system	of the Arc	hitect to systems of the Client or other Consultants. The recipient	of any errors existing or resulting from data howsoever transferred from the t of the data shall be responsible for checking accuracy and completeness the CAD files and their contents are solely representations of the project	NSW Nominated Architects: S. ISAACS #7929 ABN: 79 124 014 759		ARCHITECTURE SAVILLE ISAACS PTY LTD 23a KING GEORGE STREET, MEMAHONS POINT, NSW 2060			PROJEC

JECT King Georg	e St	1	דודנב 21 Waiwera - Apt 09 Overlay				
		1	JOB №. 2024	DRAWING No.	rev. H		
	SUED DATE 5.12.2021	SCALE @ A3:	STATUS VIEW ANALYSIS	3			

Page 108

200m



# 21 KING GEORGE ST, PROPOSED BUILDING SUPERIMPOSED ONTO IMAGE PROVIDED BY AK PLANNING - **UNIT 9 AT 21 WAIWERA ST**

PRELIMINARY

NOTE: TRACE OVERLAY IN TOP CORNER TO ILLUSTRATE RELATIVE ACCURACY OF REVIT MODEL OVER PROVIDED IMAGE. NOTE: INFORMATION OF PROVIDED IMAGE REGARDING CAMERA ANGLE AND TYPE, AND CAMERA POSITION FOR AN APPROPRIATE PROFESSIONAL VIEW ANALYSIS IS NOT PROVIDED.

	Date	Rev	Issue			1	CLIENT	1	,	PROJEC
	11.11.2021	F	View Analysis	1 1		1	MB		1	21 Ki
	13.12.2021	¦Н	View Analysis	1		1		: <b>//</b>	1	1
		1 1 1								
l	computer system	of the Arc	chitect to systems of the Client or other Consultants. The recipient	f of any errors existing or resulting from data howsoever transferred from the of the data shall be responsible for checking accuracy and completeness e CAD files and their contents are solely representations of the project	NSW Nominated Architects: S. ISAACS #7929 ABN: 79 124 014 759	1	1		saa	PROJEC

Page 109

JECT King George St	™LE 21 Waiwe	ra - Apt 09 Overla	y
	JOB №. 2024	drawing №. 15	rev. H
JECT DATE ISSUED DATE SCALE @ 13.12.2021	A3: STATUS VIEW ANAL	YSIS	



### LEGEND




PRELIMINARY

# 21 KING GEORGE ST, PROPOSED BUILDING OUTLINE OVERLAID ONTO IMAGE PROVIDED BY RICHARD LAMB - RLA09249

	Date	Rev	Issue			1	CLIENT		,	PRO
11	.11.2021	F	View Analysis	1 1 1			MB		1	21
	1								1	-
	1		1	1		1			50.	
con	nputer system	of the Arch	itect to systems of the Client or other Consultants. The recipient	f any errors existing or resulting from data howsoever transferred from the of the data shall be responsible for checking accuracy and completeness e CAD files and their contents are solely representations of the project	NSW Nominated Architects: S. ISAACS #7929 ABN: 79 124 014 759	1	ARCHITECTURE SAVILLE ISAACS PTY LTD	4-		PRO

Page 110

JECT King Ge	orge St		титье 19 King George - RLA09249				
			јов №. <b>2024</b>	drawing №. <b>16</b>	REV.		
JECT DATE	ISSUED DATE 11.11.2021	SCALE @ A3: 1 : 100	STATUS VIEW ANAL	YSIS			

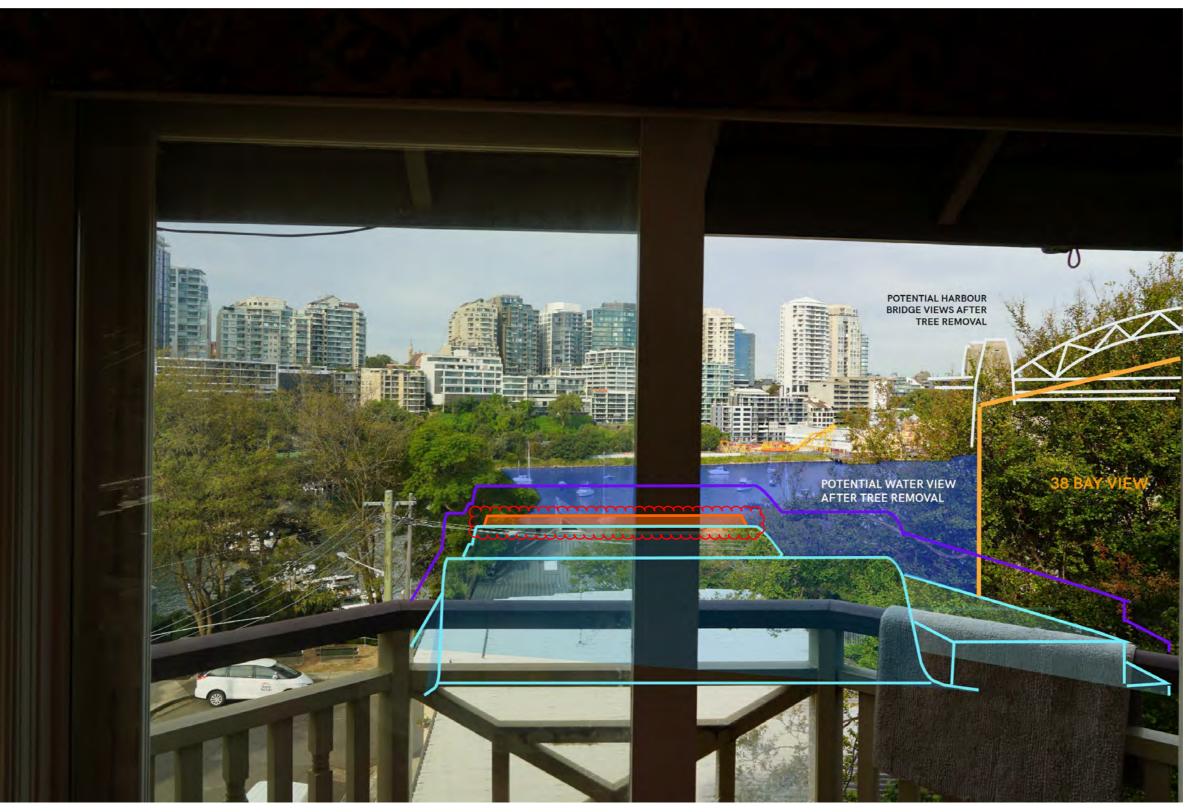

### LEGEND

<u>[]]</u>	PROPOSED BUILDING - (LATEST ROOF AMMENDMENT)
	PROPOSED BUILDING (AS ORIGINALLY SUBMITTED)
	PROPOSED BUILDING (AMENDED, LOWERED HEIGHT)
	HARBOUR BRIDGE
	NEIGHBOUR 38 BAY VIEW
	POTENTIAL WATER VIEWS (AFTER TREE REMOVAL)

PRELIMINARY


# 21 KING GEORGE ST, PROPOSED BUILDING OUTLINE OVERLAID ONTO IMAGE PROVIDED BY RICHARD LAMB - RLA09255

Date 11.11.2021	F	Issue View Analysis			1	CLIENT MB			1	PROJE
21.02.2022	G	View Analysis			1 1 1				54.	
computer system	of the Arc	hitect to systems of the Client or other Consultants. The recipie	t of any errors existing or resulting from data howsoever transferred from the ent of the data shall be responsible for checking accuracy and completeness The CAD files and their contents are solely representations of the project	NSW Nominated Architects: S. ISAACS #7929 ABN: 79 124 014 759	1	ARCHITECTURE SAVILLE ISAACS PTY LTD	l l	ľ		PROJE

Page 111

JECT King Ge	orge St		птье 19 King George - RLA09255			
			јов №. 2024	drawing №. 17	<sup>REV.</sup>	
JECT DATE	ISSUED DATE 11.11.2021	SCALE @ A3: 1 : 100	STATUS VIEW ANAL	YSIS		

100r

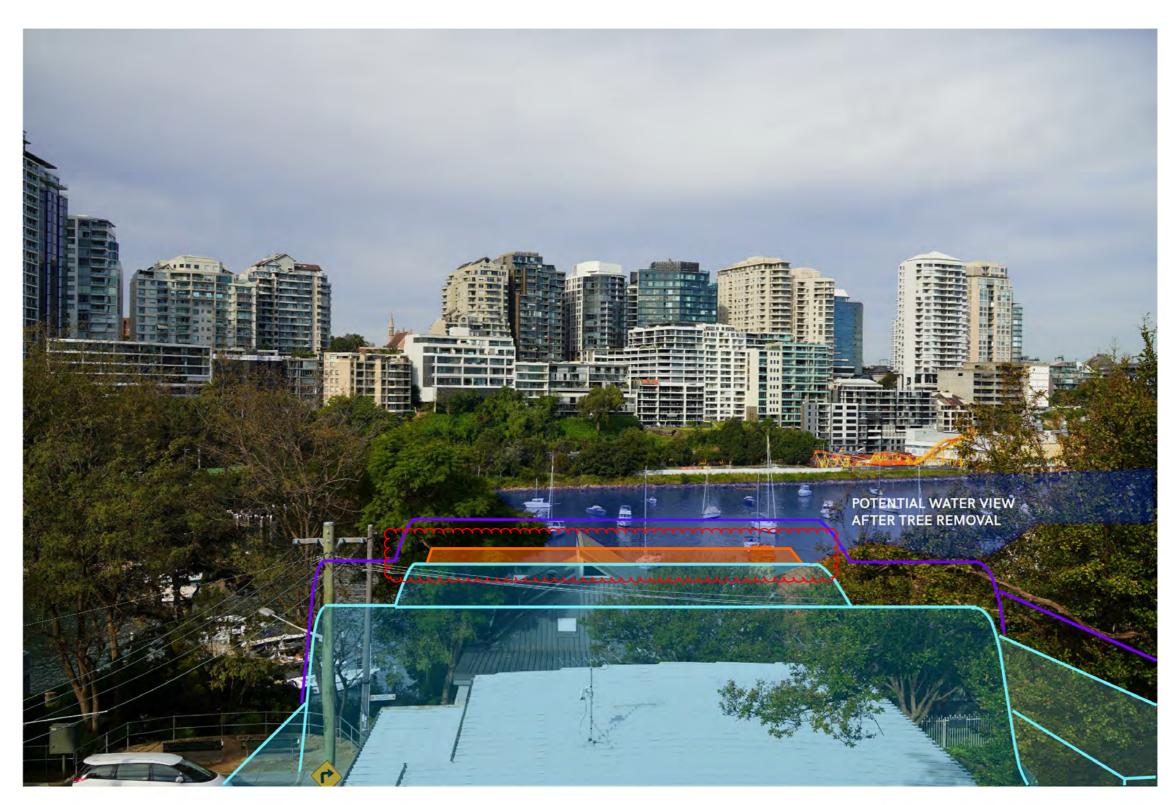

LEGEND

200

LEGEND	
	$\cdots \cdots $
	PROPOSED BUILDING - (LATEST ROOF AMMENDMENT)
him	PROPOSED BUILDING (AS ORIGINALLY SUBMITTED)
	PROPOSED BUILDING (AMENDED, LOWERED HEIGHT)
	HARBOUR BRIDGE
	NEIGHBOUR 38 BAY VIEW
	POTENTIAL WATER VIEWS (AFTER TREE REMOVAL)

PRELIMINARY

# 21 KING GEORGE ST, PROPOSED BUILDING OUTLINE OVERLAID ONTO IMAGE PROVIDED BY RICHARD LAMB - RLA09256

Date 11.11.2021 21.02.2022	F	Issue View Analysis View Analysis			client MB	1	[	<sub>РКО</sub> 21
computer system	of the Arc	hitect to systems of the Client or other Consultants. The recipier	of any errors existing or resulting from data howsoever transferred from the to f the data shall be responsible for checking accuracy and completeness he CAD files and their contents are solely representations of the project	NSW Nominated Architects: S. ISAACS #7929 ABN: 79 124 014 759	1		saa-	PRO

Page 112


JECT King Geo	orge St		тіт∟е 19 King G ЈОВ №. 2024	eorge - RLA09256 drawing no. 18	) REV. F
JECT DATE	ISSUED DATE 11.11.2021	SCALE @ A3: 1 : 100	STATUS VIEW ANAL	YSIS	

100r



2001

LEGEND

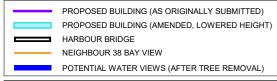

PRELIMINARY

# 21 KING GEORGE ST, PROPOSED BUILDING OUTLINE OVERLAID ONTO IMAGE PROVIDED BY RICHARD LAMB - RLA09258

1 1		Issue	1 1		1	CLIENT	1		1	PROJ
11.11.2021	F	View Analysis				MB				21 k
computer system o	of the Arcl	hitect to systems of the Client or other Consultants. The recipient	f any errors existing or resulting from data howsoever transferred from the of the data shall be responsible for checking accuracy and completeness e CAD files and their contents are solely representations of the project	NSW Nominated Architects: S. ISAACS #7929 ABN: 79 124 014 759		ARCHITECTURE SAVILLE ISAACS PTY LTD		e	29.4 ~~~~~~~~~~~~~~~~~~~~~~~~~~~~~~~~~~~~	PROJ

Page 113

JECT King Geo	orge St		<sup>ТІТLE</sup> 19 King G ЈОВ №. 2024	George - RLA09258 DRAWING No. 19	B REV. F
JECT DATE	ISSUED DATE 11.11.2021	SCALE @ A3: 1 : 100	STATUS VIEW ANAL	YSIS	